


#03-01413

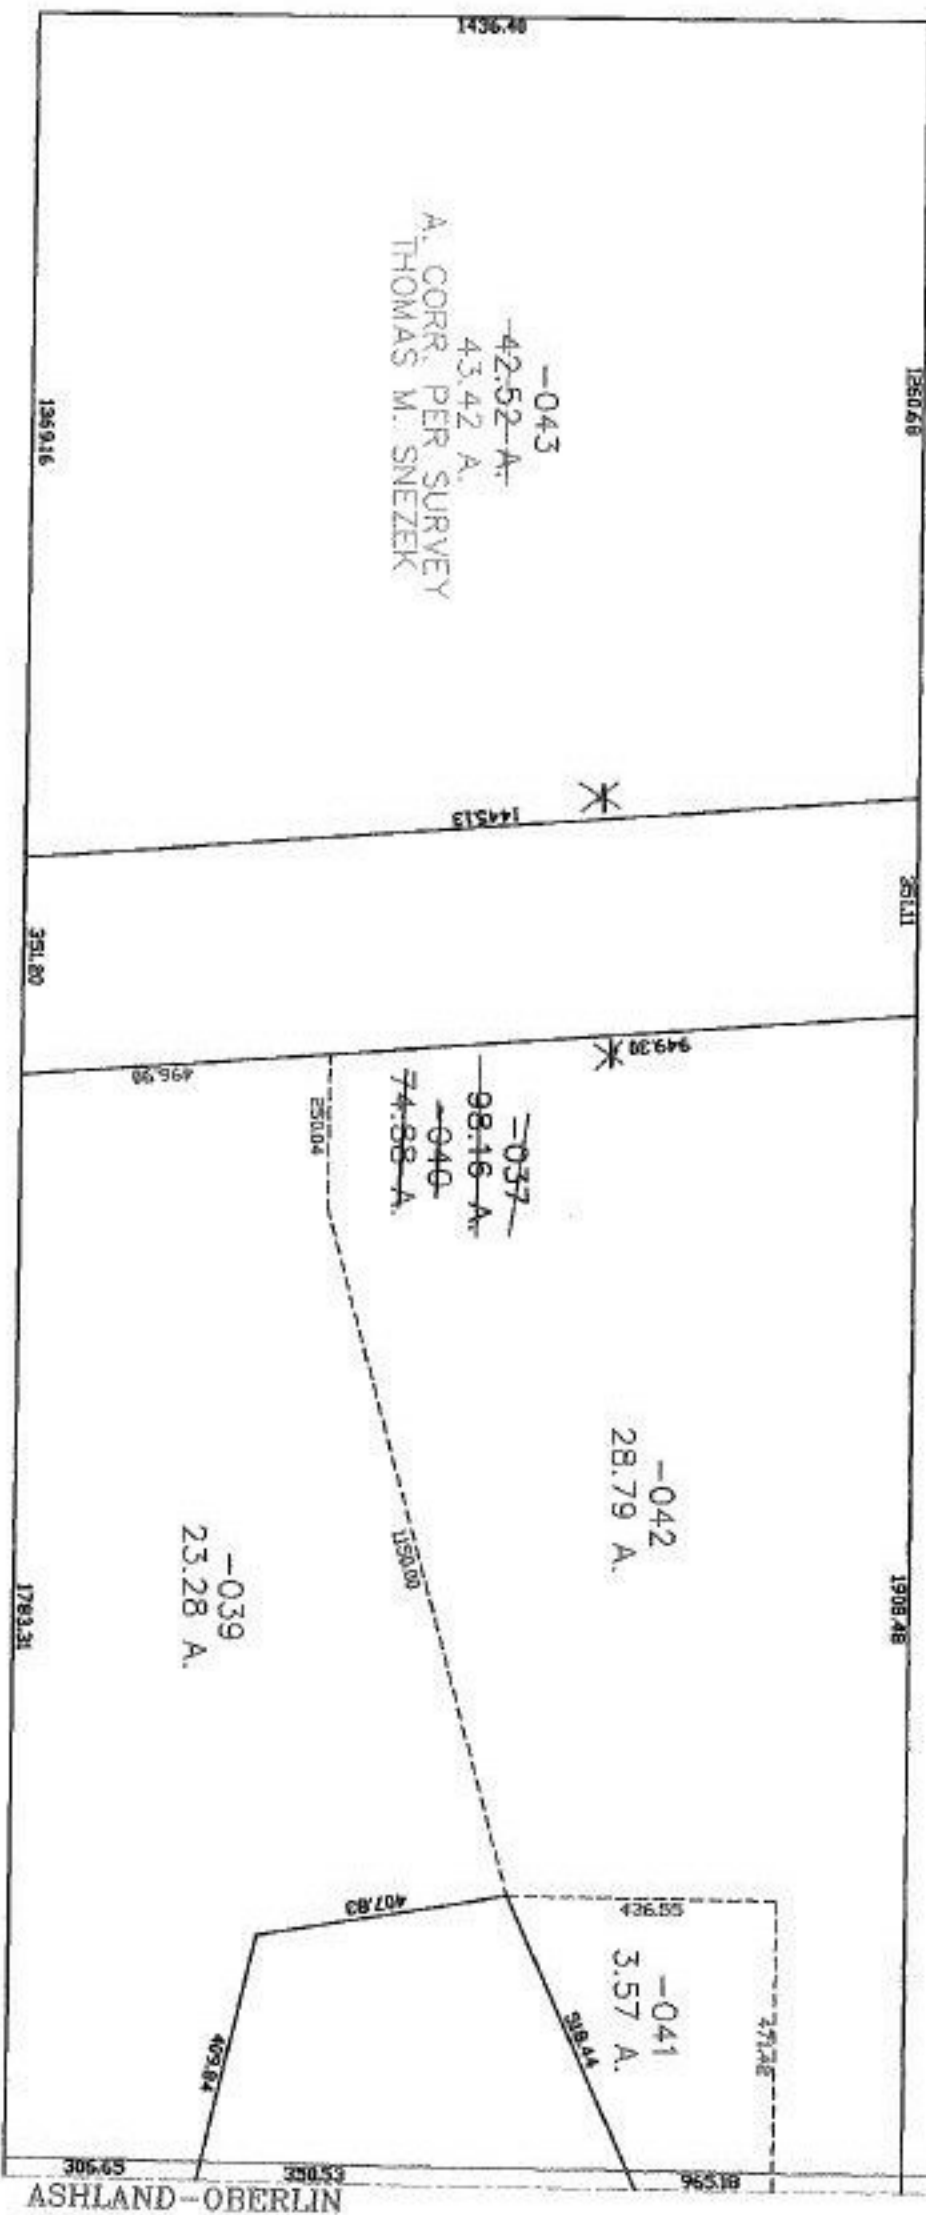

WEBSTER

704 on