


# 03 0413

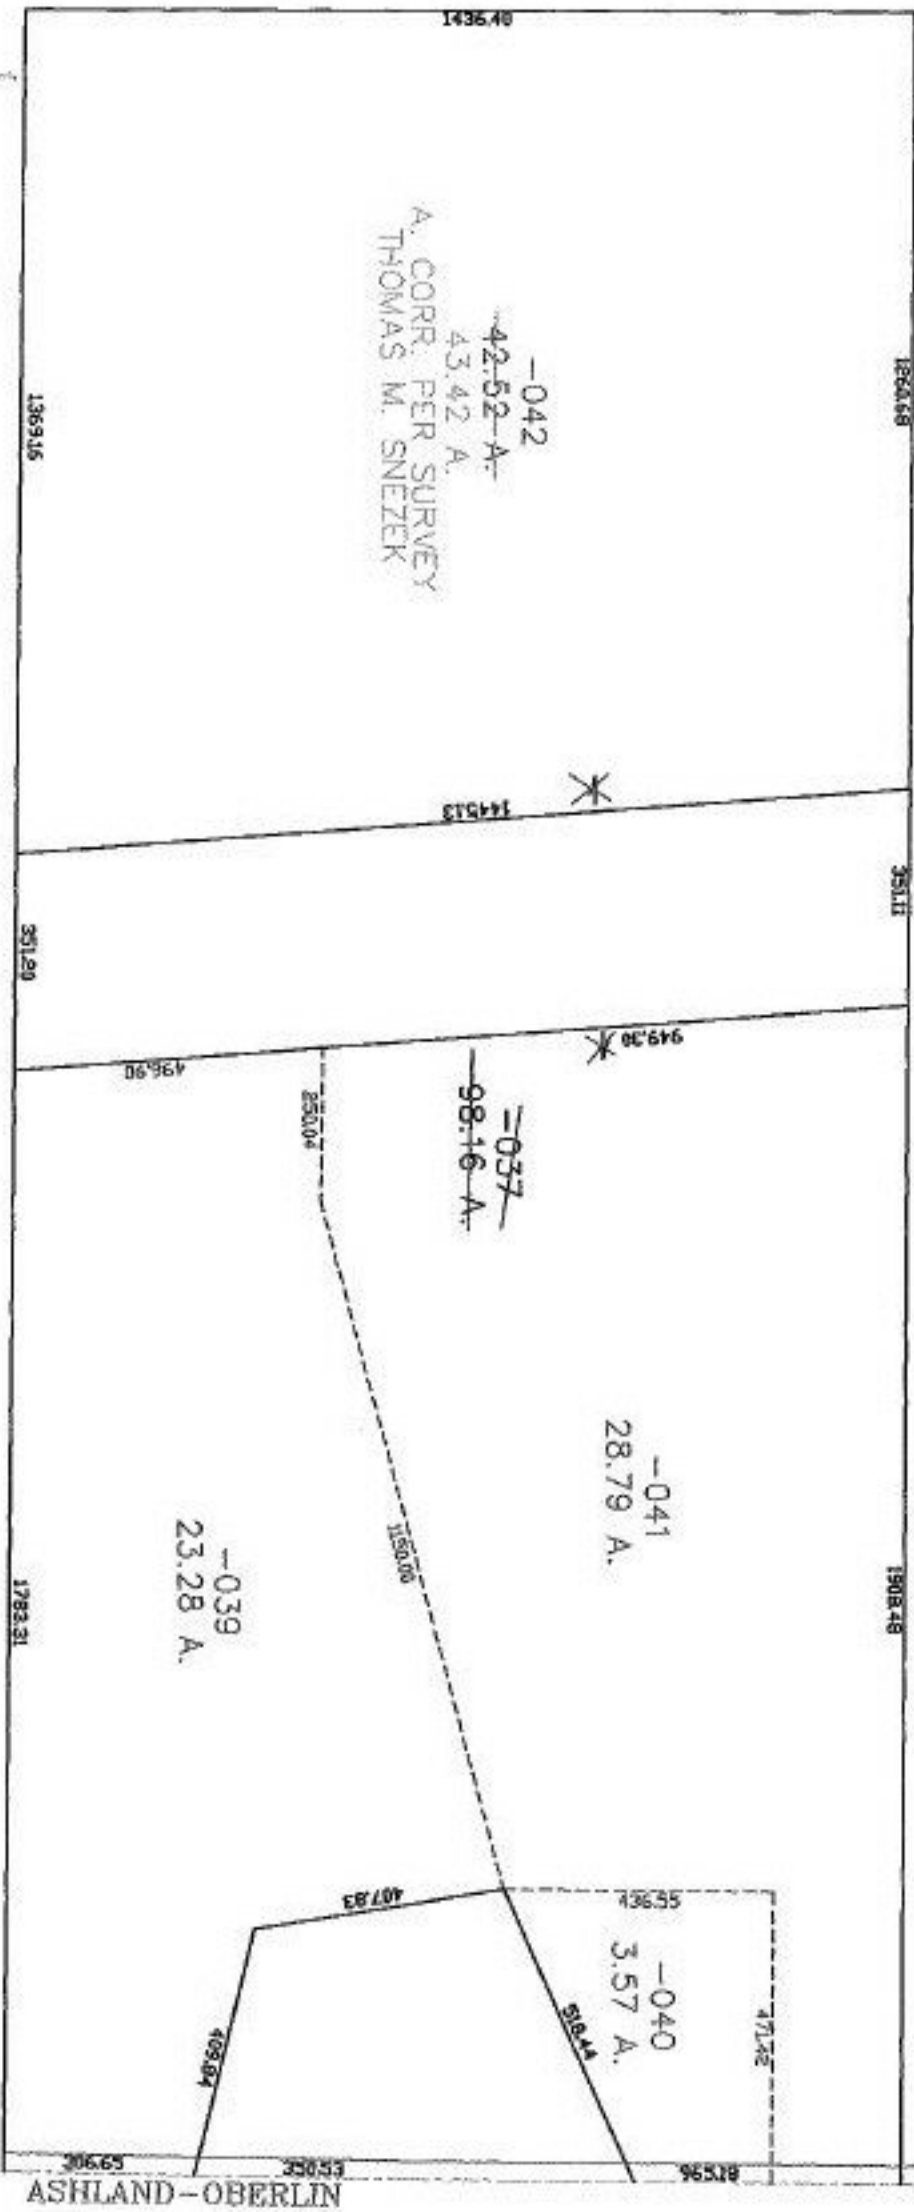

S WEBSTER