


PARENT PARCEL: 01-00-066-000-019

CHILD PARCEL: 01-00-066-000-025, -026

STARTING POINT: CENTERLINE OF GORE ORPHANAGE RD. & O.L. 66

NO. 01419

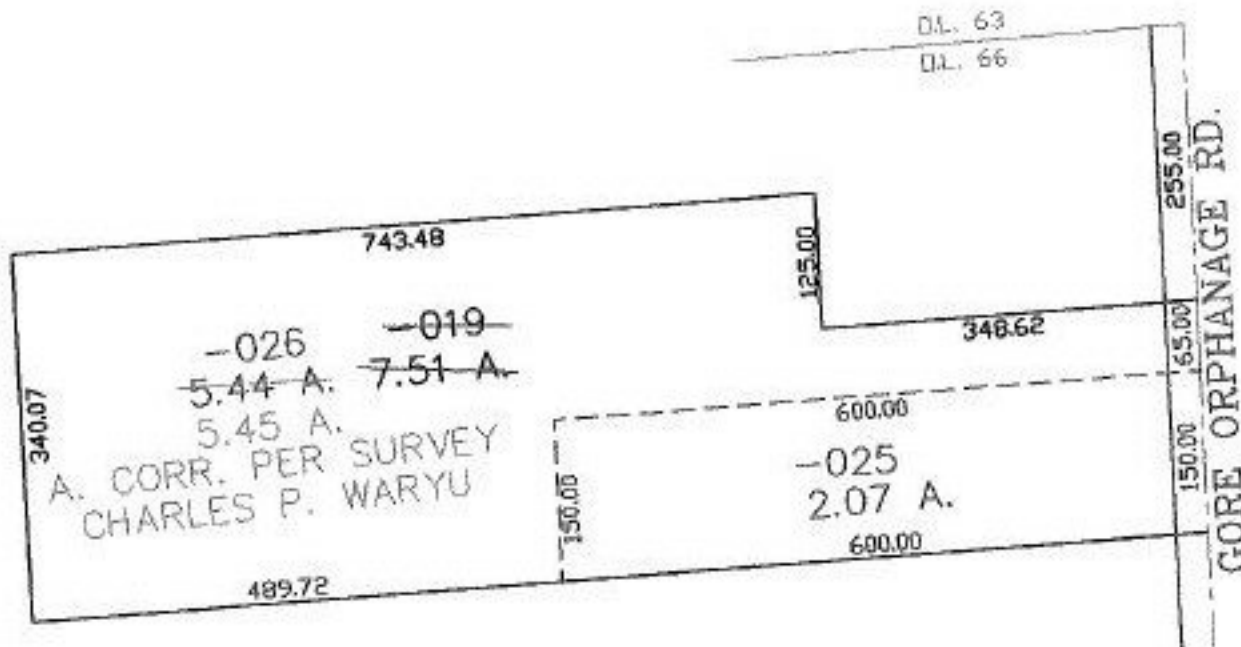

**SPLITS/DEEDS PROCESSED**  
**LORAIN COUNTY TAX MAP DEPARTMENT**  
 226 MIDDLE AVE. ELYRIA, OHIO

SURVEYED BY: CHARLES P. WARYU  
 CLOSURE: 0.00 ; 10,000  
 MAP PAGE(S): 01-00-066-A  
 APPROVED BY: JAH DATE: 7-24-03  
 SCALE: 1" = 200' PRIOR INSTRUMENT: 20000671087