

PARENT PARCEL: 04-00-017-102-042

CHILD PARCEL: 04-00-017-102-204, -205

STARTING POINT: INT CL AVON BELDEN AND WEBBER RD


NO. 01421



WEBBER RD 60'

AVON BELDEN RD 60'

AC. CORR.
PER SURVEY
JAMES T. SAYLER

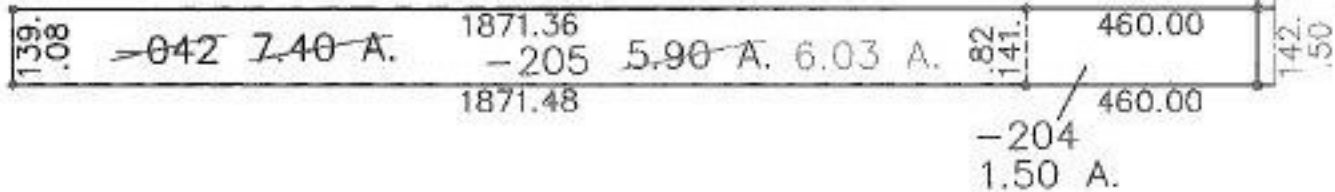

SPLITS/DEEDS PROCESSED
LORAIN COUNTY TAX MAP DEPARTMENT
226 MIDDLE AVE. ELYRIA, OHIO

SURVEYED BY: JAMES T. JAYLER
CLOSURE: 0:00 PER 10,000
MAP PAGE(S): 4-00-017-B
APPROVED BY: DRH DATE: 7/25/2003
SCALE: 1" = 400' PRIOR INSTRUMENT: DV 1285/240