


PARENT PARCEL: 01-00-063-000-038

CHILD PARCEL: 01-00-063-000-046, -047

STARTING POINT: SOUTHEAST CORNER OF O.L. 63

NO. 01422

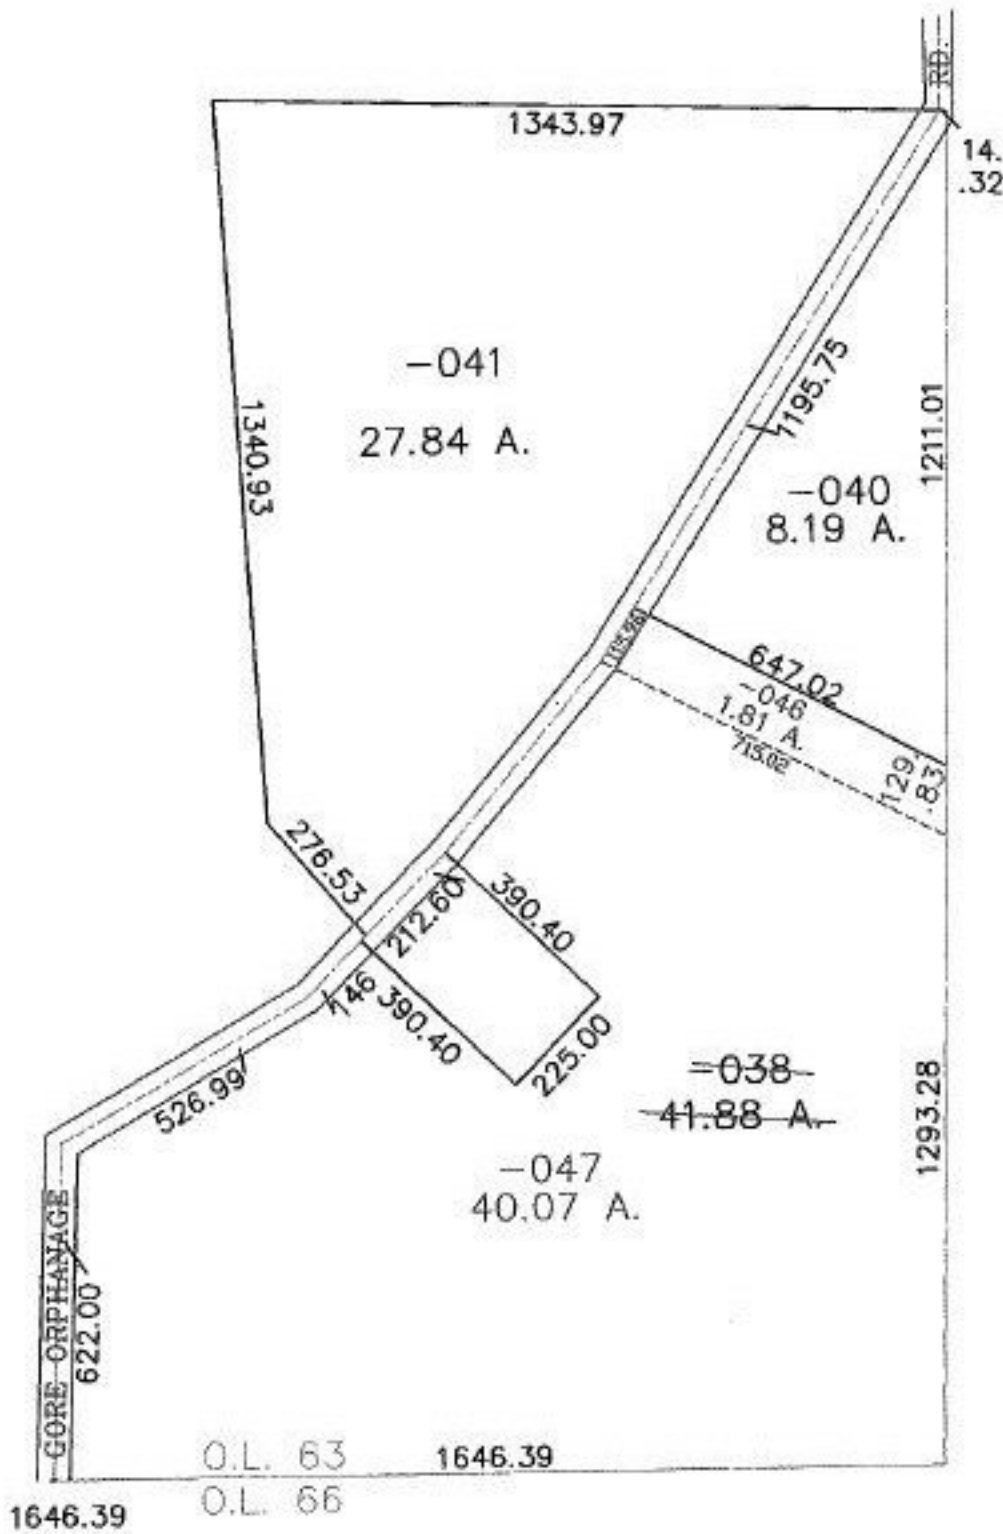

SPLITS/DEEDS PROCESSED
LORAIN COUNTY TAX MAP DEPARTMENT
 226 MIDDLE AVE. ELYRIA, OHIO

SURVEYED BY: ALEX KELSER
 CLOSURE: 0.00 : 10.000
 MAP PAGE(S): 1-1
 APPROVED BY: JAH DATE: 4-25-03
 SCALE: 1" = 400' PRIOR INSTRUMENT: 20020816318