


PARENT PARCEL: 04-00-002-101-077
CHILD PARCEL: 04-00-002-101-080 THRU -082
STARTING POINT: CENTERLINE OF DETROIT RD. & MOON RD.

NO. 01428

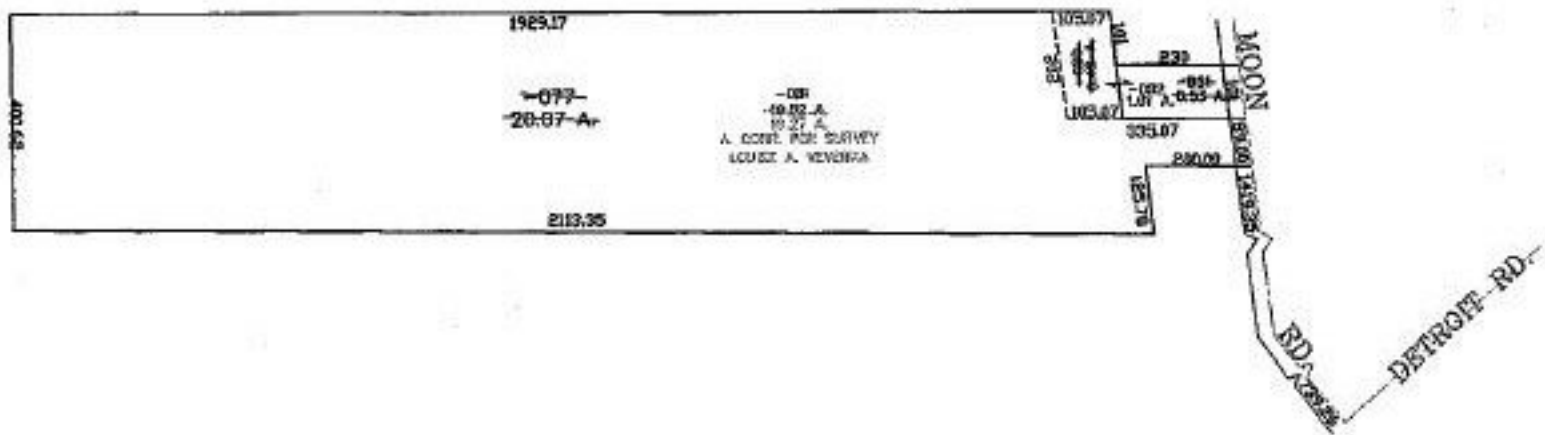

SPLITS/DEEDS PROCESSED
LORAIN COUNTY TAX MAP DEPARTMENT
226 MIDDLE AVE. ELYRIA, OHIO

SURVEYED BY: LOUISE A. VEVERKA
CLOSURE: 0.00 : 10.000
MAP PAGE(S): 04-00-002-F
APPROVED BY: JAH DATE: 7-31-03
SCALE: 1" = 400 PRIOR INSTRUMENT: 19980523782