
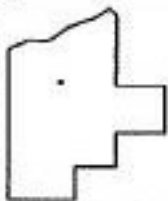


PARENT PARCEL: 05-00-046-000-022

CHILD PARCEL: 05-00-046-000-026, -027

STARTING POINT: INTERSECTION OF O.L. 46, O.L. 47, O.L. 55 & O.L. 54

NO. 01429

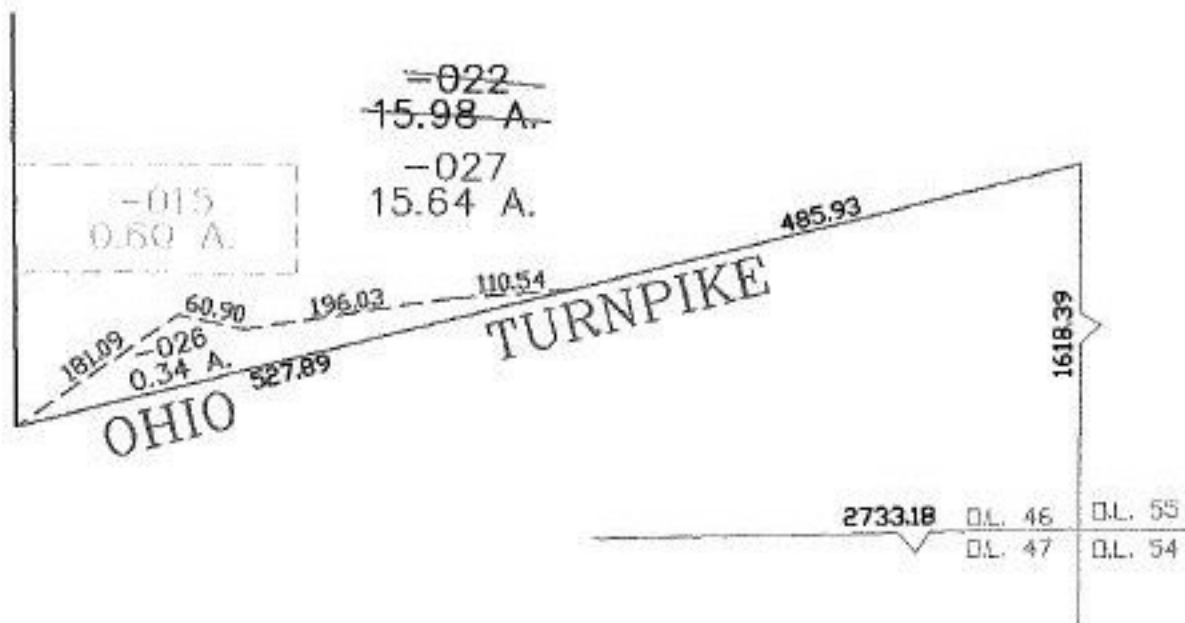

SPLITS/DEEDS PROCESSED
 LORAIN COUNTY TAX MAP DEPARTMENT
 226 MIDDLE AVE. ELYRIA, OHIO

SURVEYED BY: JOSEPH WILIN
 CLOSURE: 0.00 ; 10.000
 MAP PAGE(S): 5-G
 APPROVED BY: JAH DATE: 7-24-03
 SCALE: 1" = 200' PRIOR INSTRUMENT: OR 1121/684