

PARENT PARCEL: 05-00-055-000-025


CHILD PARCEL: 05-00-055-000-038, -039

STARTING POINT: INTERSECTION OF O.L. 55 & O.L. 56

NO. 01430



OHIO TURNPIKE

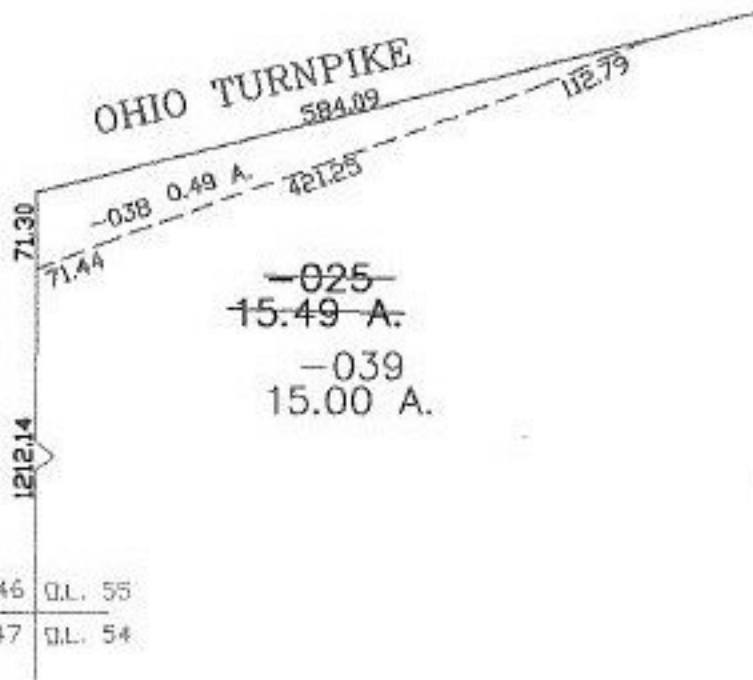


-025
15.49 A.

-039
15.00 A.

2733.18

O.L. 46 O.L. 55
O.L. 47 O.L. 54

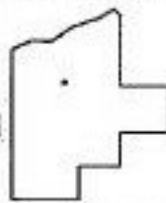

SPLITS/DEEDS PROCESSED
LORAIN COUNTY TAX MAP DEPARTMENT
226 MIDDLE AVE. ELYRIA, OHIO

SURVEYED BY: JOSEPH WILIN
CLOSURE: 0.00 : 10.000
MAP PAGE(S): 5-G
APPROVED BY: JAH DATE: 7-25-03
SCALE: 1" = 200 PRIOR INSTRUMENT: 970501706