


PARENT PARCEL: 09-00-015-000-038, -005-, -040

CHILD PARCEL: 09-00-015-000-043 THRU -045

STARTING POINT: CENTERLINE OF RUSSIA RD. & LEAVITT RD.

NO. 01432

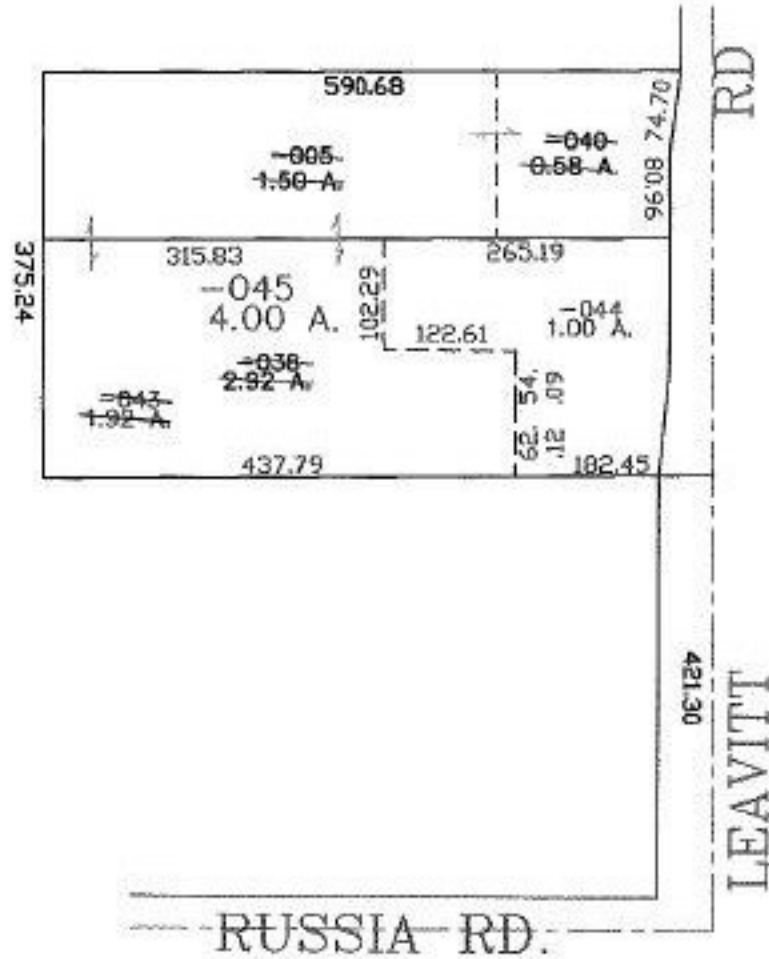

**SPLITS/DEEDS PROCESSED**

LORAIN COUNTY TAX MAP DEPARTMENT  
226 MIDDLE AVE. ELYRIA, OHIO

SURVEYED BY: ALEX KELSER

CLOSURE: 0.00 : 10.000

MAP PAGE(S): 9-B

APPROVED BY: JAH DATE: 8-1-03

SCALE: 1" = 200' PRIOR INSTRUMENT: OR 1050/234