


PARENT PARCEL: 11-00-002-000-018

CHILD PARCEL: 11-00-002-000-037, -038

STARTING POINT: CENTERLINE OF COWLEY RD. & O.L. 1

NO. 01441

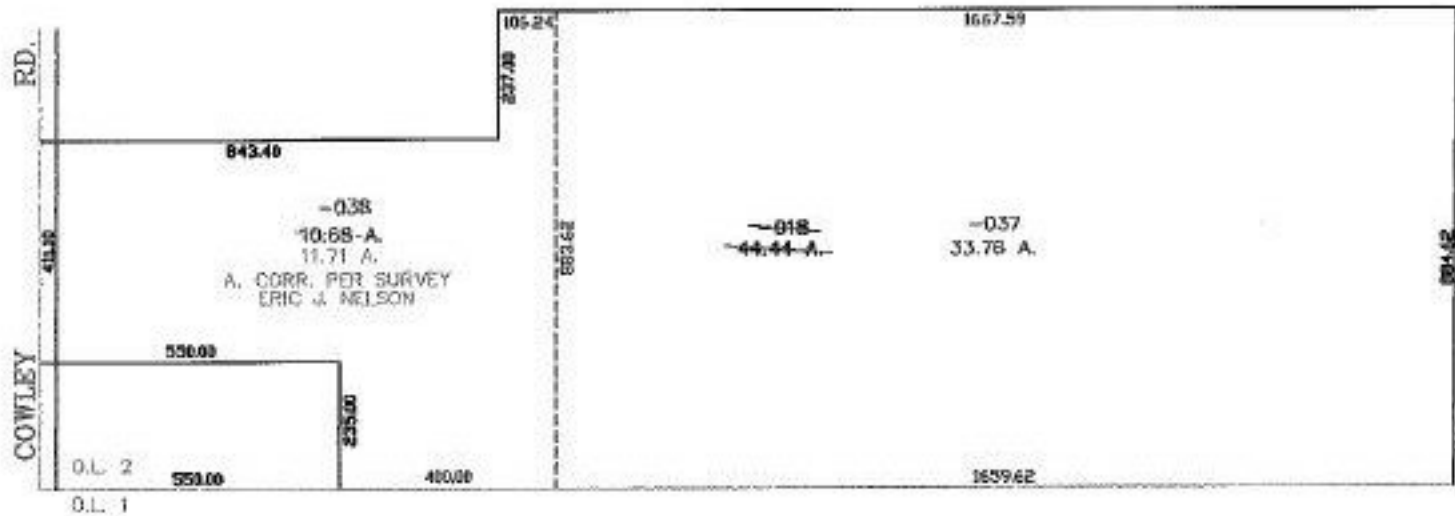

SPLITS/DEEDS PROCESSED
LORAIN COUNTY TAX MAP DEPARTMENT
 226 MIDDLE AVE. ELYRIA, OHIO

SURVEYED BY: ERIC J. NELSON
 CLOSURE: 0.00 : 10.000
 MAP PAGE(S): 11-00-002-A, B
 APPROVED BY: JAH DATE: 8-28-03
 SCALE: 1" = 400 PRIOR INSTRUMENT: DV 872/463