


PARENT PARCEL: 10-00-010-000-076

CHILD PARCEL: 10-00-010-000-092, -093

STARTING POINT: CENTERLINE OF WEST RIDGE RD. & BUTTERNUT RIDGE RD.

NO. 01442

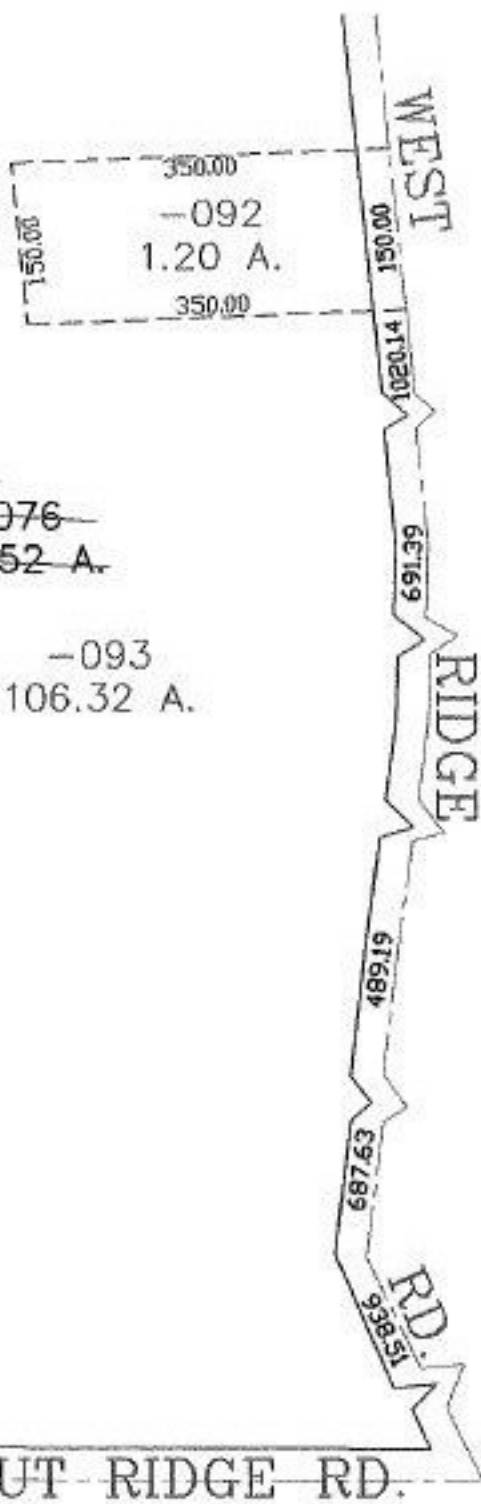

~~-076~~
~~107.52 A.~~

-093
106.32 A.

BUTTERNUT RIDGE RD.



SPLITS/DEEDS PROCESSED
LORAIN COUNTY TAX MAP DEPARTMENT
226 MIDDLE AVE. ELYRIA, OHIO

SURVEYED BY: THOMAS A. SIMON
CLOSURE: 0.00 : 10.000
MAP PAGE(S): 10-00-010-A
APPROVED BY: JAH DATE: 8-26-03
SCALE: 1" = 200' PRIOR INSTRUMENT: 20030881447