
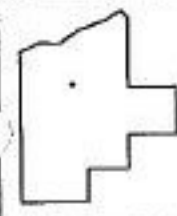


RASTER

PARENT PARCEL: 07-00-008-116-009, -010  
CHILD PARCEL: 07-00-008-116-017 THRU -020  
STARTING POINT: CENTERLINE OF CENTER RIDGE RD. & LEAR NAGLE RD.

NO. 01443

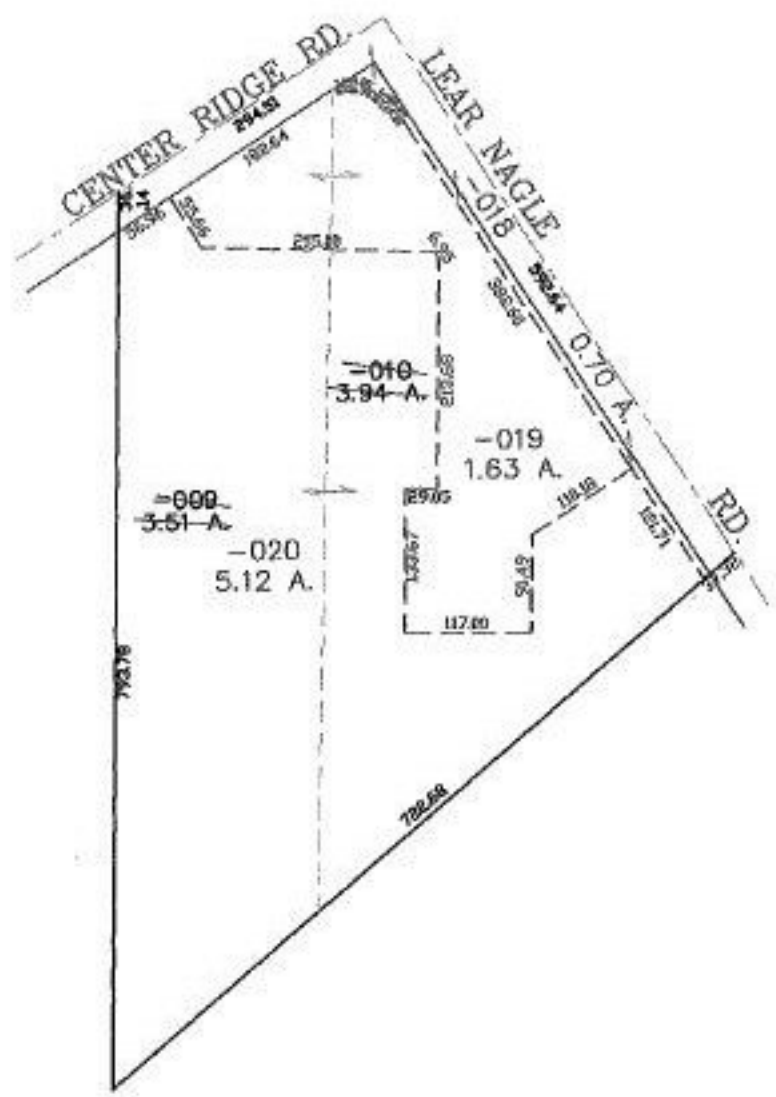

**SPLITS/DEEDS PROCESSED**  
LORAIN COUNTY TAX MAP DEPARTMENT  
226 MIDDLE AVE. ELYRIA, OHIO

SURVEYED BY: MARK ALLEN YEAGER  
CLOSURE: 0.00 ; 10.000  
MAP PAGE(S): 07-00-008-C  
APPROVED BY: JAH DATE: 9-4-03  
SCALE: 1" = 200' PRIOR INSTRUMENT: 20020801883