


RASTER

PARENT PARCEL: 05-00-003-105-040

CHILD PARCEL: 05-00-003-105-073, -074

STARTING POINT: CORNER OF S/L 13 OF APPLE ORCHARD SUBD. NO. 1

NO. 01444

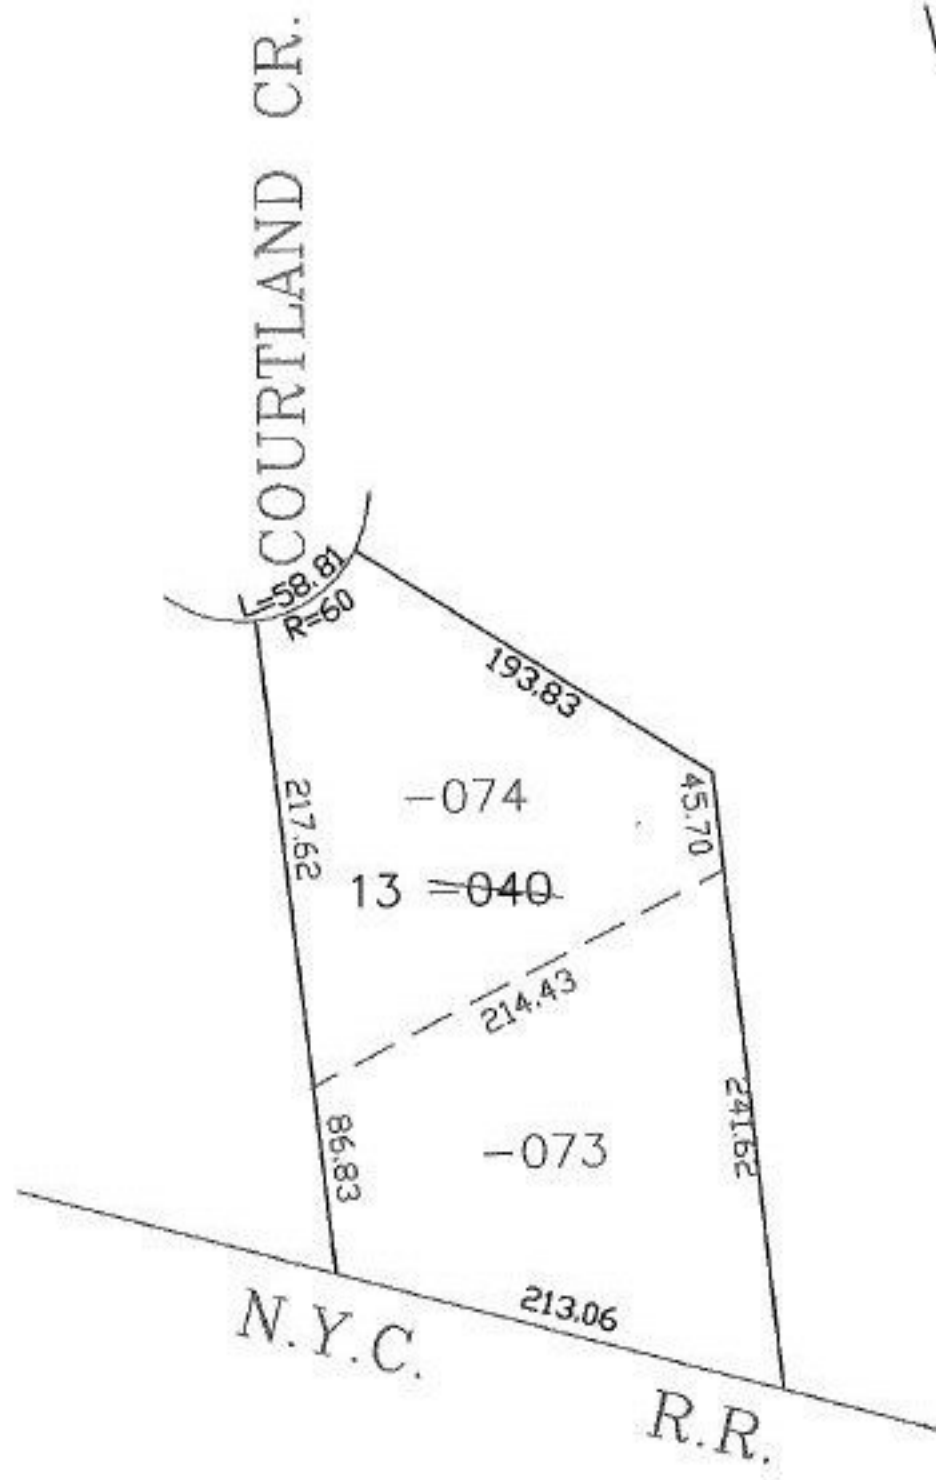

SPLITS/DEEDS PROCESSED
 LORAIN COUNTY TAX MAP DEPARTMENT
 226 MIDDLE AVE. ELYRIA, OHIO

SURVEYED BY: PHILIP A. ROSEBECK
 CLOSURE: 0.00 : 10.000
 MAP PAGE(S): 05-00-003-A
 APPROVED BY: JAH DATE: 8-28-03
 SCALE: 1" = 100 PRIOR INSTRUMENT: 20010760613