
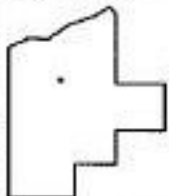


PARENT PARCEL: 20-06-025-000-005

CHILD PARCEL: 20-06-025-000-009, -010

STARTING POINT: CENTERLINE OF ANDERSON RD. & O.L. 25

NO. 01446

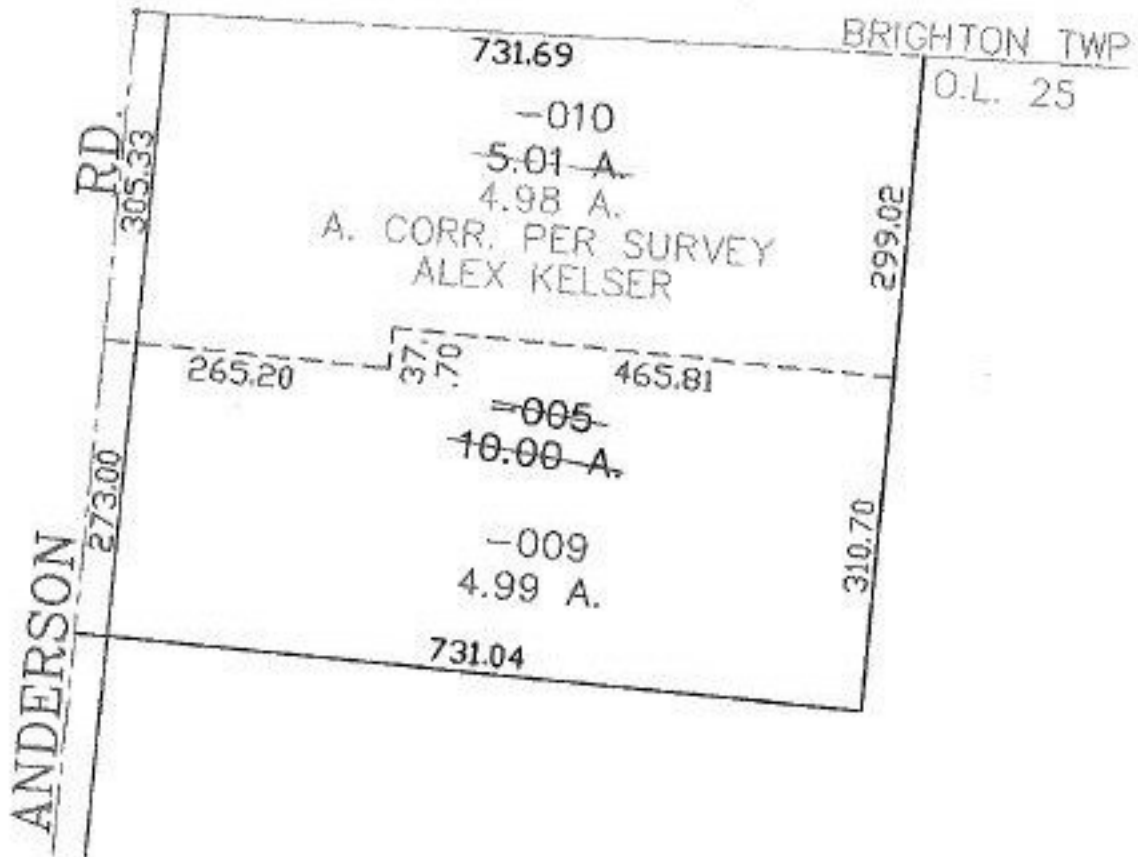

SPLITS/DEEDS PROCESSED
 LORAIN COUNTY TAX MAP DEPARTMENT
 226 MIDDLE AVE. ELYRIA, OHIO

SURVEYED BY: ALEX KELSER
 CLOSURE: 0.00 : 10.000
 MAP PAGE(S): 20-D
 APPROVED BY: JAH DATE: 9-2-03
 SCALE: 1" = 200' PRIOR INSTRUMENT: 20020827757