
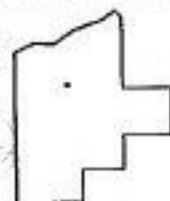


PARENT PARCEL: 02-02-002-000-162

CHILD PARCEL: 02-02-002-000-163, -164

STARTING POINT: S/L 80 IN BEAVER CREEK ESTATES SUBD. NO. 4

NO. 01454

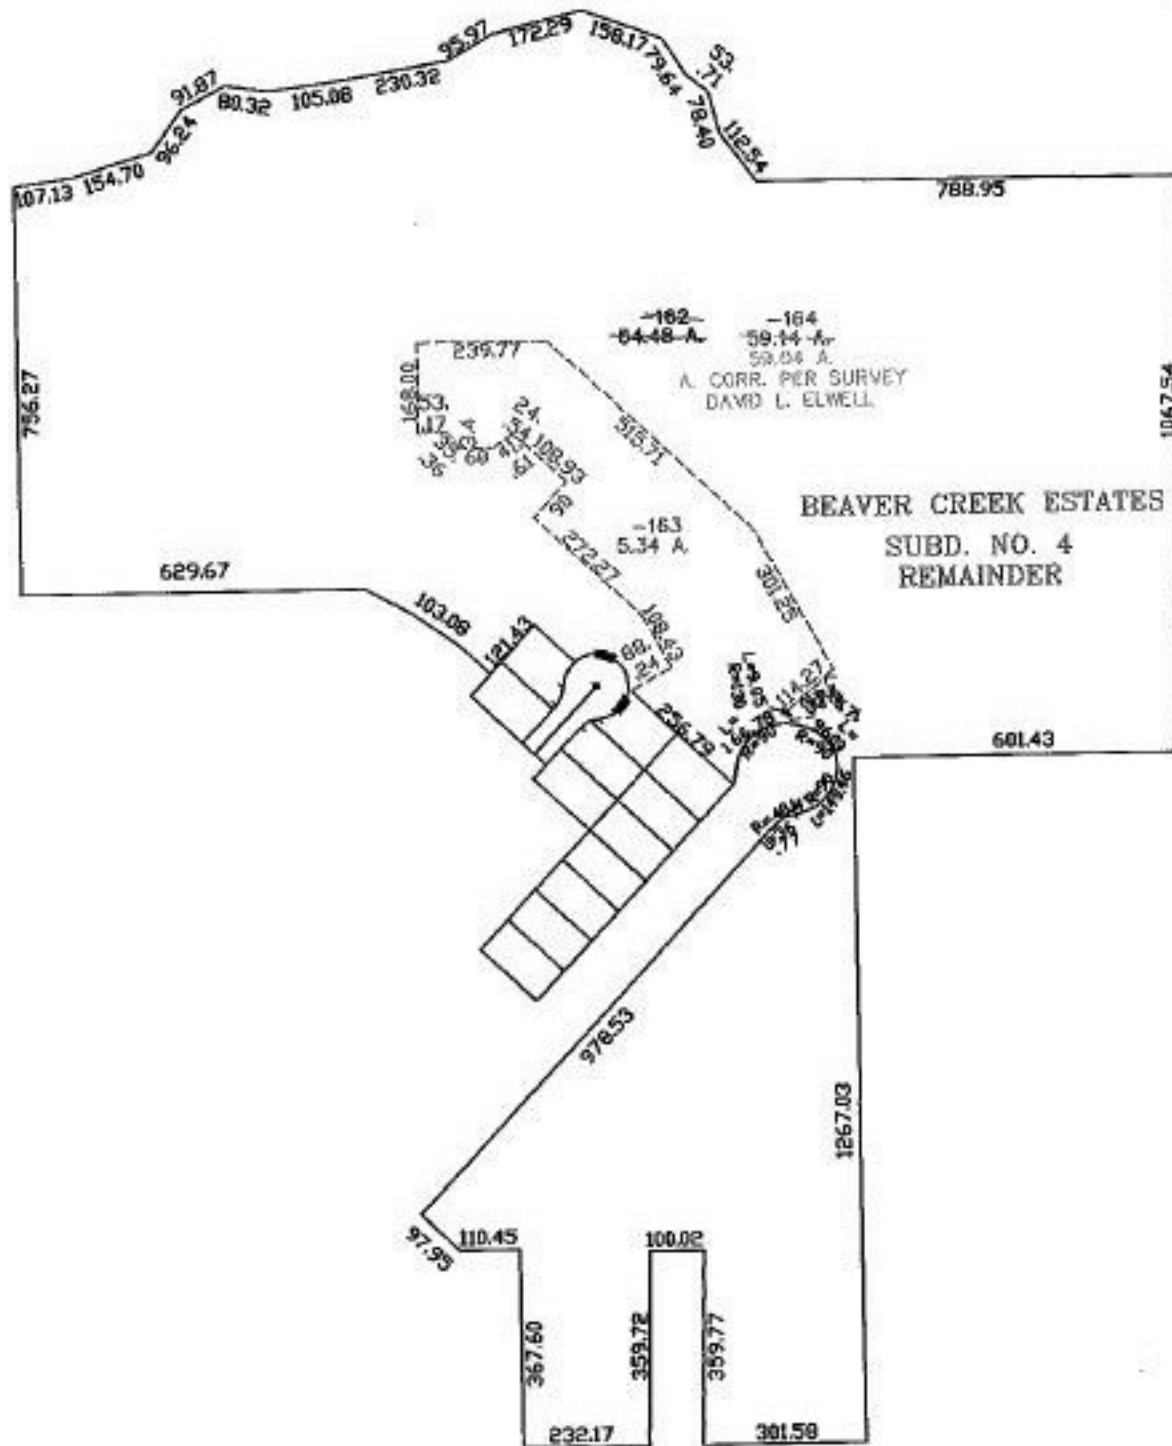

SPLITS/DEEDS PROCESSED
LORAIN COUNTY TAX MAP DEPARTMENT
226 MIDDLE AVE. ELYRIA, OHIO

SURVEYED BY: DAVID L. ELWELL
CLOSURE: 0.00 : 10.000
MAP PAGE(S): 02-02-002--A
APPROVED BY: JAH DATE: 9-9-03
SCALE: 1" = 400' PRIOR INSTRUMENT: PL. V. 69/3 & 4