

PARENT PARCEL: 12-00-055-101-002


CHILD PARCEL: 12-00-055-101-069, -070

STARTING POINT: CENTERLINE OF ELYRIA-TWINSBURG RD. & O.L. 55

NO. 01460



ELYRIA-TWINSBURG RD.

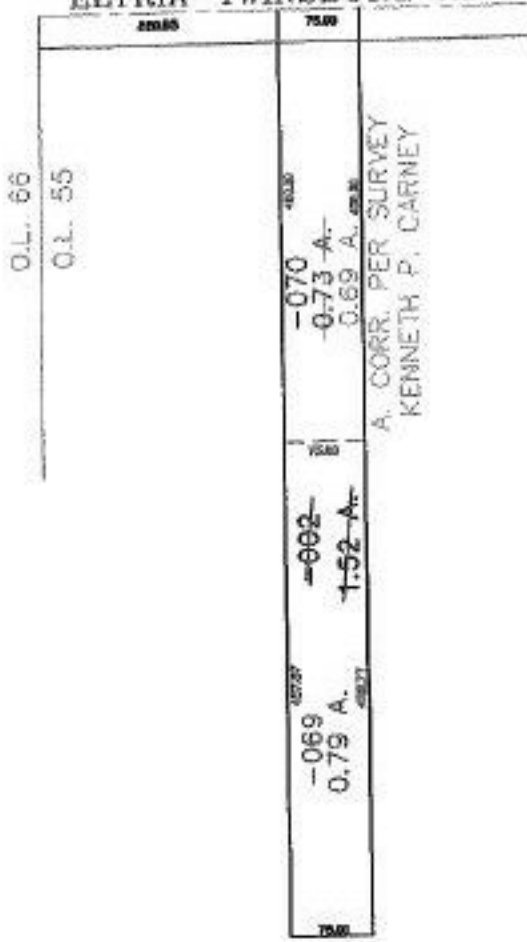

SPLITS/DEEDS PROCESSED
 LORAIN COUNTY TAX MAP DEPARTMENT
 226 MIDDLE AVE. ELYRIA, OHIO

SURVEYED BY: KENNETH P. CARNEY
 CLOSURE: 0.00 ; 10.000
 MAP PAGE(S): 12-00-055-A
 APPROVED BY: JAH DATE: 9-12-03
 SCALE: 1" = 200 PRIOR INSTRUMENT: OR 892/463