


PARENT PARCEL: 08-12-013-000-005

CHILD PARCEL: 08-12-013-000-019 THRU -022

STARTING POINT: CENTERLINE OF GORE ORPHANAGE RD. & BATES RD.

NO. 01461

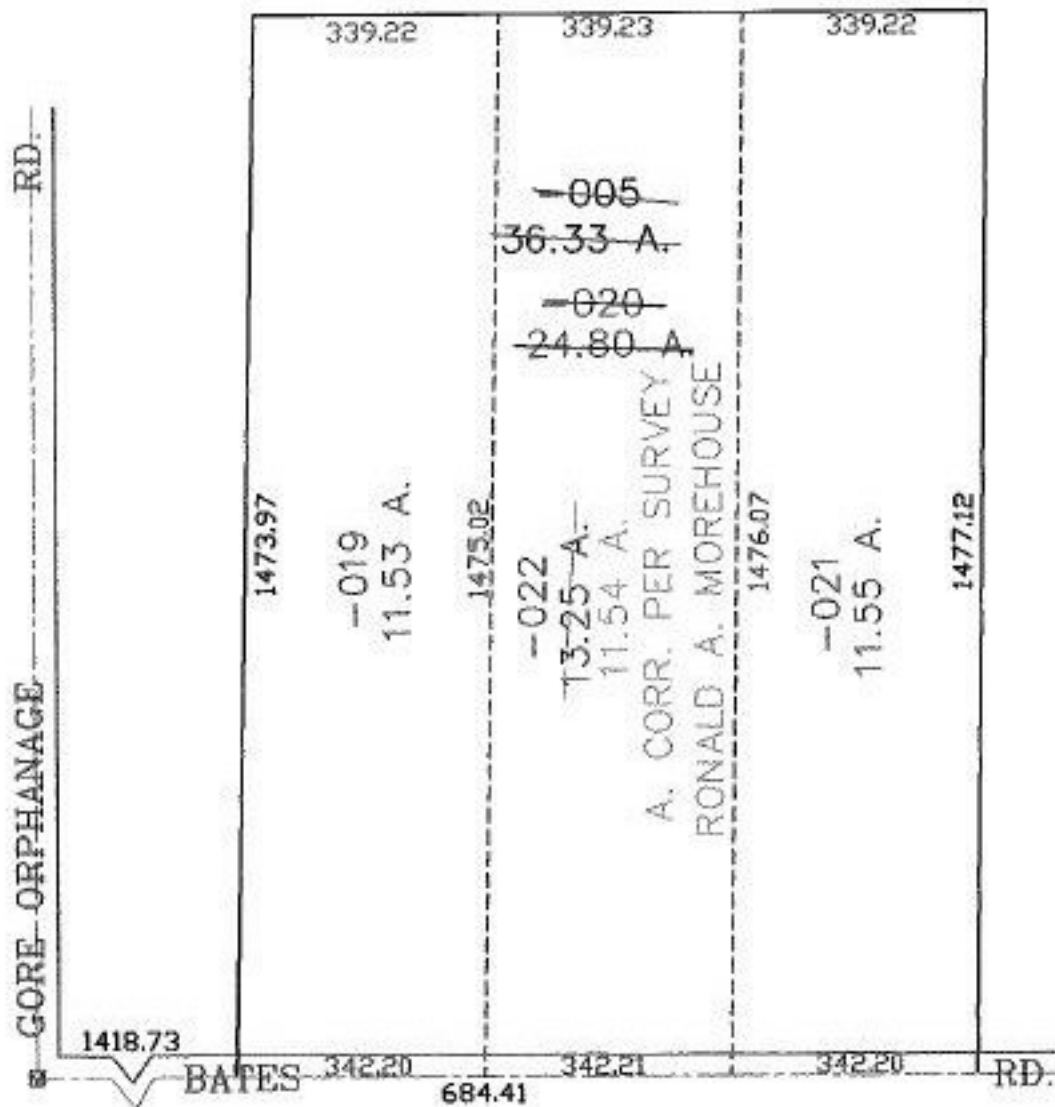

SPLITS/DEEDS PROCESSED
 LORAIN COUNTY TAX MAP DEPARTMENT
 226 MIDDLE AVE. ELYRIA, OHIO

SURVEYED BY: RONALD A. MOREHOUSE
 CLOSURE: 0.00 : 10.000
 MAP PAGE(S): 8-E
 APPROVED BY: JAH DATE: 9-15-03
 SCALE: 1" = 300' PRIOR INSTRUMENT: 20030946154