


PARENT PARCEL: 01-00-056-000-068, -055  
CHILD PARCEL: 01-00-056-000-075 THRU -077  
STARTING POINT: CENTERLINE OF RICE RD. & O.L. 56

NO. 01464

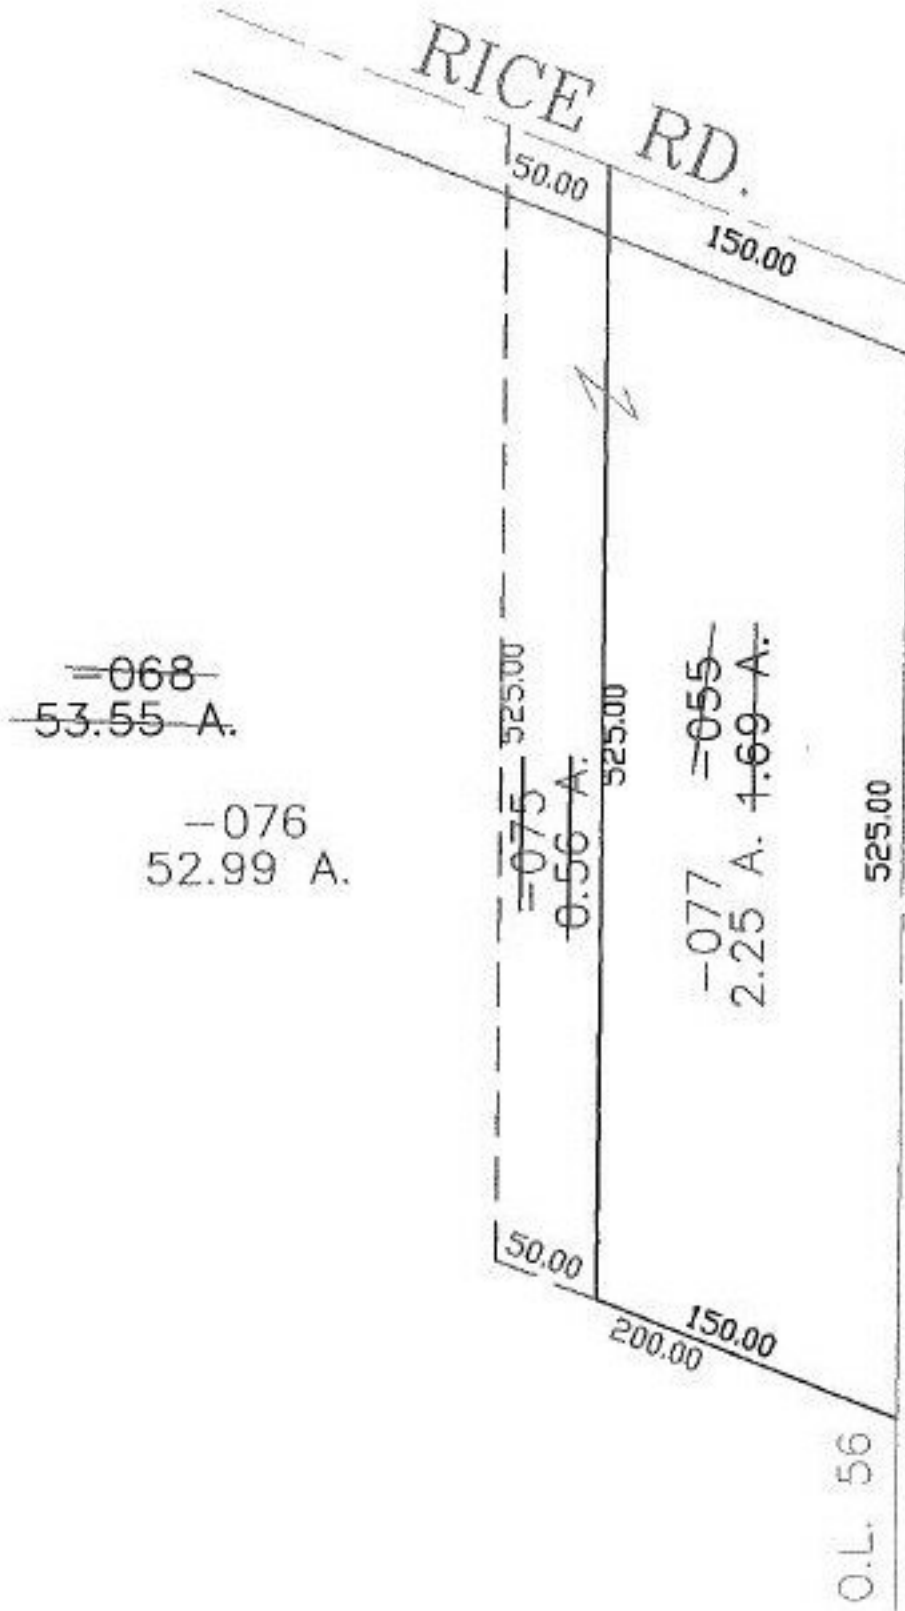

**SPLITS/DEEDS PROCESSED**  
LORAIN COUNTY TAX MAP DEPARTMENT  
226 MIDDLE AVE. ELYRIA, OHIO

SURVEYED BY: THOMAS A. SIMON  
CLOSURE: 0.00 : 10.000  
MAP PAGE(S): 1-1  
APPROVED BY: JAH DATE: 9-17-03  
SCALE: 1" = 100' PRIOR INSTRUMENT: 2000068247B