


PARENT PARCEL: 15-00-006-000-040, -041

CHILD PARCEL: 15-00-006-000-044 THRU -047

STARTING POINT: CENTERLINE OF LAGRANGE RD. & O.L. 6

NO. 01465

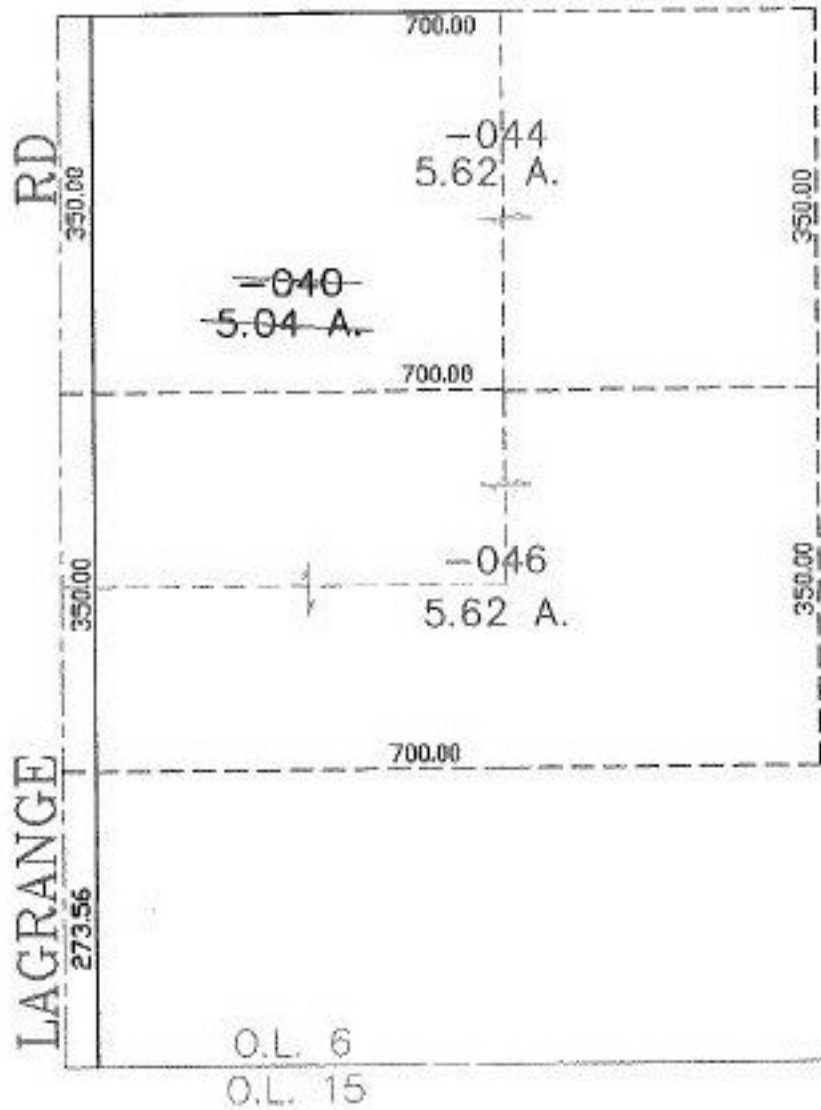

~~-041-~~  
~~50.71 A.~~

~~-045-~~  
~~50.13 A.~~

-047  
 44.51 A.



**SPLITS/DEEDS PROCESSED**  
 LORAIN COUNTY TAX MAP DEPARTMENT  
 226 MIDDLE AVE. ELYRIA, OHIO

SURVEYED BY: THOMAS J. NEFF  
 CLOSURE: 0.00 : 10.000  
 MAP PAGE(S): 15-C  
 APPROVED BY: JAH DATE: 9-18-03  
 SCALE: 1" = 200' PRIOR INSTRUMENT: 20010770163