
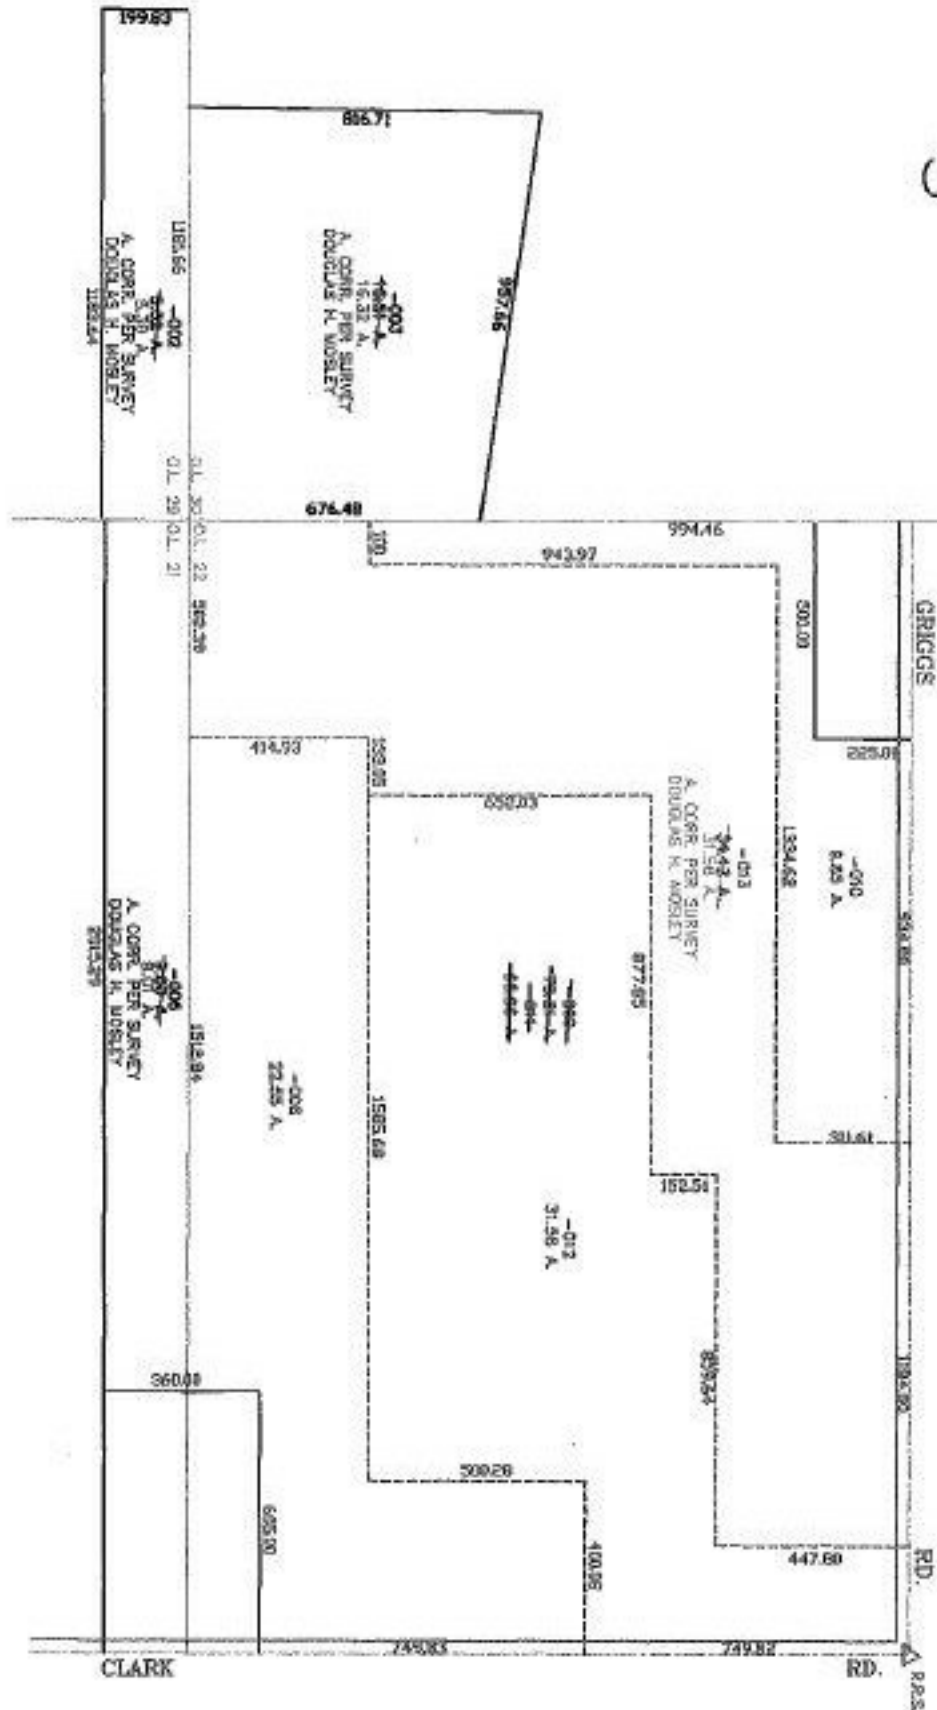


PARENT PARCEL: 21-05-022-000-007

CHILD PARCEL: 21-05-022-008 THRU -013

STARTING POINT: CENTERLINE OF GRIGGS RD. & CLARK RD.

NO. 014689

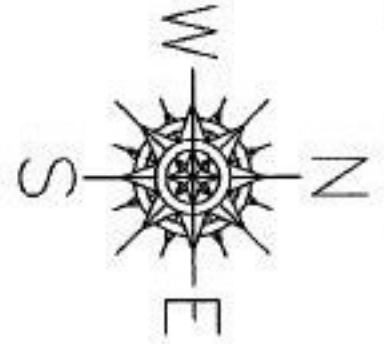

**SPLITS/DEEDS PROCESSED**

LORAIN COUNTY TAX MAP DEPARTMENT  
226 MIDDLE AVE. ELYRIA, OHIO

DOUGLAS H. MOSXXXXXXXXXX

0.01 : 10,000XXXXXX

MAP PAGE(S): 21-~~A~~

APPROVED BY: JAH DATE: 9-23-03

SCALE: 1" = 500' PRIOR INSTRUMENT: 990639603