
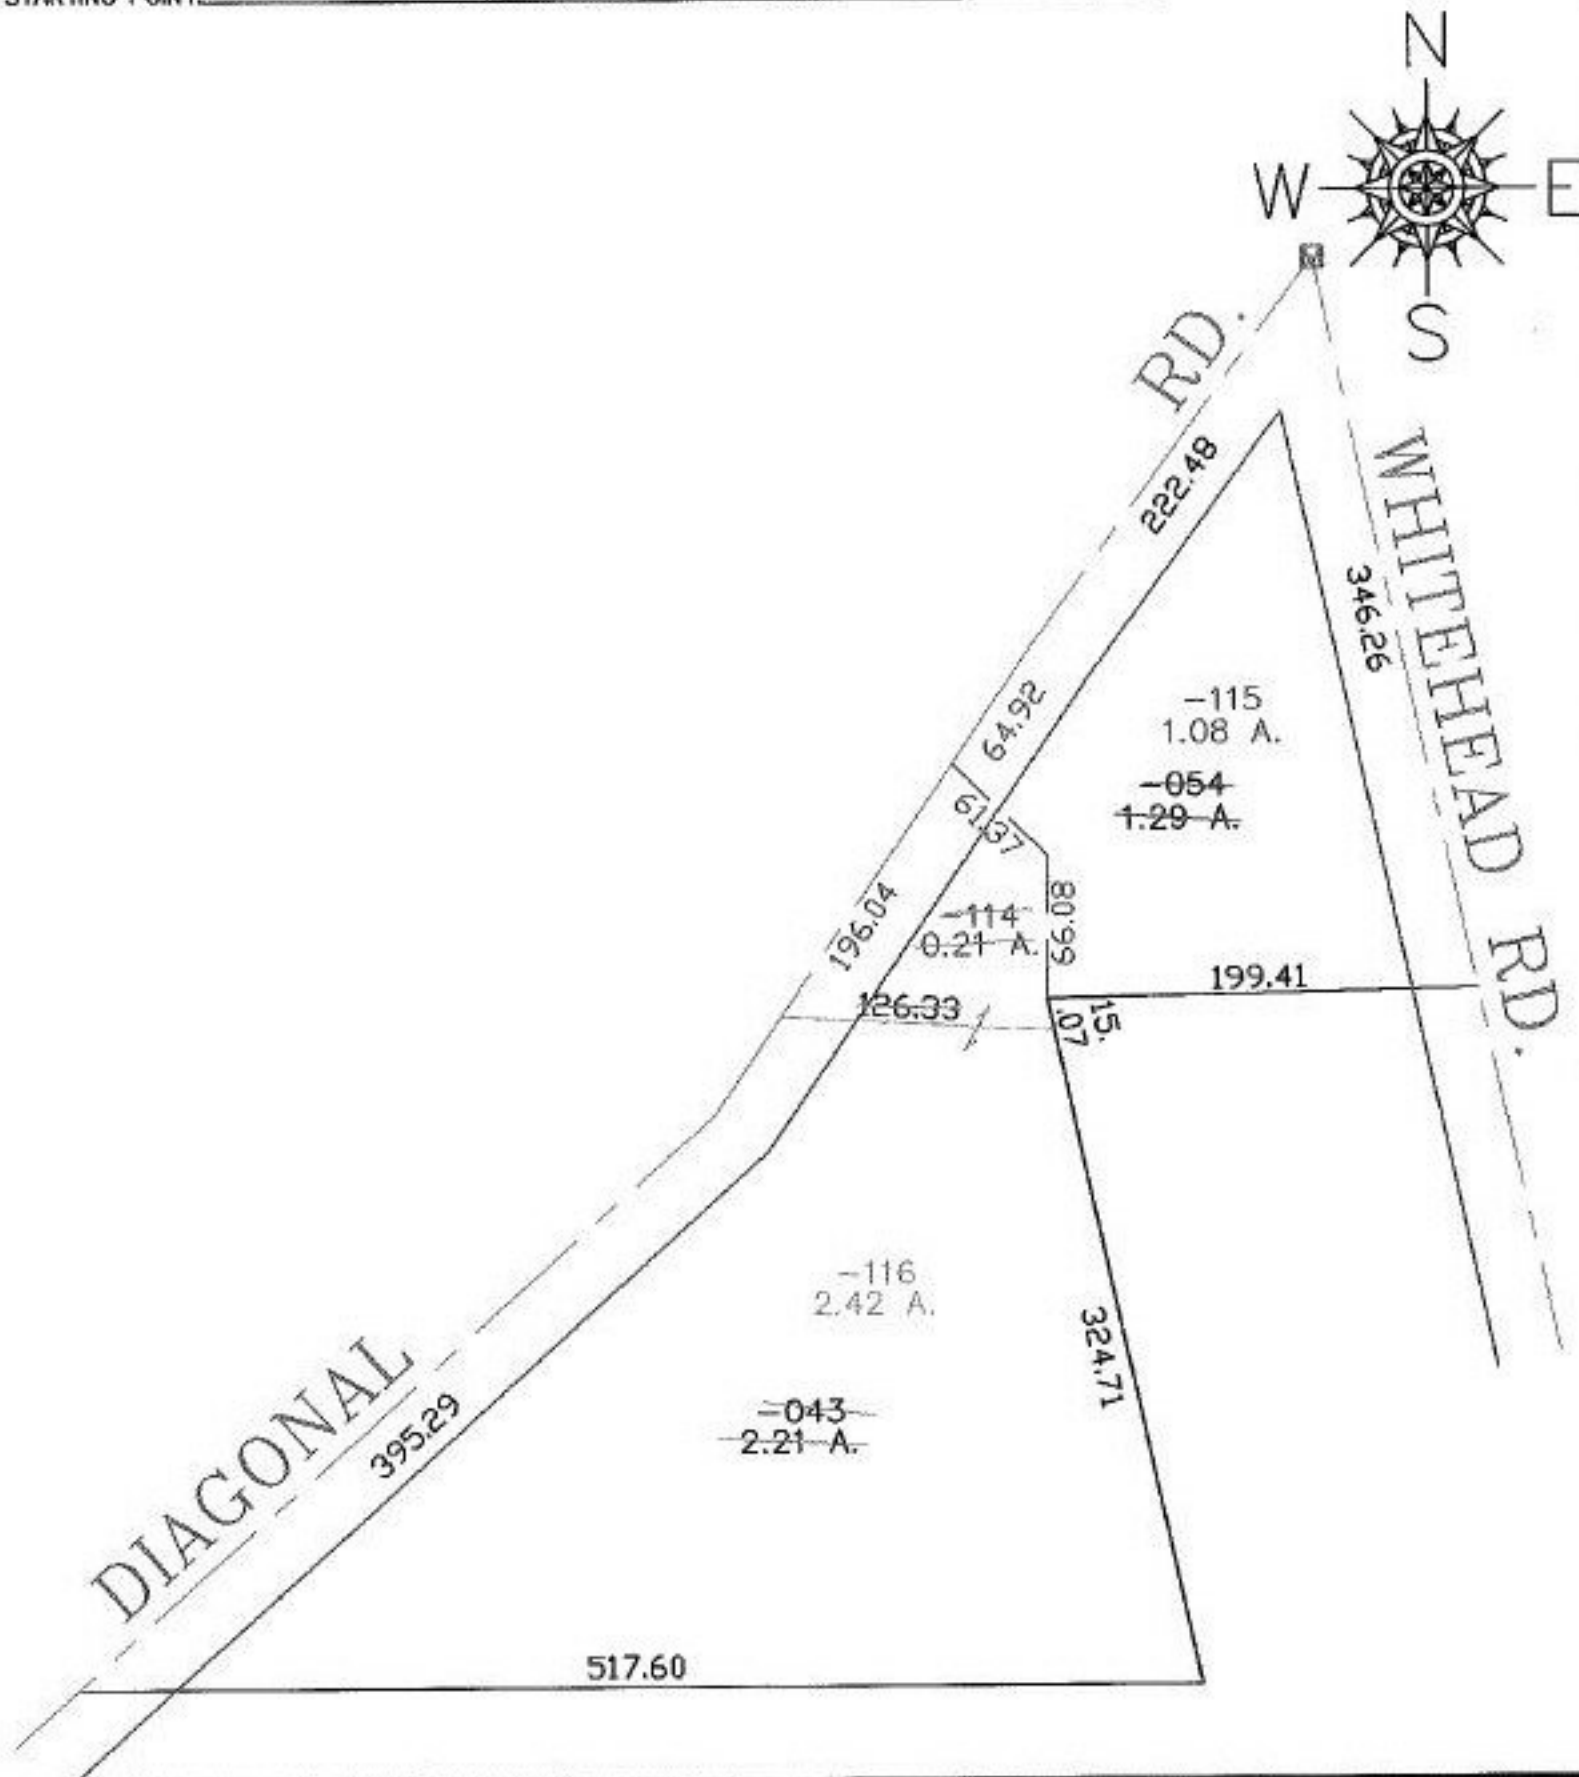


PARENT PARCEL: 10-00-019-000-054, -043

CHILD PARCEL: 10-00-019-000-114 THRU -116

STARTING POINT: CENTERLINE OF DIAGONAL RD. & WHITEHEAD RD.

NO. 01473

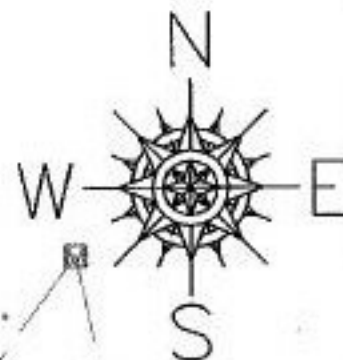

SPLITS/DEEDS PROCESSED

LORAIN COUNTY TAX MAP DEPARTMENT
226 MIDDLE AVE. ELYRIA, OHIO

SURVEYED BY: RICHARD D. CARLSON

CLOSURE: 0.00 : 10.000

MAP PAGE(S): 10-F

APPROVED BY: JAH DATE: 9-24-03

SCALE: 1" = 100' PRIOR INSTRUMENT: 20020873246