


EASTER

PARENT PARCEL: 09-00-028-000-003

CHILD PARCEL: 09-00-028-000-009, -010

STARTING POINT: CENTERLINE OF RUSSIA RD. & O.L. 28

NO. 01480

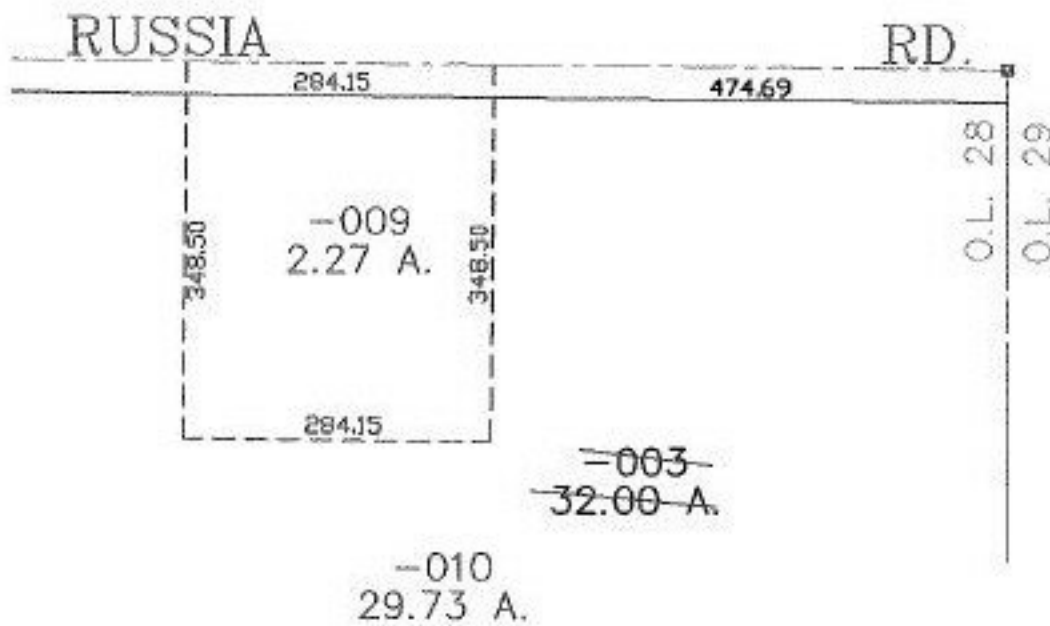

**SPLITS/DEEDS PROCESSED**  
**LORAIN COUNTY TAX MAP DEPARTMENT**  
 226 MIDDLE AVE. ELYRIA, OHIO

SURVEYED BY: ALEX KELSER  
 CLOSURE: 0.00 : 10.000  
 MAP PAGE(S): 9-D  
 APPROVED BY: JAH DATE: 9-30-03  
 SCALE: 1" = 200 PRIOR INSTRUMENT: 20020820768