
PARENT PARCEL: 07-00-004-108-048

CHILD PARCEL: 07-00-004-108-090 THRU -093

NO. 01484

STARTING POINT: CENTERLINE OF CHESTNUT RIDGE RD. & LEAR NAGLE RD.



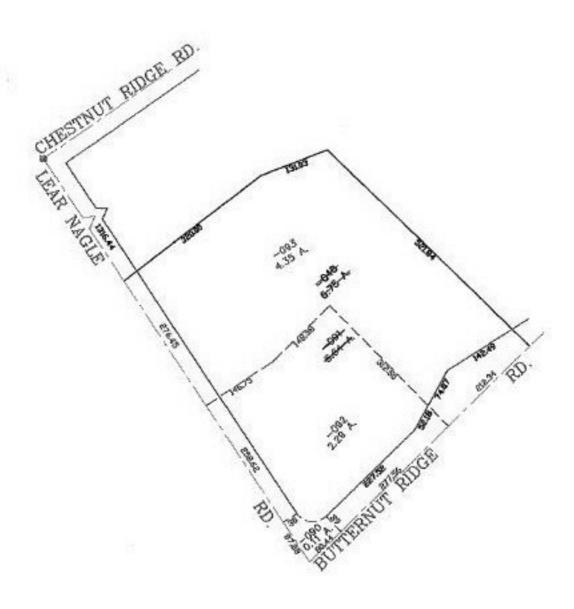

SPLITS/DEEDS PROCESSED

LORAIN COUNTY TAX MAP DEPARTMENT
226 MIDDLE AVE. ELYRIA, OHIO

SURVEYED BY: JAMES E. KARING

CLOSURE: 0.00 : 10,000

MAP PAGE(S): 07-00-004-C

APPROVED BY: JAH DATE: 10-8-03

SCALE: 1"= 200 PRIOR INSTRUMENT: 20000691342