
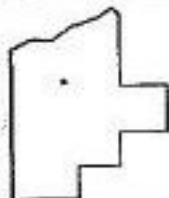


PARENT PARCEL: 03-00-066-103-041

CHILD PARCEL: 03-00-066-103-076 THRU -079

STARTING POINT: CENTERLINE OF LINDA LN. & SHEFFIELD FRENCH CREEK RD.

NO. 01488

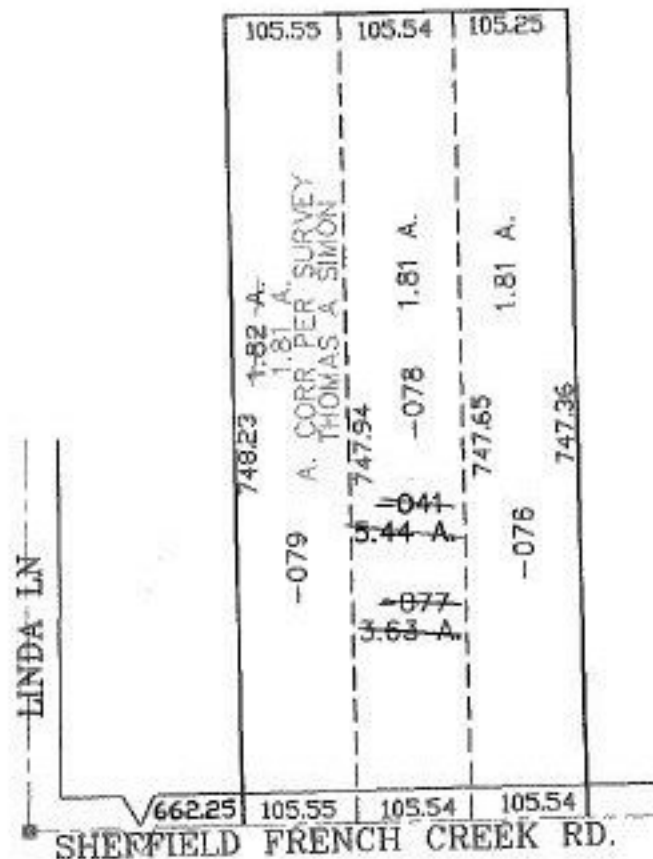

**SPLITS/DEEDS PROCESSED**  
**LORAIN COUNTY TAX MAP DEPARTMENT**  
 226 MIDDLE AVE. ELYRIA, OHIO

SURVEYED BY: THOMAS A. SIMON  
 CLOSURE: 0.00 : 10.000  
 MAP PAGE(S): 03-00-066-C  
 APPROVED BY: JAH DATE: 10-9-03  
 SCALE: 1" = 200' PRIOR INSTRUMENT: