
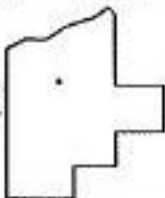


PARENT PARCEL: 01-00-066-000-002

CHILD PARCEL: 01-00-066-000-027 THRU -030

STARTING POINT: CENTERLINE OF GORE-ORPHANGE RD. & O.L. 66

NO. 01496

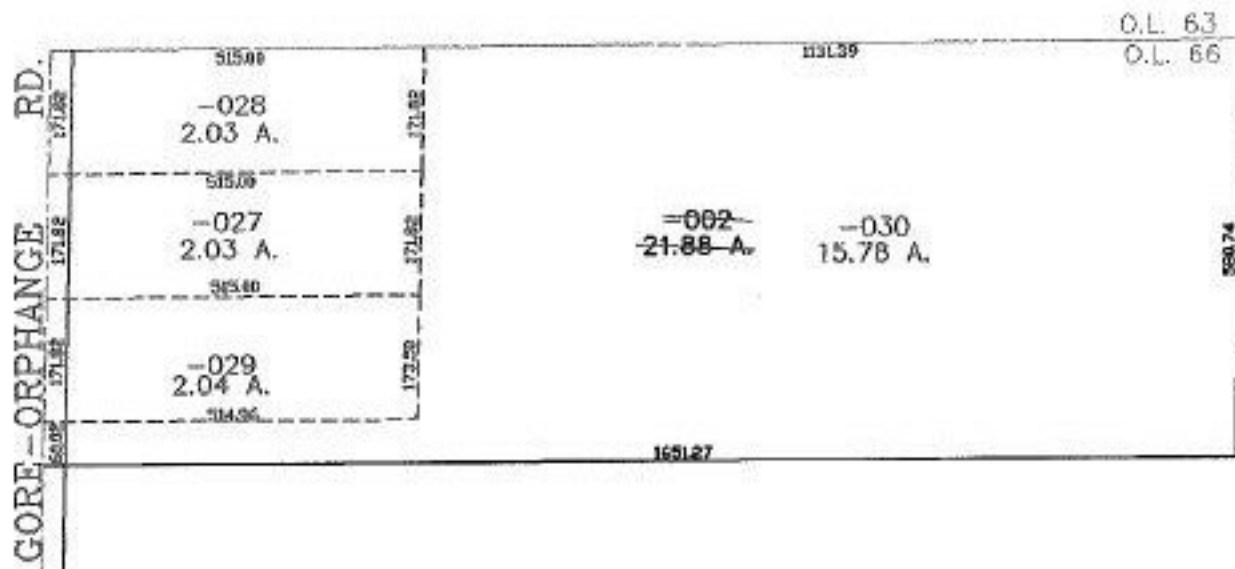

SPLITS/DEEDS PROCESSED
LORAIN COUNTY TAX MAP DEPARTMENT
 226 MIDDLE AVE. ELYRIA, OHIO

SURVEYED BY: ALEX KELSER
 CLOSURE: 0.00 : 10.000
 MAP PAGE(S): 01-00-066-B
 APPROVED BY: JAH DATE: 10-15-03
 SCALE: 1" = 300 PRIOR INSTRUMENT: 20020815572