
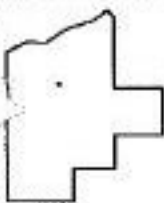


PARENT PARCEL: 04-00-002-102-004, -081

CHILD PARCEL: 04-00-002-102-126 THRU -130

STARTING POINT: NORTHWEST CORNER OF O.L. 2 & O.L. 3

NO. 01499

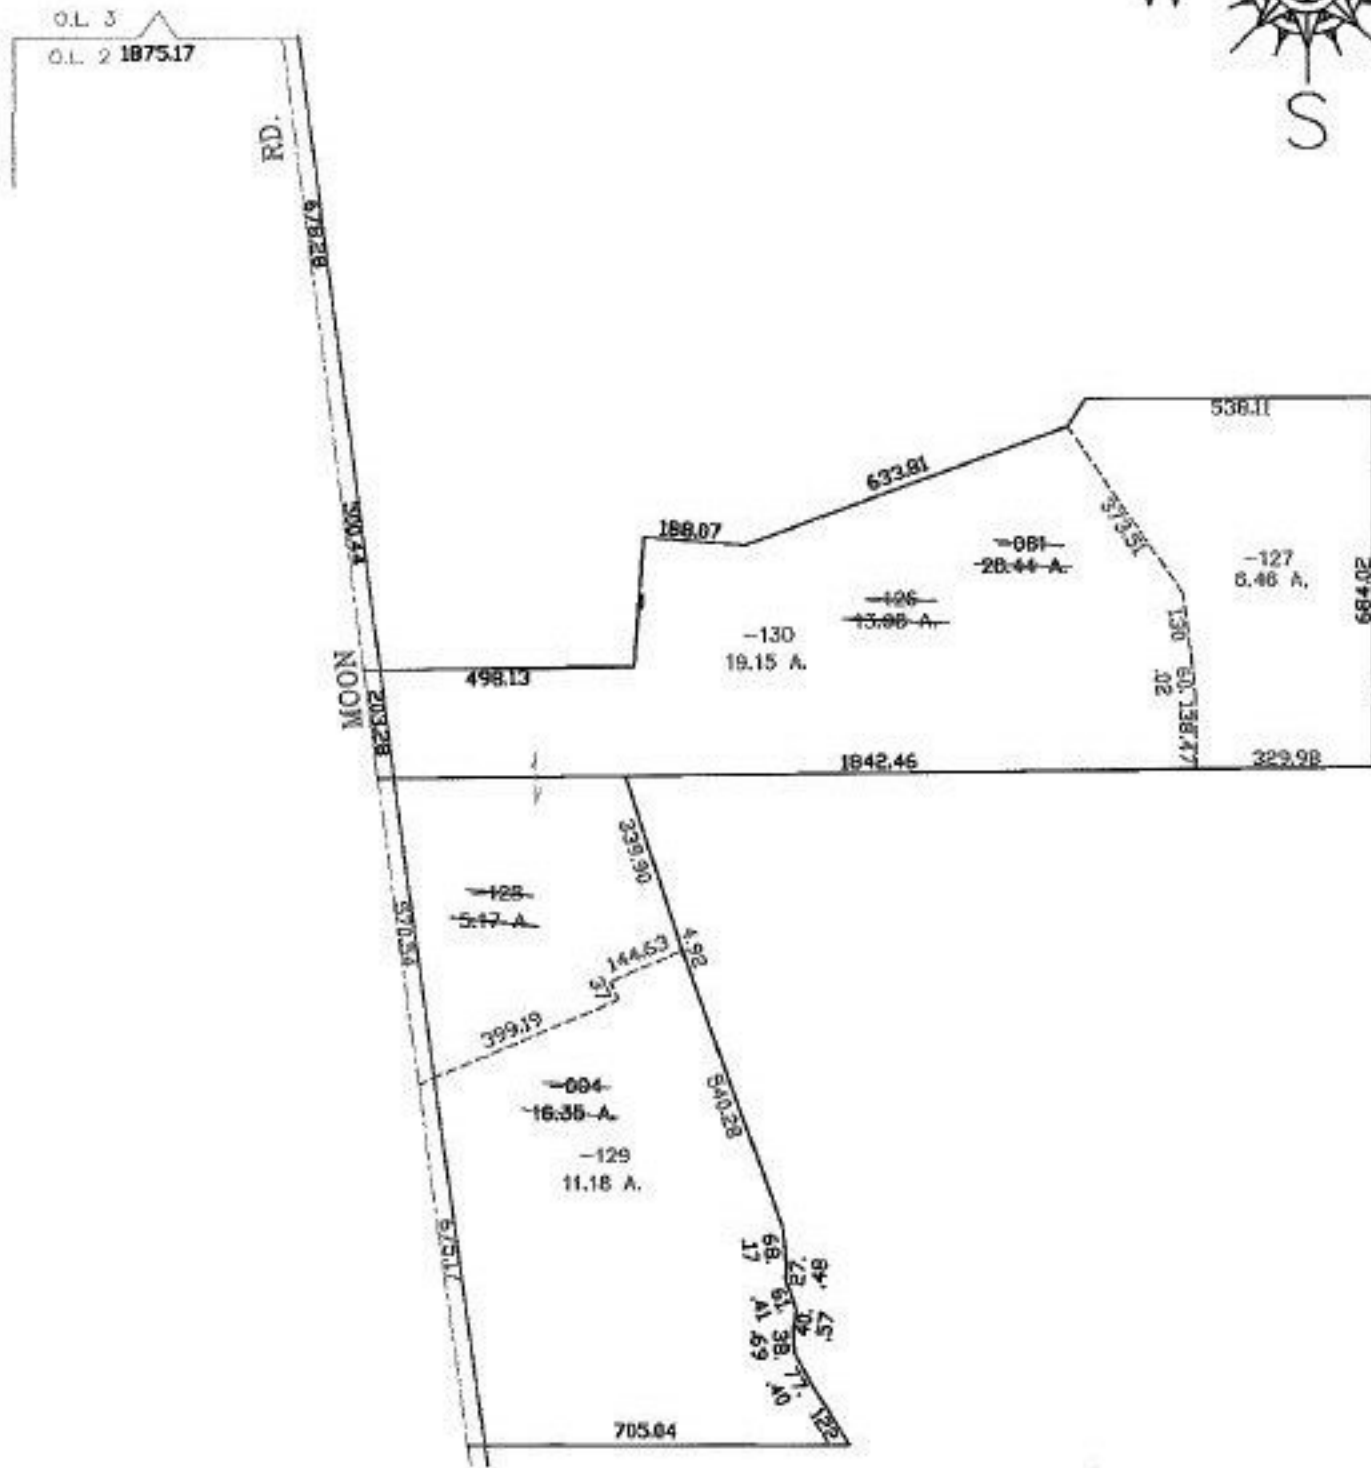

**SPLITS/DEEDS PROCESSED**  
LORAIN COUNTY TAX MAP DEPARTMENT  
226 MIDDLE AVE. ELYRIA, OHIO

SURVEYED BY: DONALD E. HIMES  
CLOSURE: 0.00 : 10.000  
MAP PAGE(S): 04-00-002-C  
APPROVED BY: JAH DATE: 11-25-02  
SCALE: 1" = 400' PRIOR INSTRUMENT: 20020865508