
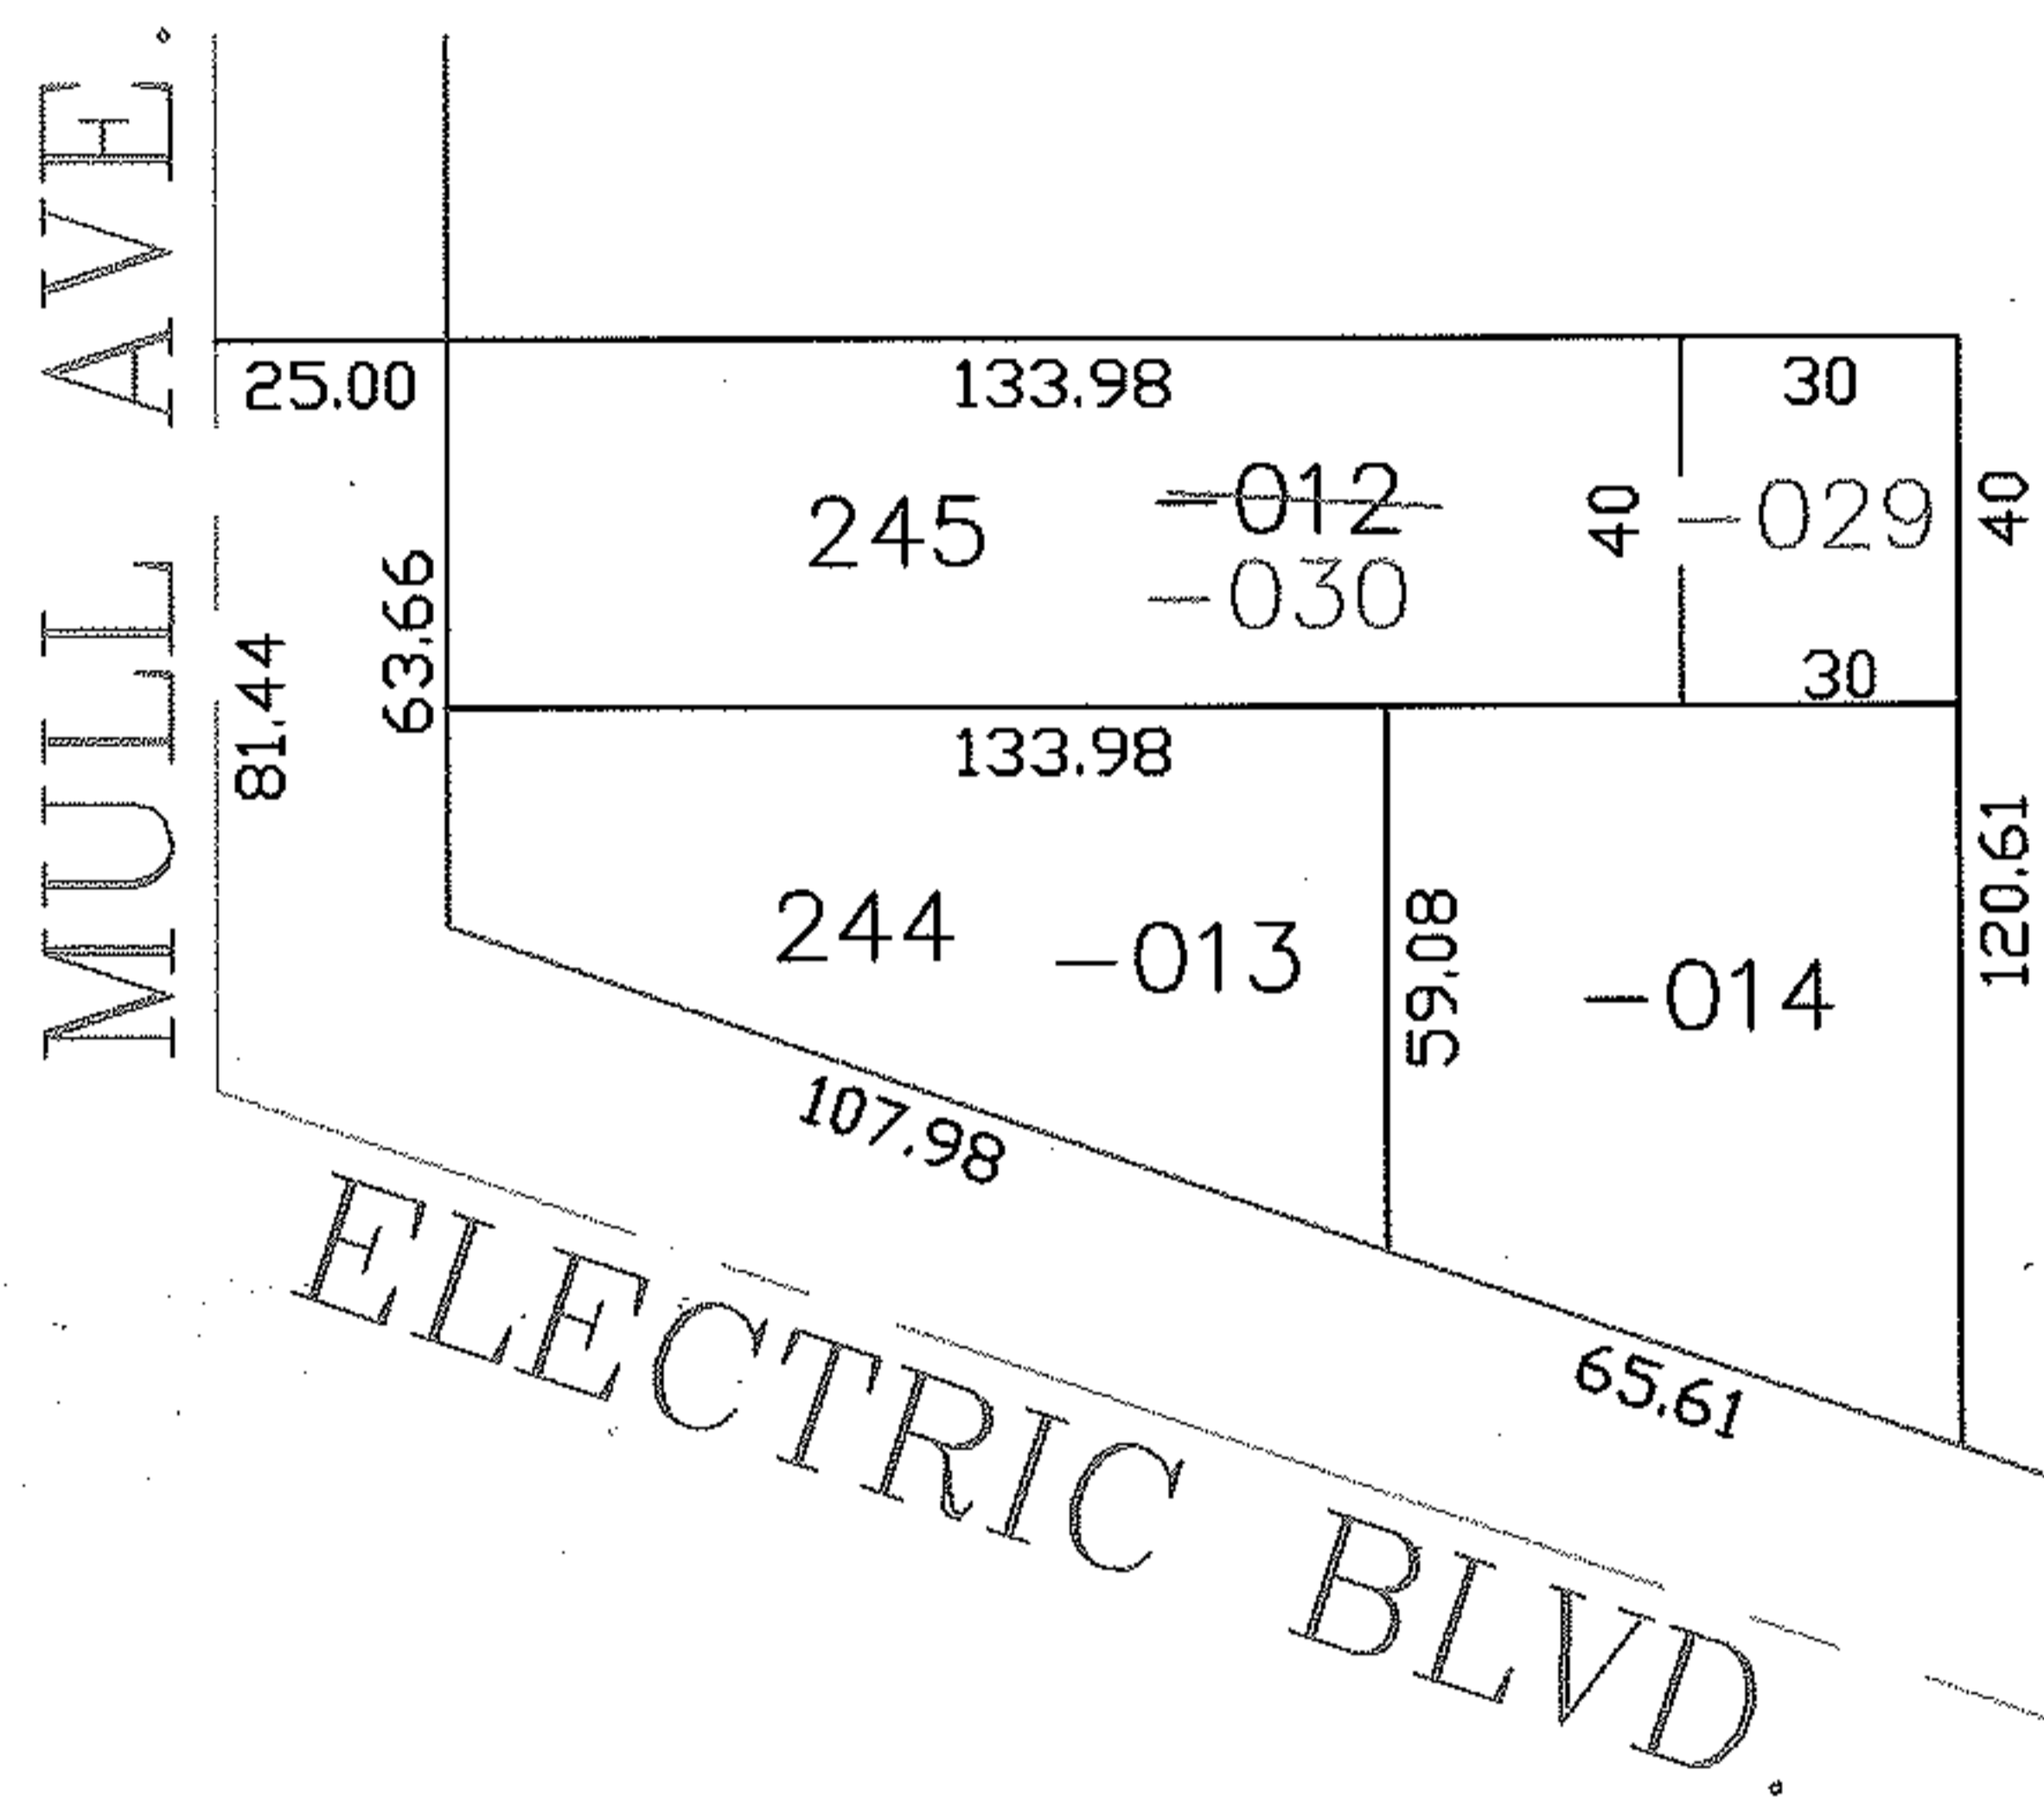


MASTER

PARENT PARCEL: 04-00-030-109-012
CHILD PARCEL: 04-00-030-109-029, -030
STARTING POINT: CENTERLINE OF MULL AVE. & ELECTRIC BLVD.

NO. 01500

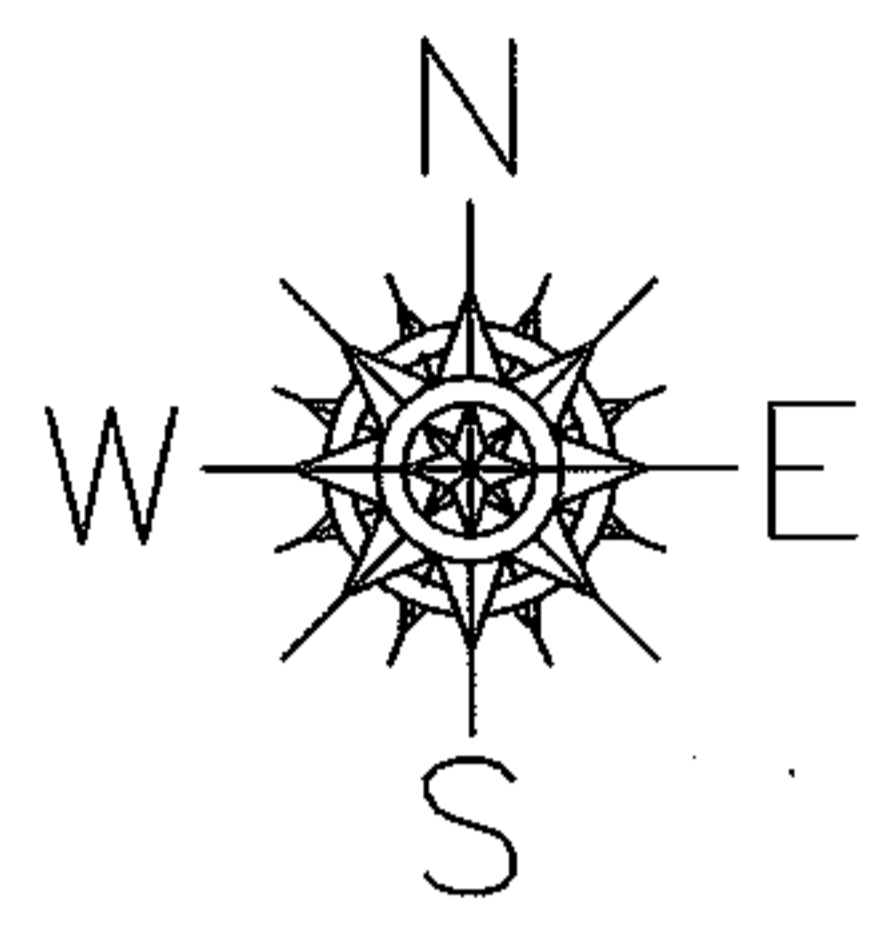

SPLITS/DEEDS PROCESSED

LORAIN COUNTY TAX MAP DEPARTMENT
226 MIDDLE AVE. ELYRIA, OHIO

SURVEYED BY: CHRISTOPHER M. HIRZEL
CLOSURE: 0.00 : 10.000
MAP PAGE(S): 03-00-030-A
APPROVED BY: JAH DATE: 10-22-03
SCALE: 1" = 100 PRIOR INSTRUMENT: OR 918/648