
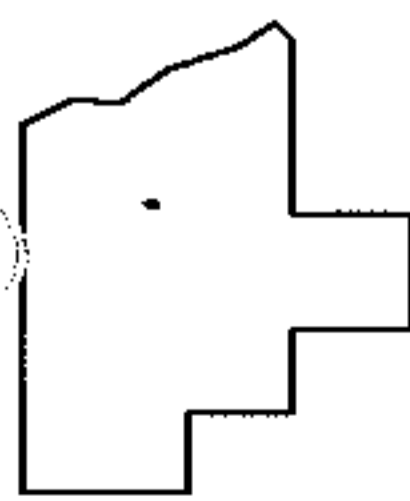
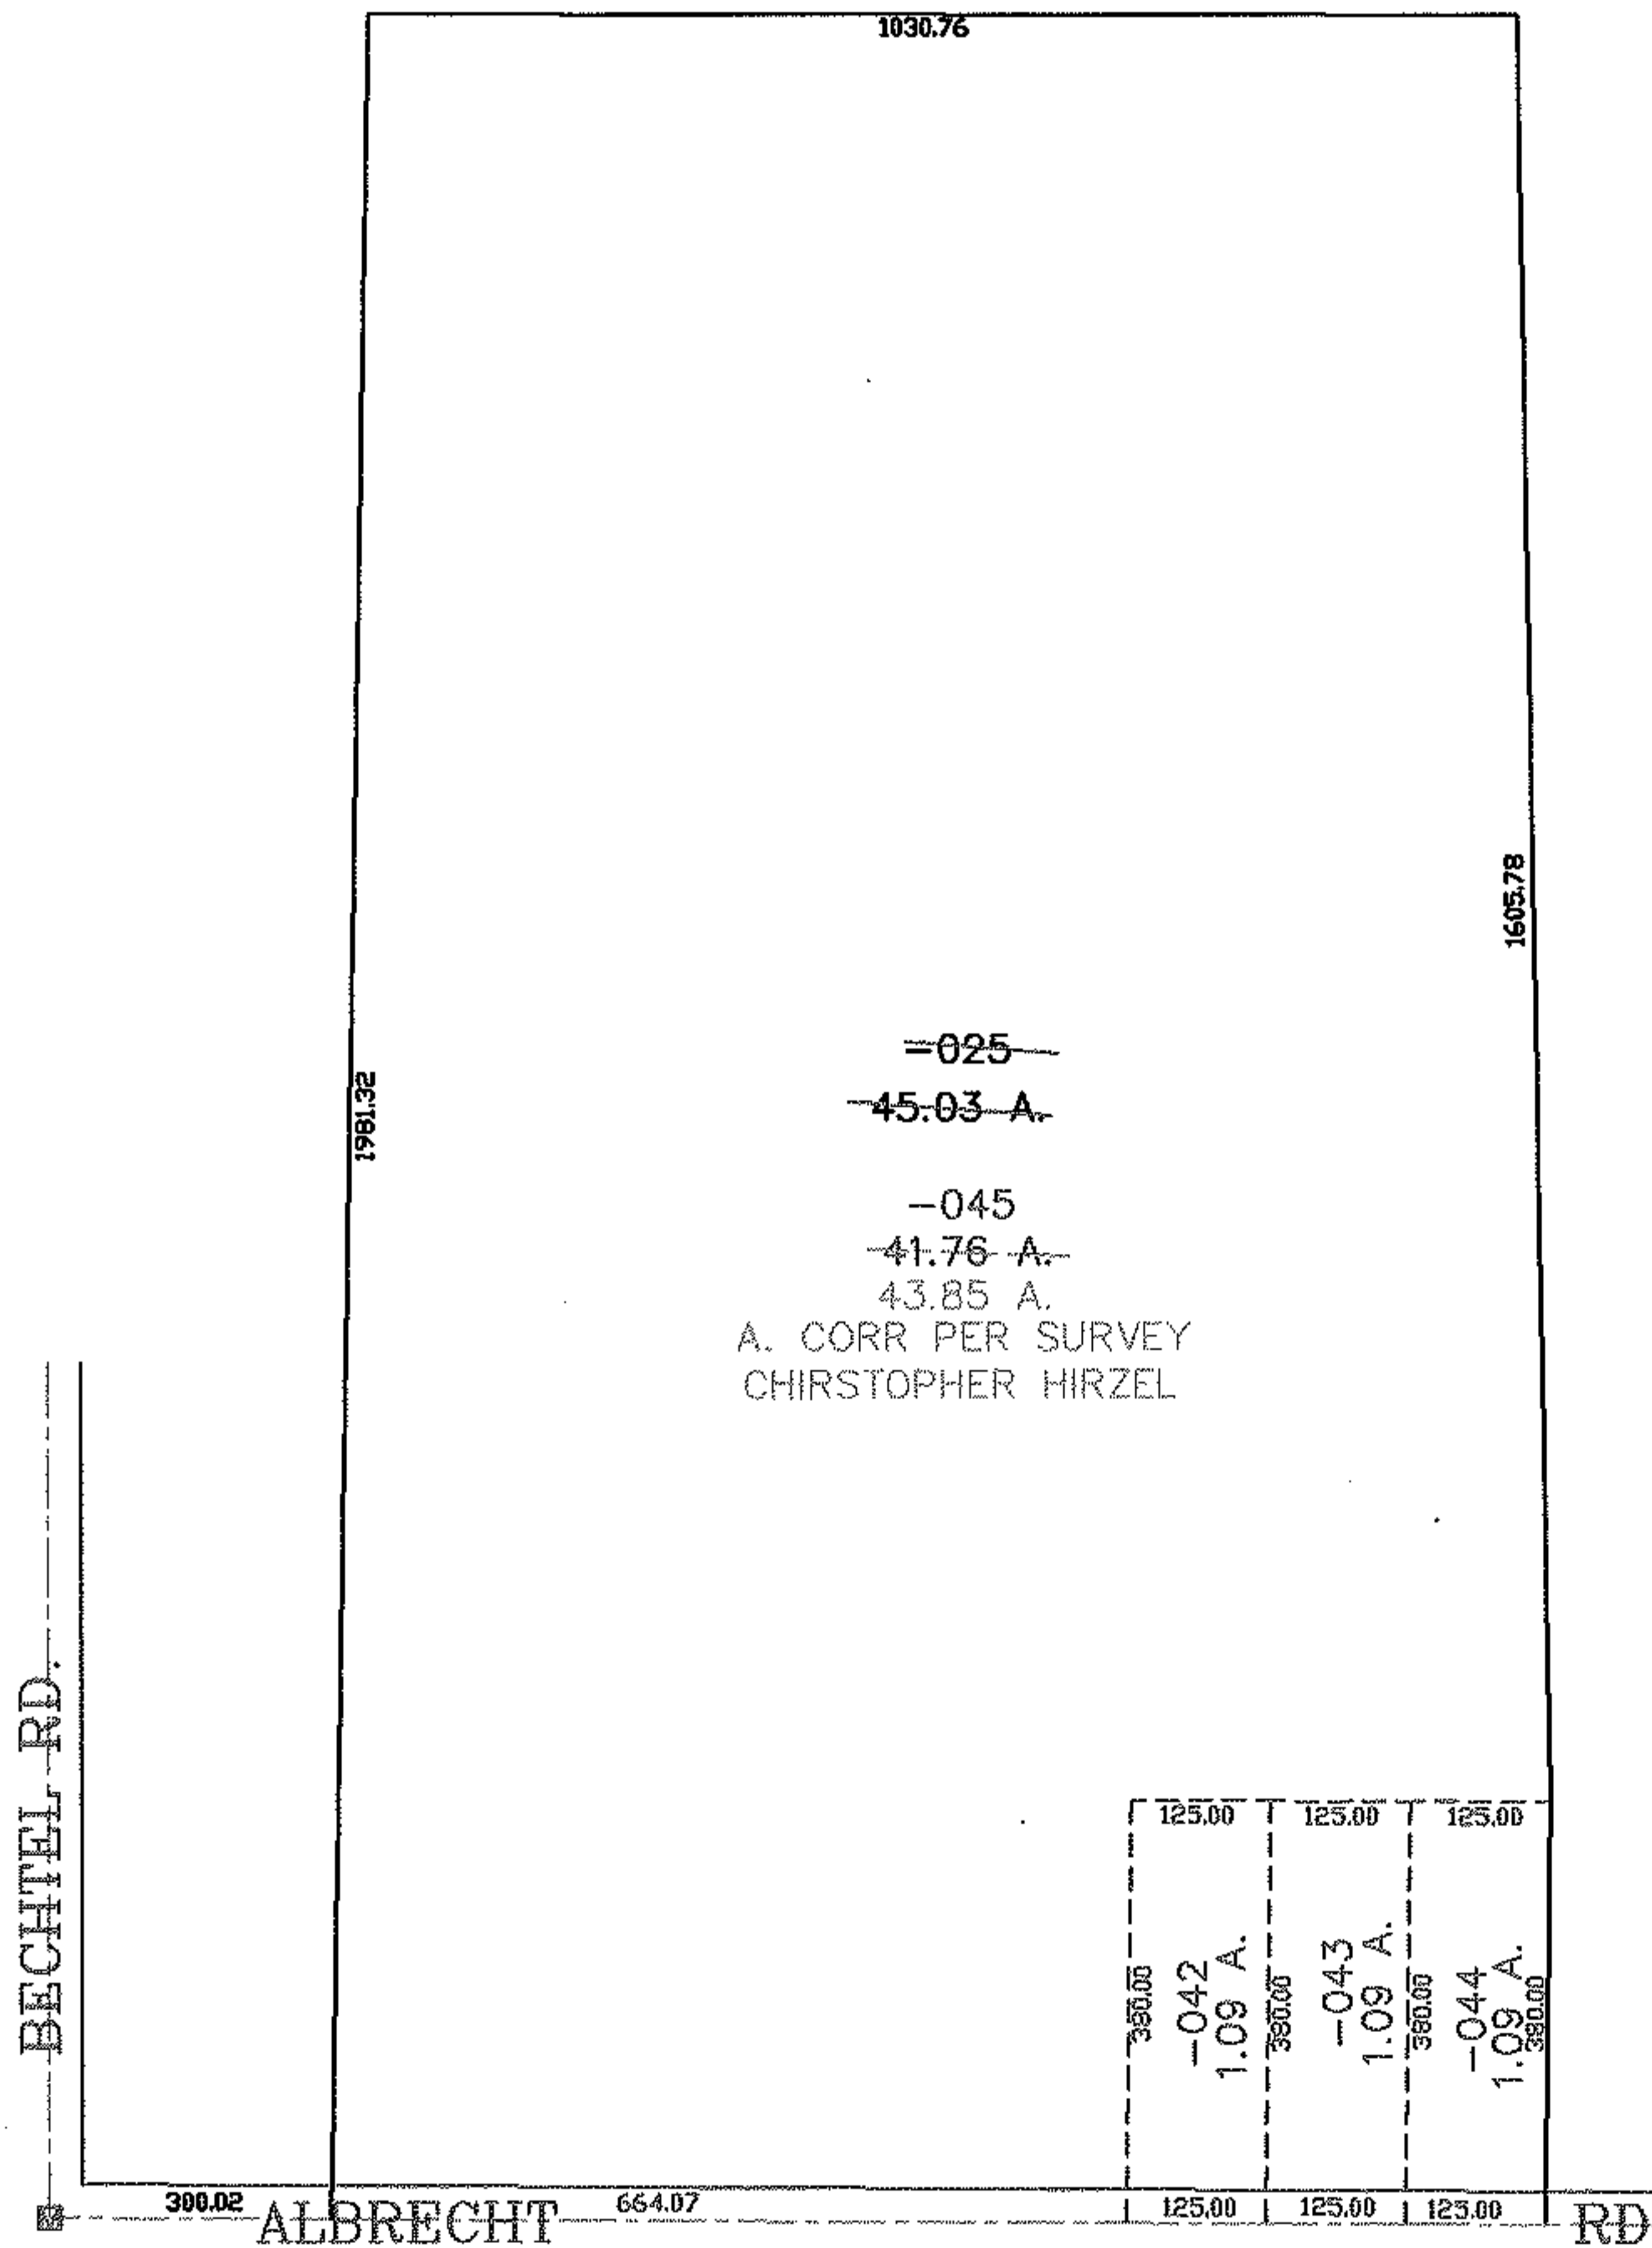


PARENT PARCEL: 05-00-071-000-025

CHILD PARCEL: 05-00-071-000-042 THRU -045

STARTING POINT: CENTERLINE OF BECHTEL RD. & ALBRECHT RD.

NO. 01505

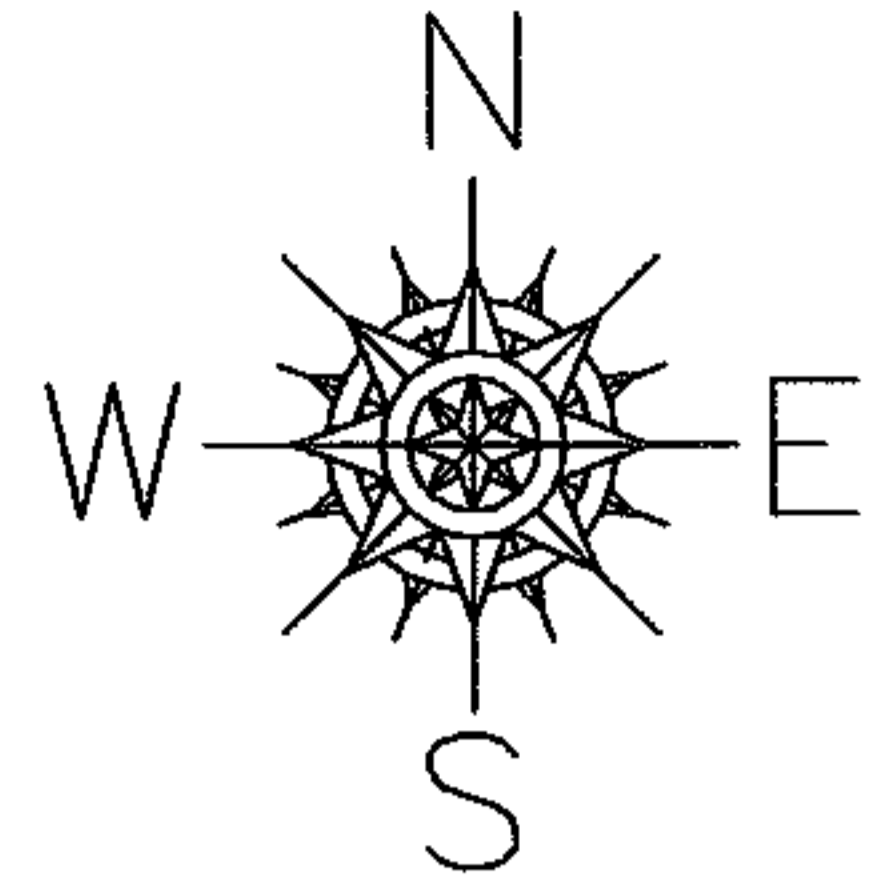

SPLITS/DEEDS PROCESSED
 LORAIN COUNTY TAX MAP DEPARTMENT
 226 MIDDLE AVE. ELYRIA, OHIO

SURVEYED BY: CHRISTOPHER HIRZEL
 CLOSURE: 0.00 : 10,000
 MAP PAGE(S): 05-00-071-B
 APPROVED BY: JAH DATE: 10-31-03
 SCALE: 1" = 300 PRIOR INSTRUMENT: 980532119