
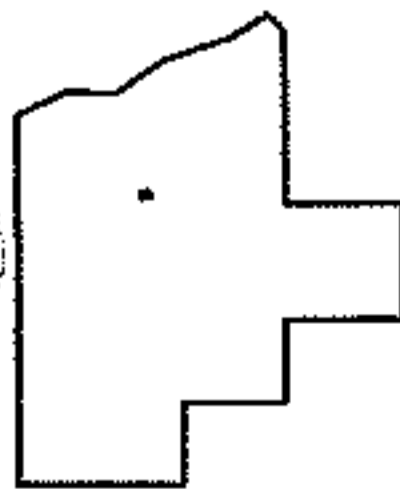
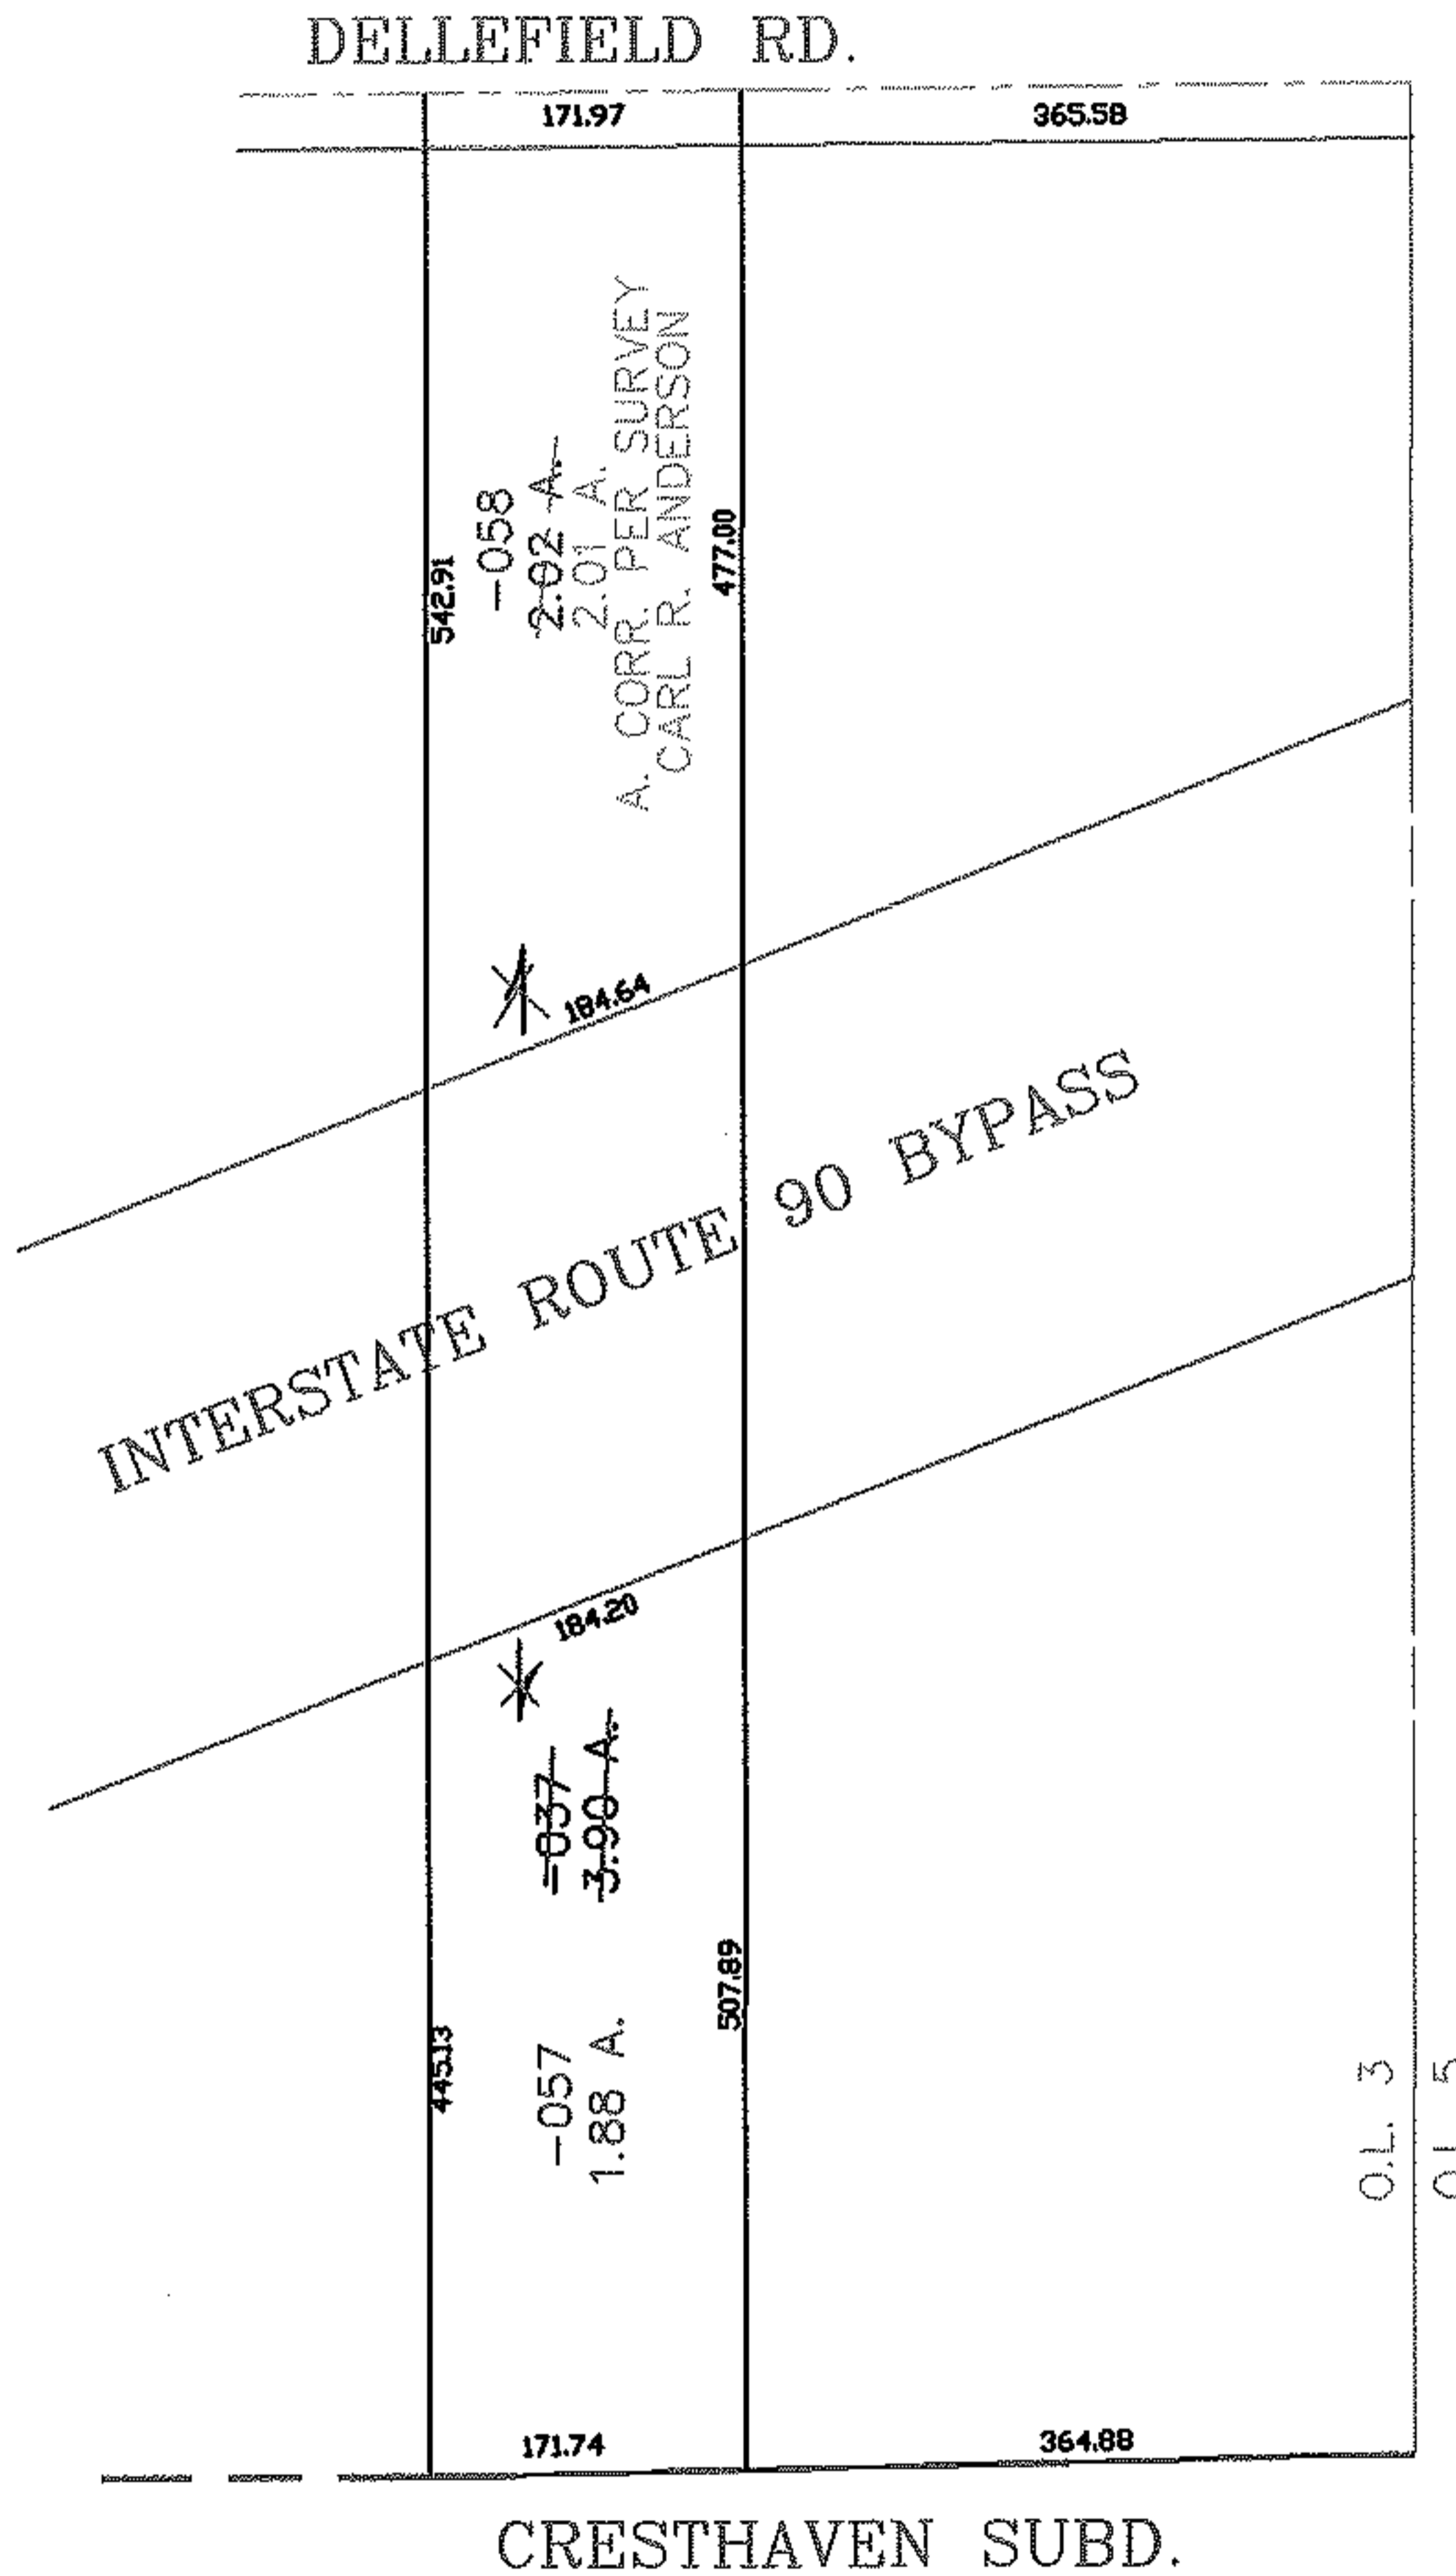


PARENT PARCEL: 06-23-003-102-037

CHILD PARCEL: 06-23-003-102-057, -058

STARTING POINT: CENTERLINE OF DELLEFIELD RD. & O.L. 3

NO. 01507

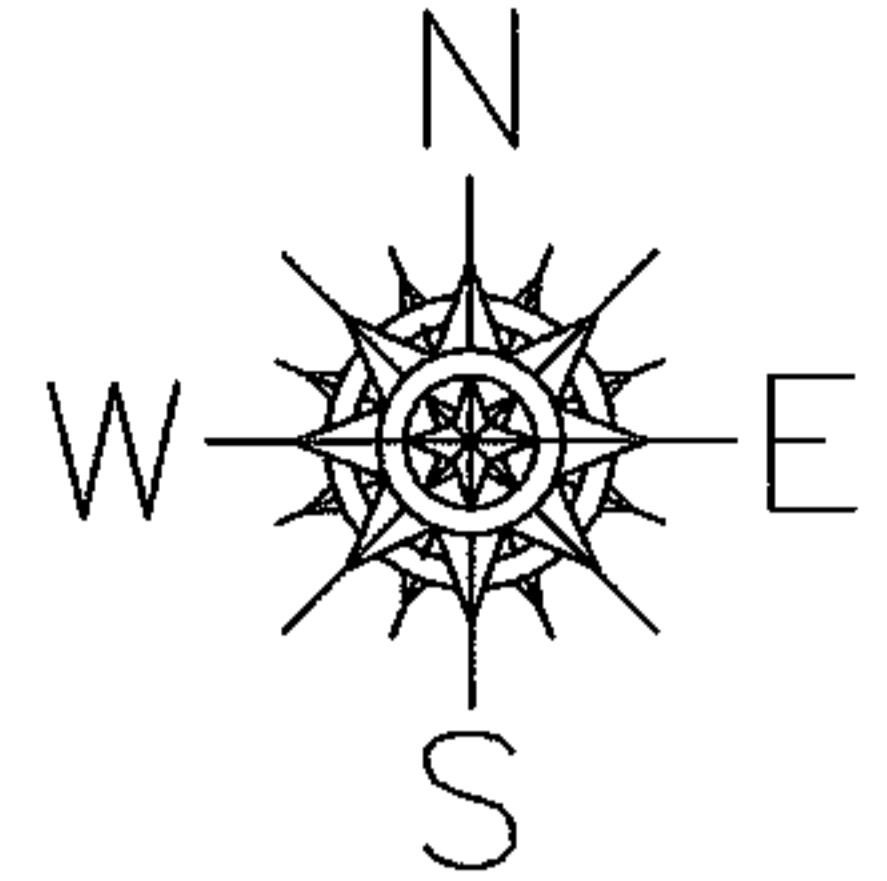

SPLITS/DEEDS PROCESSED
LORAIN COUNTY TAX MAP DEPARTMENT
 226 MIDDLE AVE. ELYRIA, OHIO

SURVEYED BY: CARL R. ANDERSON
 CLOSURE: 0.01 : 10.000
 MAP PAGE(S): 6-39
 APPROVED BY: JAH DATE: 11-3-03
 SCALE: 1" = 200 PRIOR INSTRUMENT: 990609371