


RASTER

PARENT PARCEL: 05-00-060-103-038, -041, -042



CHILD PARCEL: 05-00-060-103-043

STARTING POINT: INT CL COOPER FOSTER AND OBERLIN AVE

NO. 01509

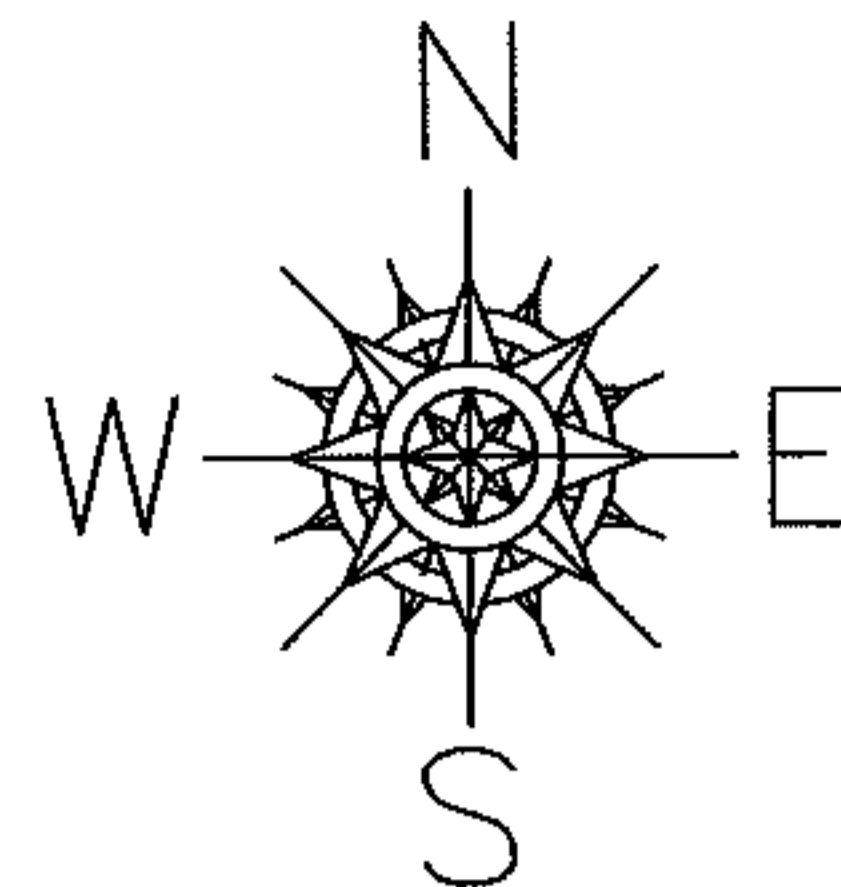

### COOPER FOSTER PARK RD

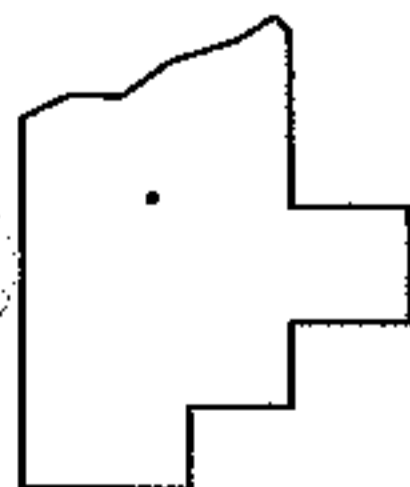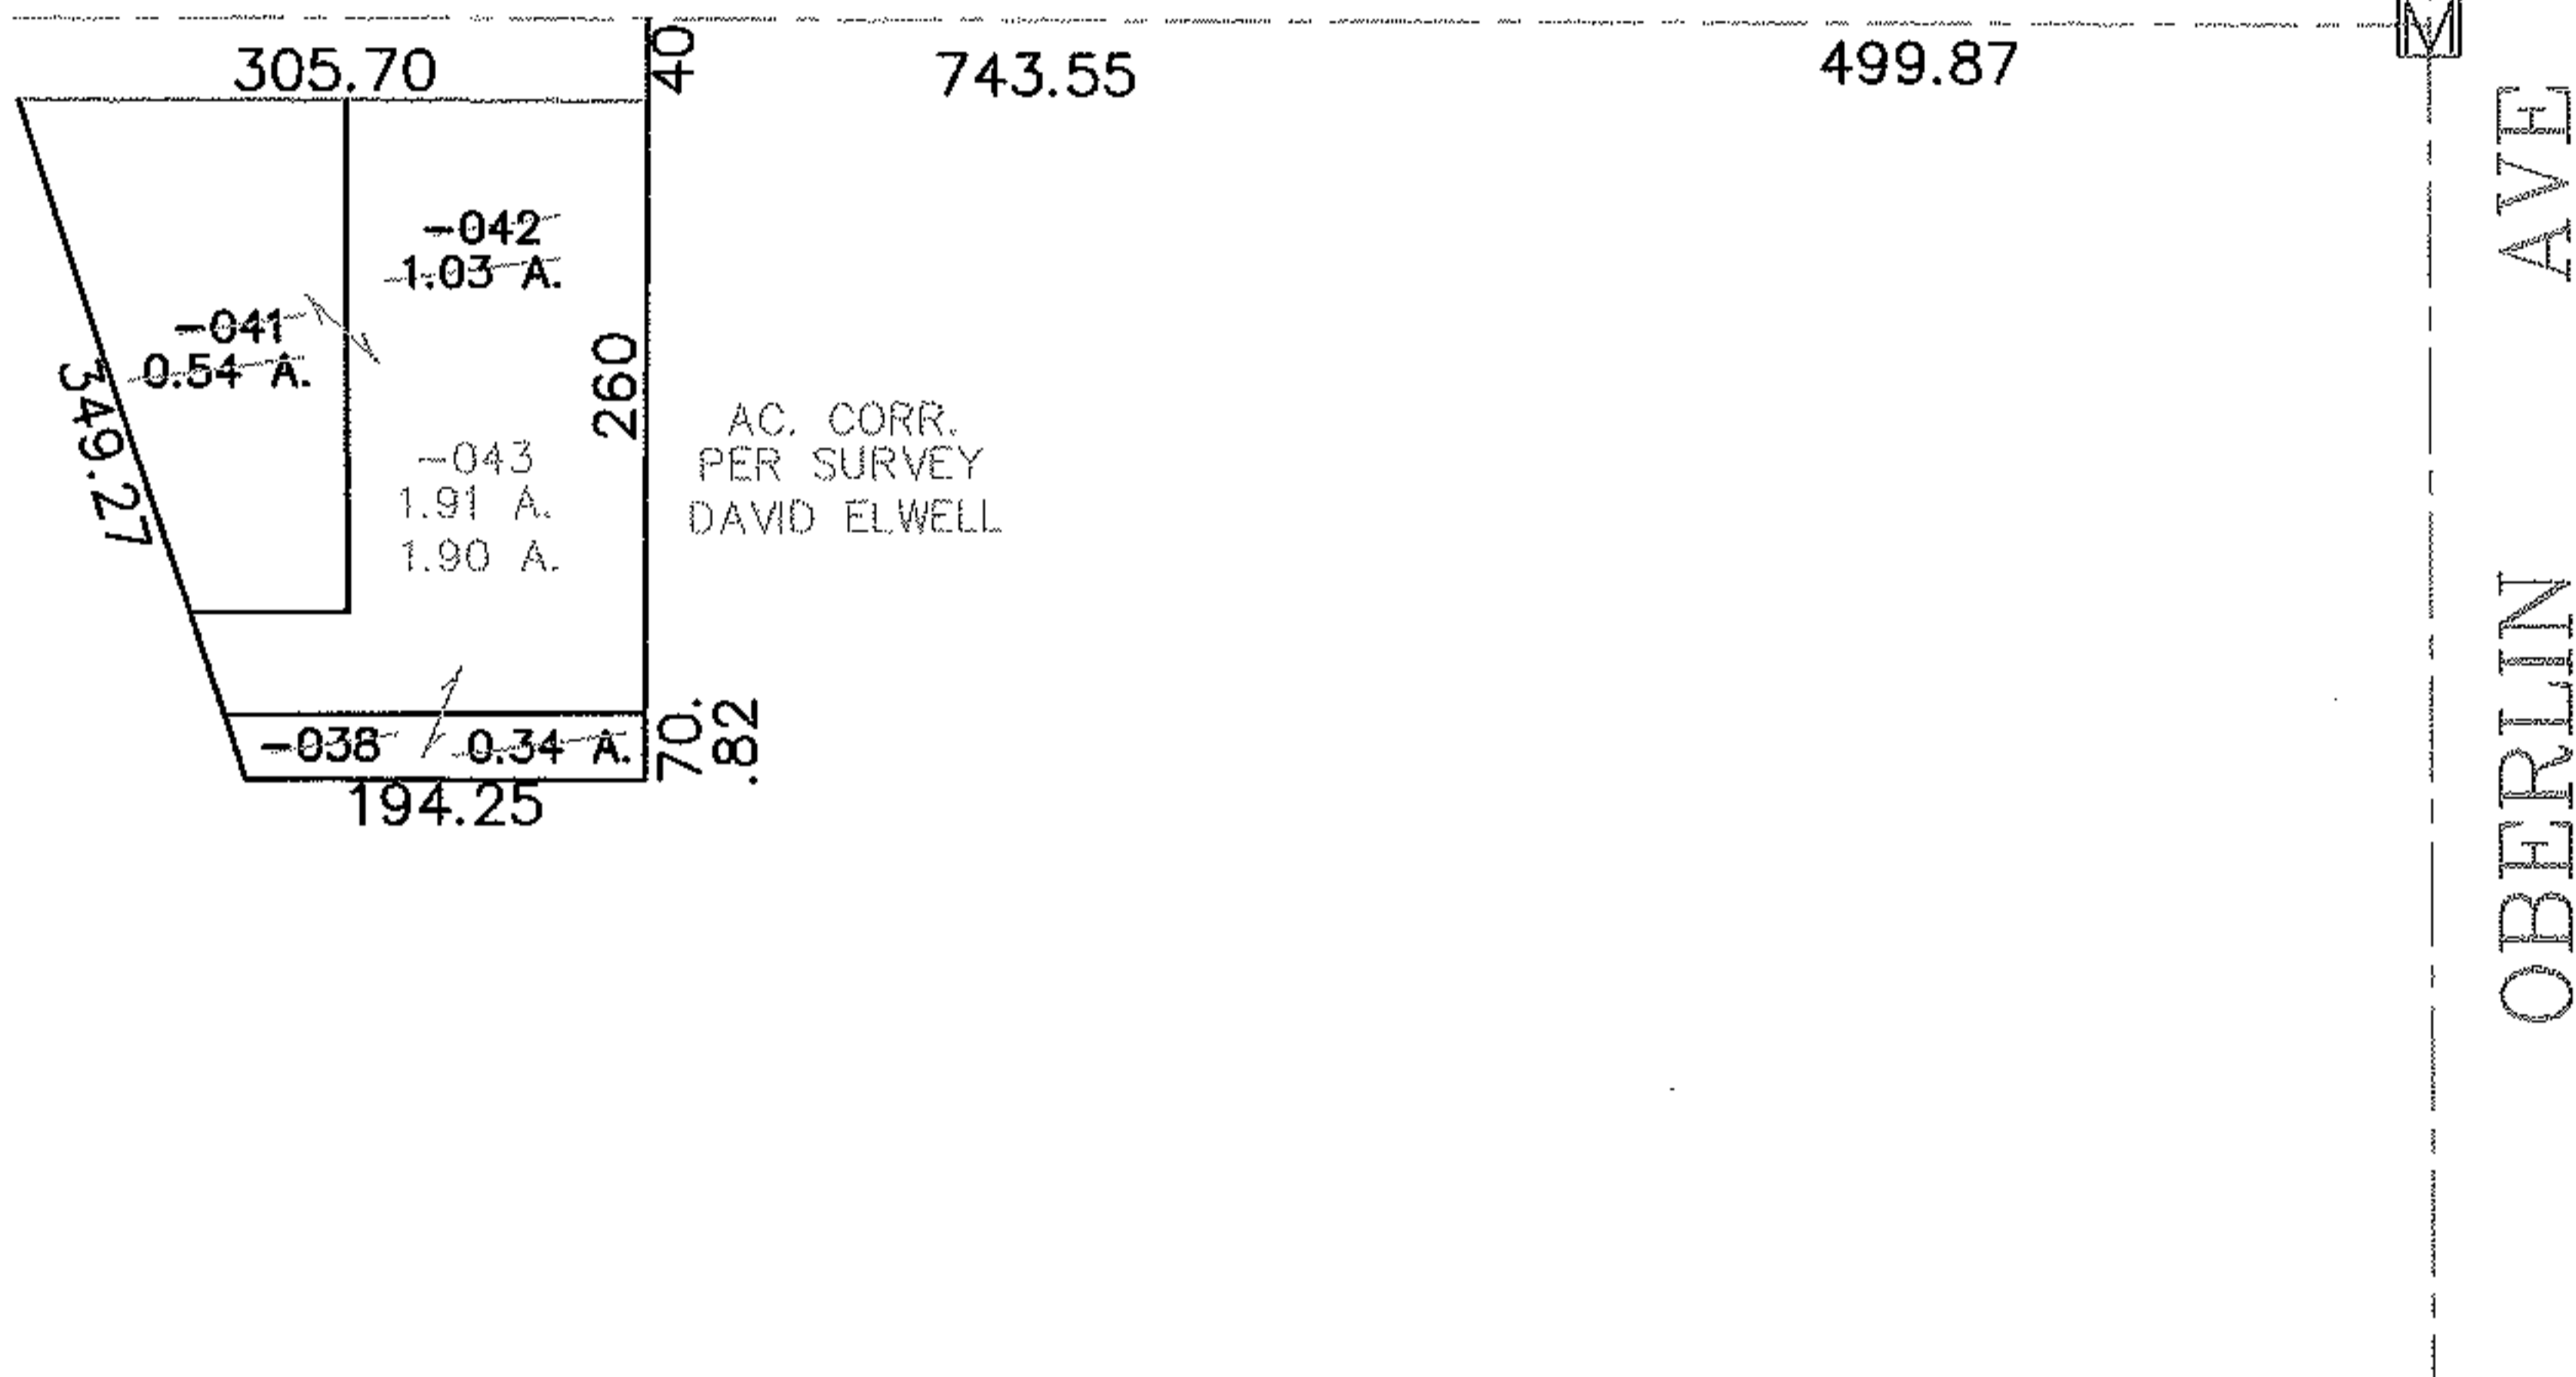

**SPLITS/DEEDS PROCESSED**  
**LORAIN COUNTY TAX MAP DEPARTMENT**  
 226 MIDDLE AVE. ELYRIA, OHIO

SURVEYED BY: DAVID ELWELL  
 CLOSURE: 1:10,000  
 MAP PAGE(S): 05-00-060-B  
 APPROVED BY: DRH DATE: 11/14/2003  
 SCALE: 1" = 200 PRIOR INSTRUMENT: DV 863/567