
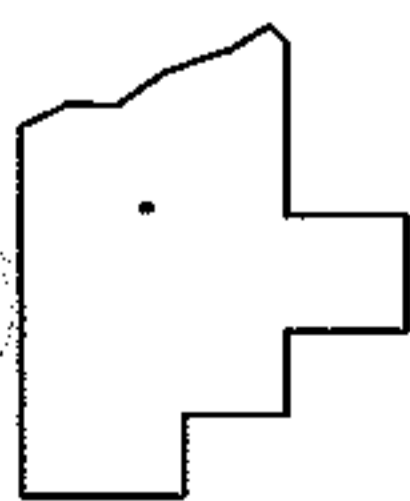
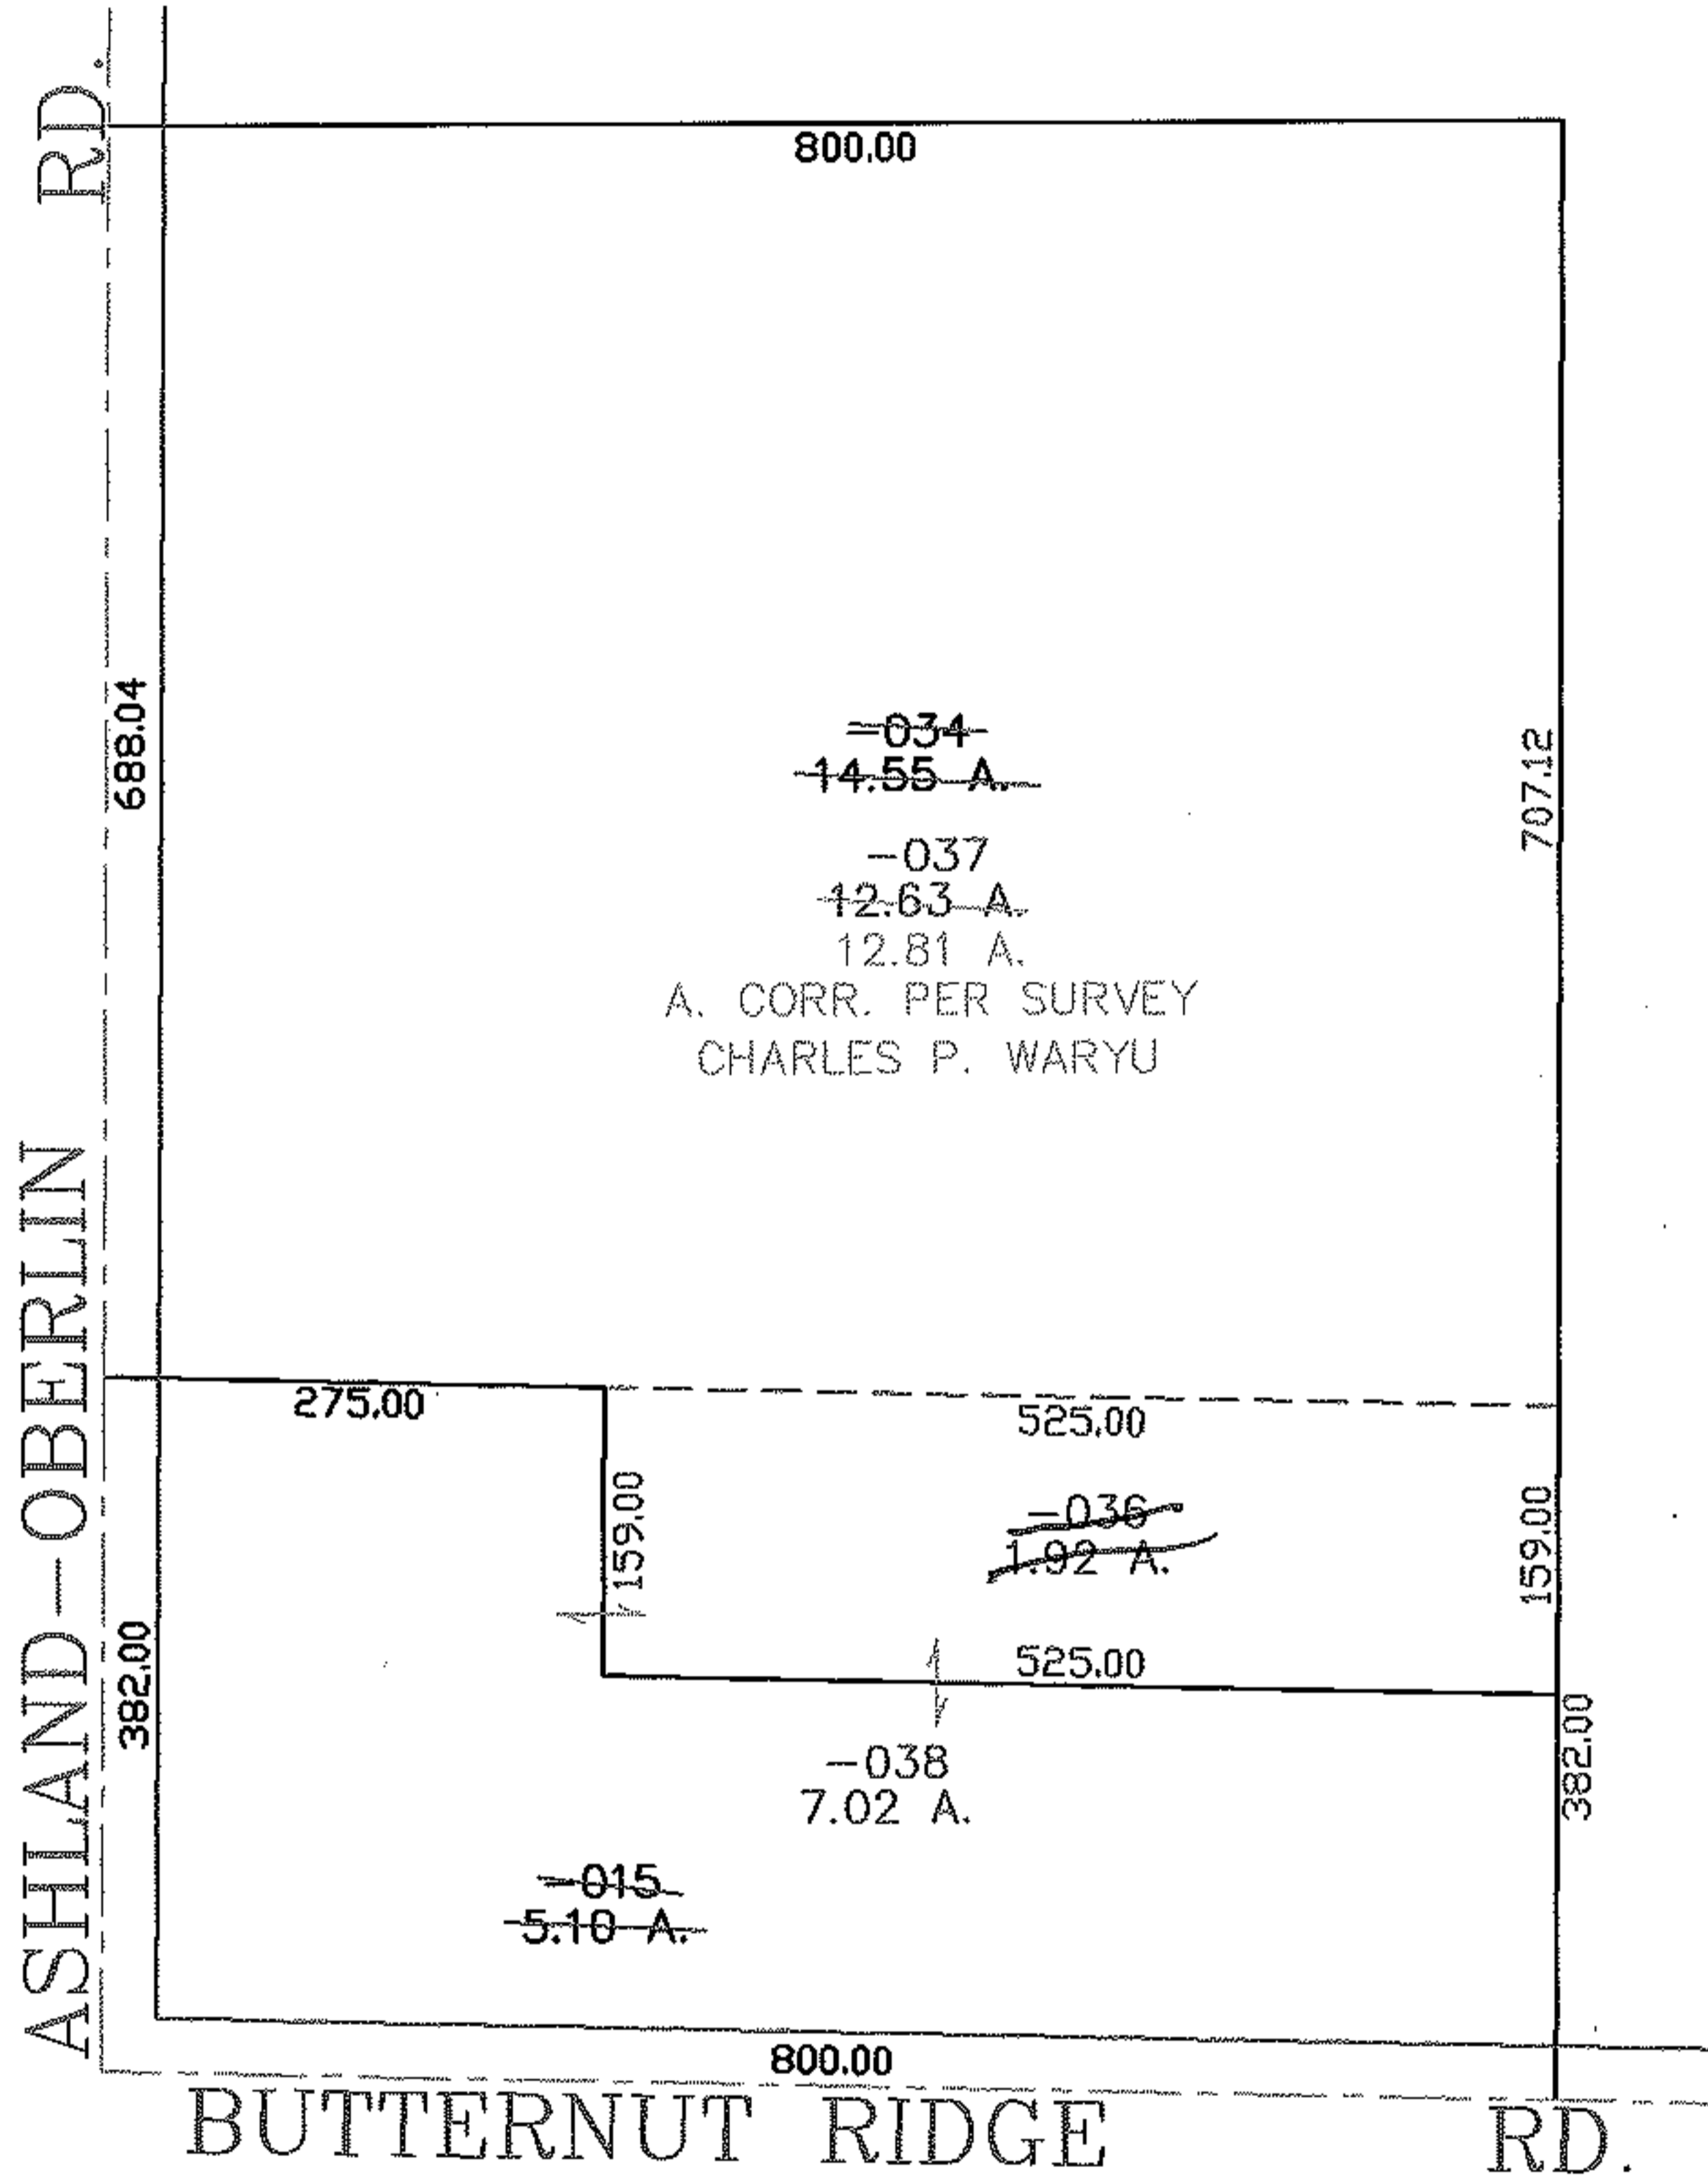


MASTER

PARENT PARCEL: 09-00-056-000-034 & -015
CHILD PARCEL: 09-00-05-000-036 THRU -038
STARTING POINT: CENTERLINE OF BUTTERNUT RIDGE RD. & ASHLAND-OBERLIN RD.

NO. 01514

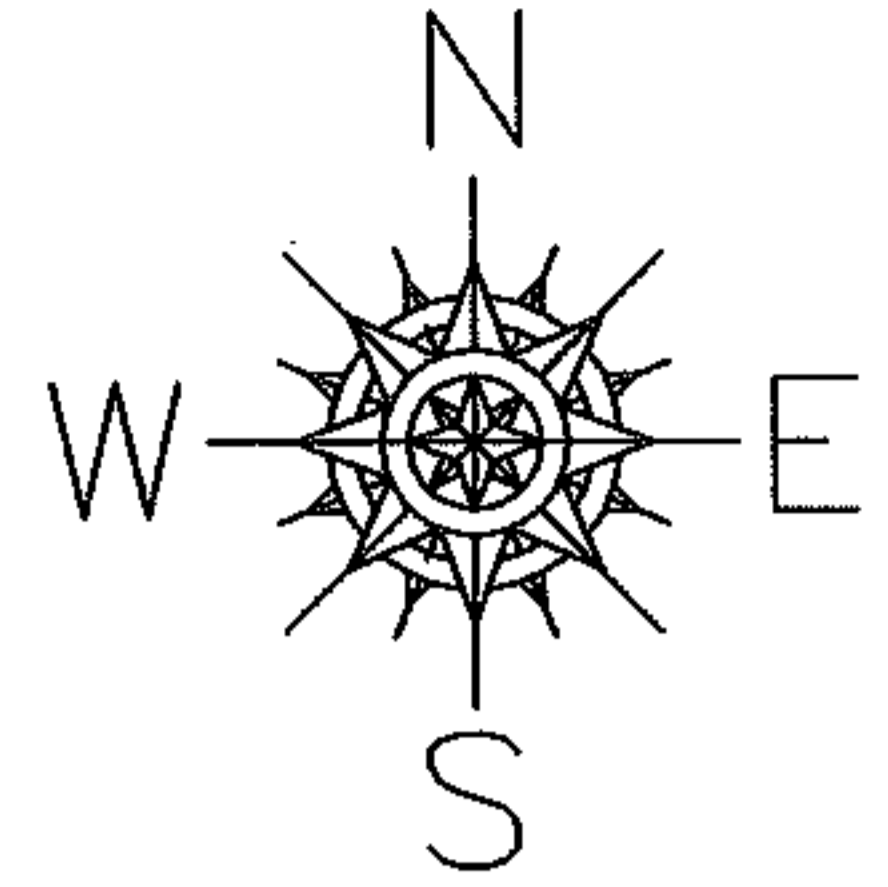

SPLITS/DEEDS PROCESSED
LORAIN COUNTY TAX MAP DEPARTMENT
226 MIDDLE AVE. ELYRIA, OHIO

SURVEYED BY: CHARLES P. WARYU
CLOSURE: 0.00 : 10.000
MAP PAGE(S): 9-G
APPROVED BY: JAH DATE: 11-11-03
SCALE: 1" = 200 PRIOR INSTRUMENT: 19990602295