


# 03-01515

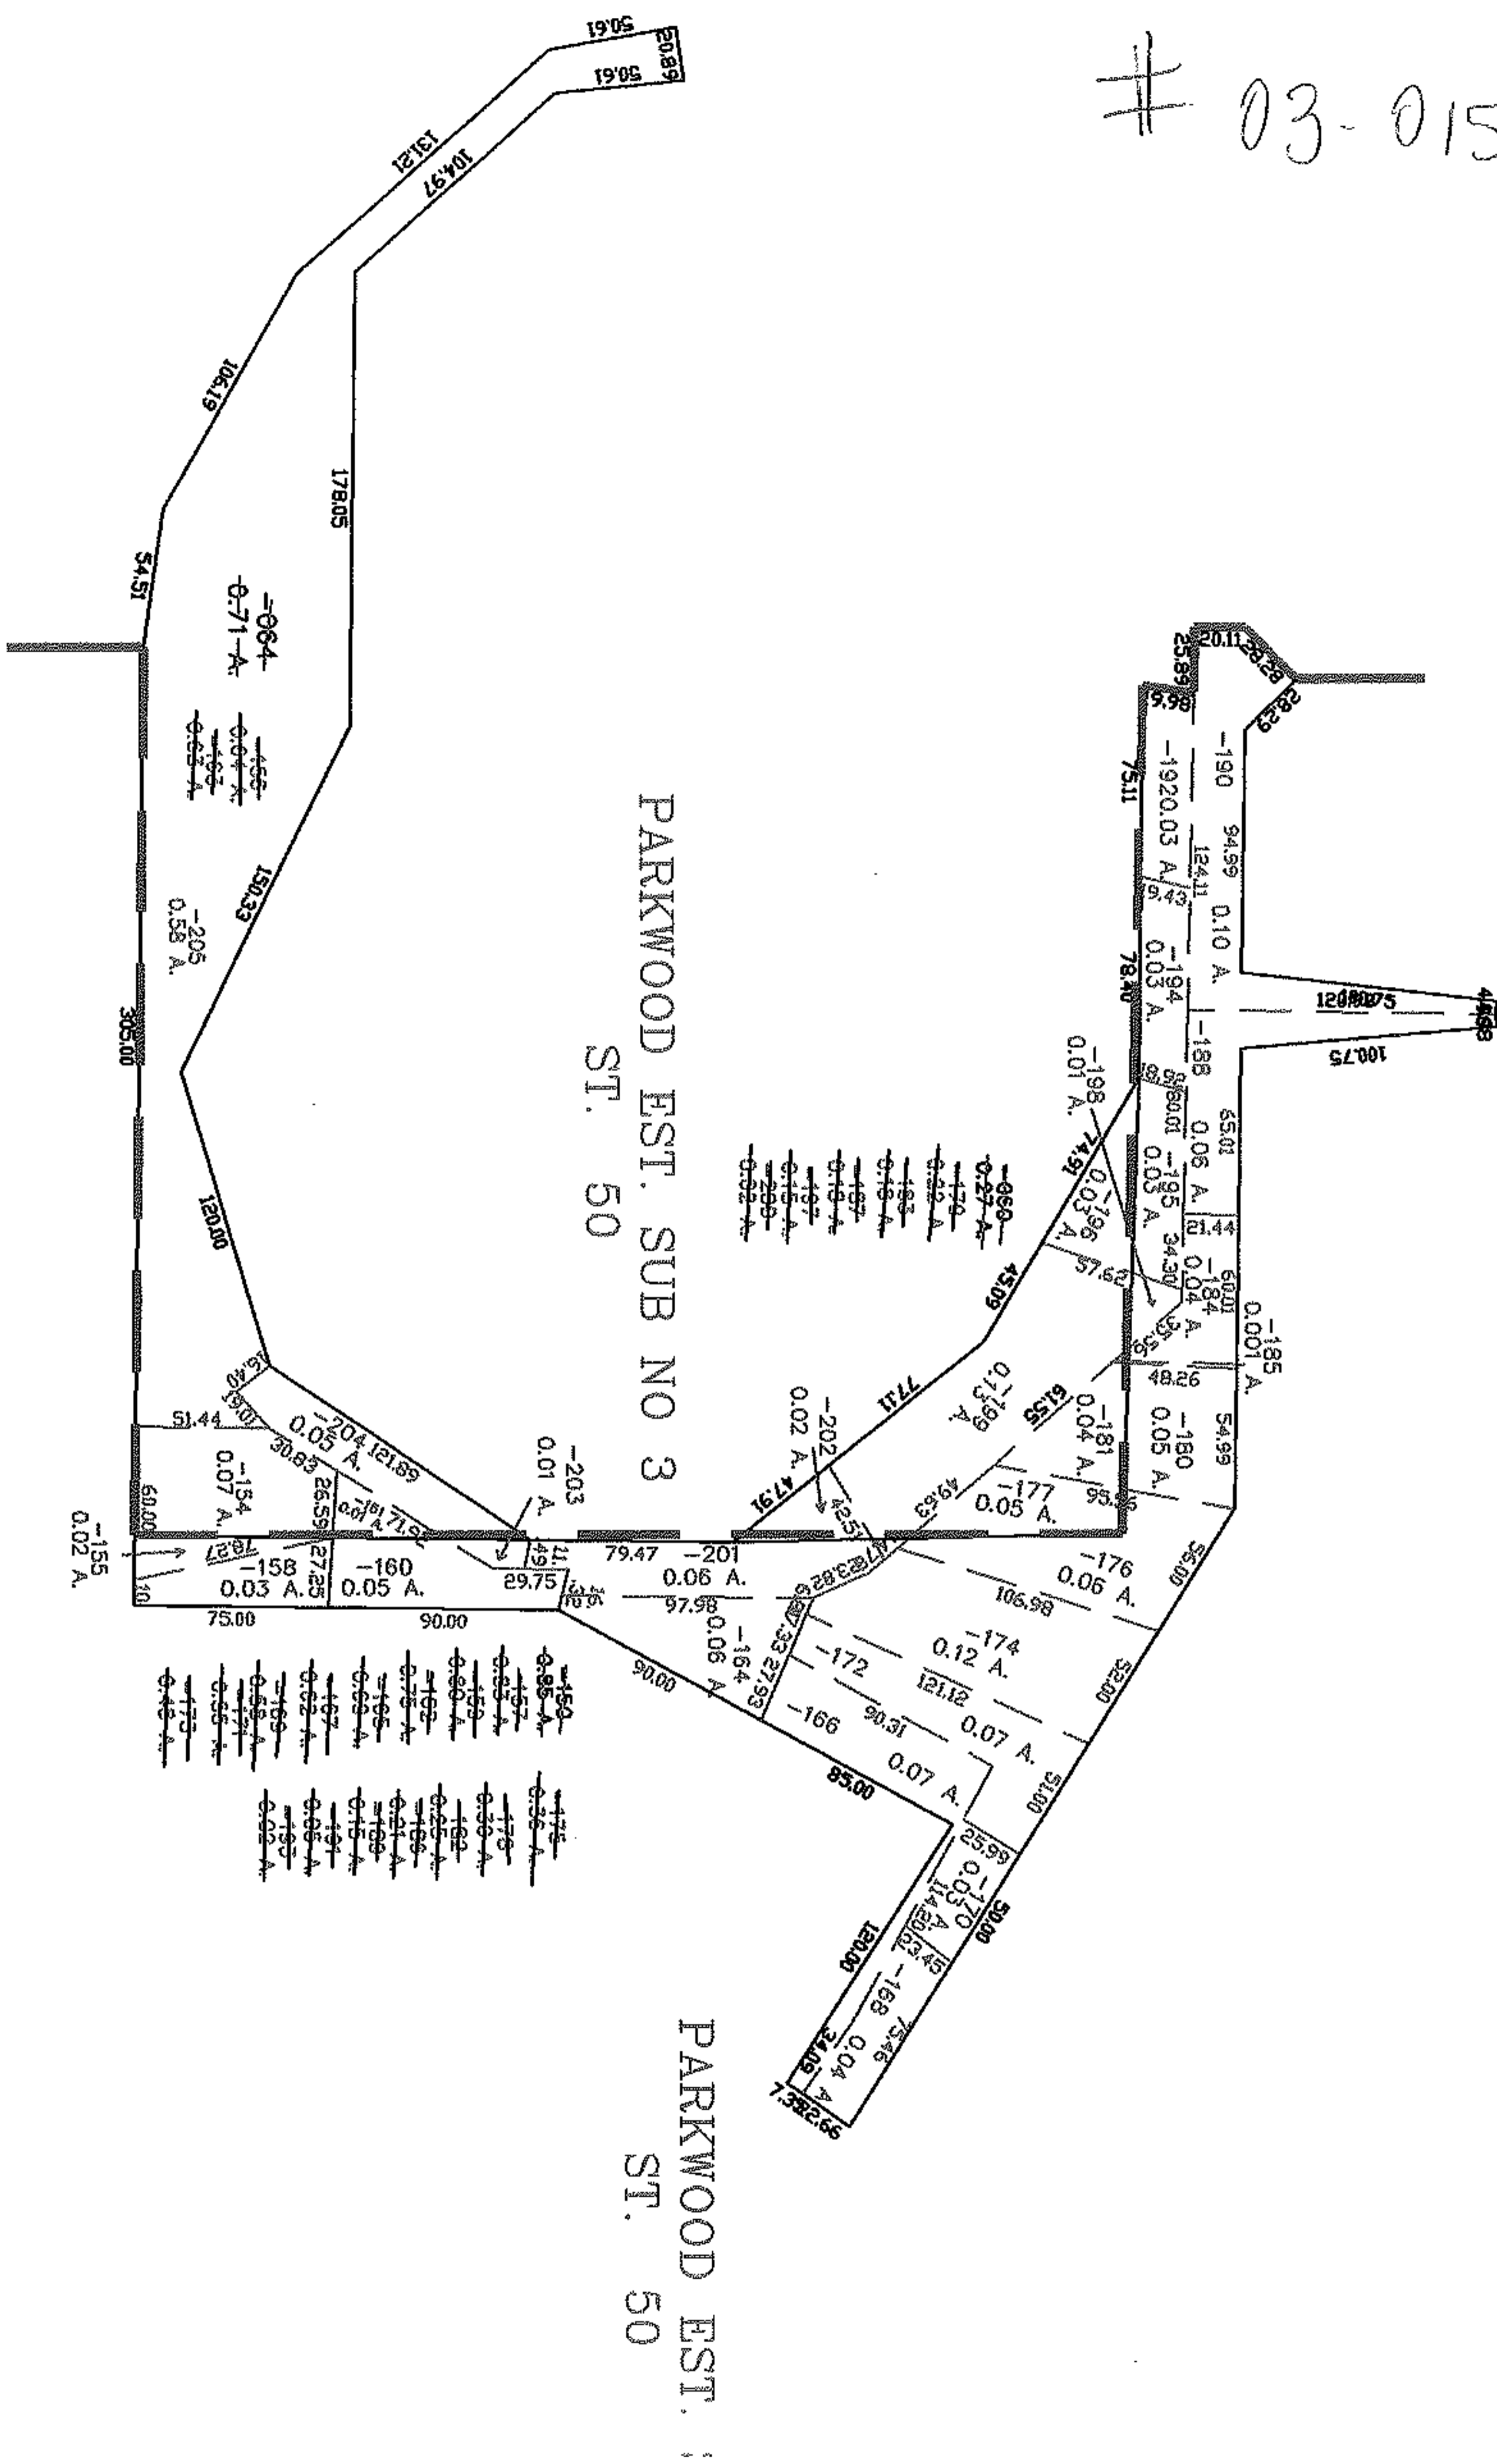

PARKWOOD EST. SUB NO 3  
ST. 50

PARKWOOD EST. ;  
ST. 50