
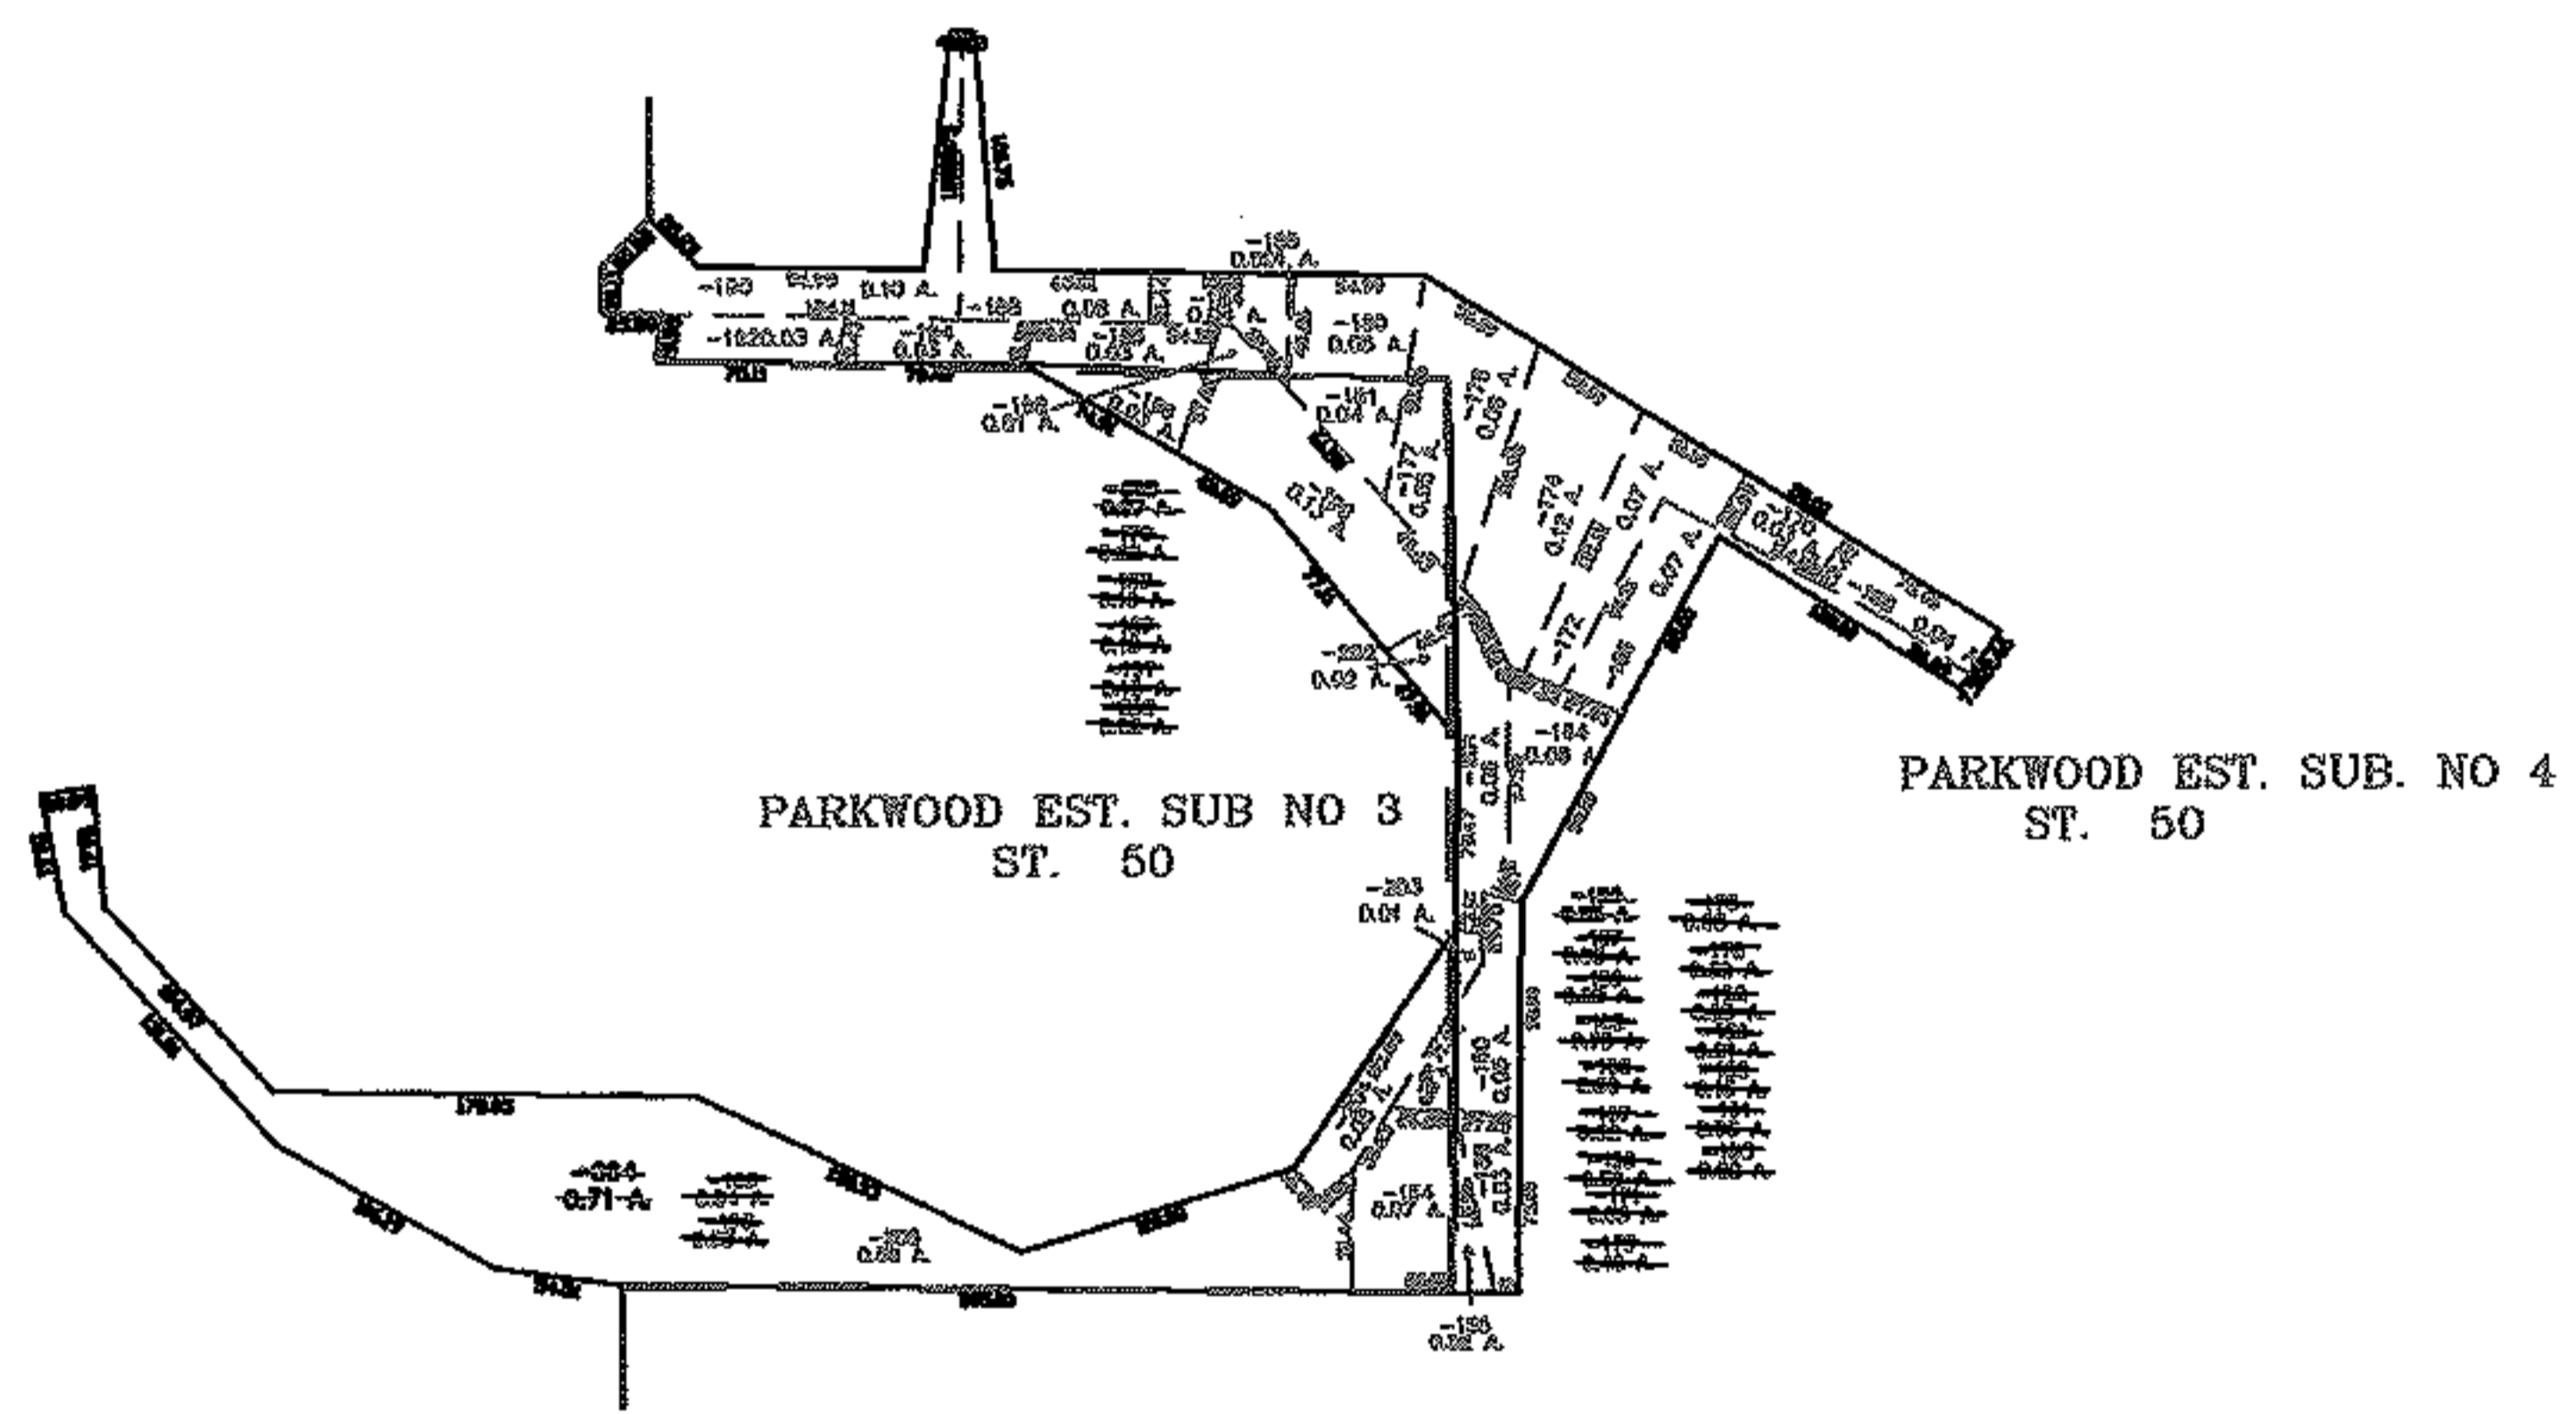


RASTER

PARENT PARCEL: 06-25-002-111-064 & -150  
CHILD PARCEL: 06-25-002-111-154 THRU -205  
STARTING POINT: NORTHWEST CORNER OF S/L 327 OF PARKWOOD EST. SUB. NO. 4

NO. 01515

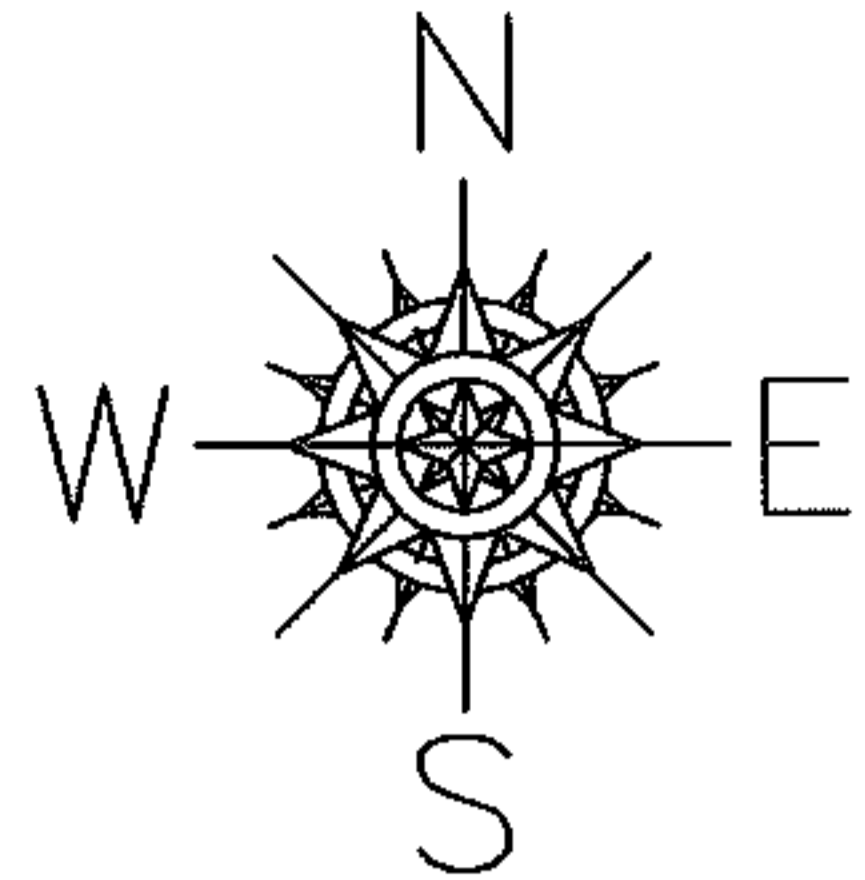

**SPLITS/DEEDS PROCESSED**  
LORAIN COUNTY TAX MAP DEPARTMENT  
226 MIDDLE AVE. ELYRIA, OHIO

SURVEYED BY: ALEX KELSER  
CLOSURE: 0.00 : 10.000  
MAP PAGE(S): 6-141  
APPROVED BY: JAH DATE: 12-3-03  
SCALE: 1" = 200 PRIOR INSTRUMENT: PL VOL 26/50