



RASTER

PARENT PARCEL: 04-00-030-141-178


CHILD PARCEL: 04-00-030-141-188,-189

STARTING POINT: INTERSECTION OF C/L WINDWARD WAY AND C/L OF WALKER RD.

NO. 01520

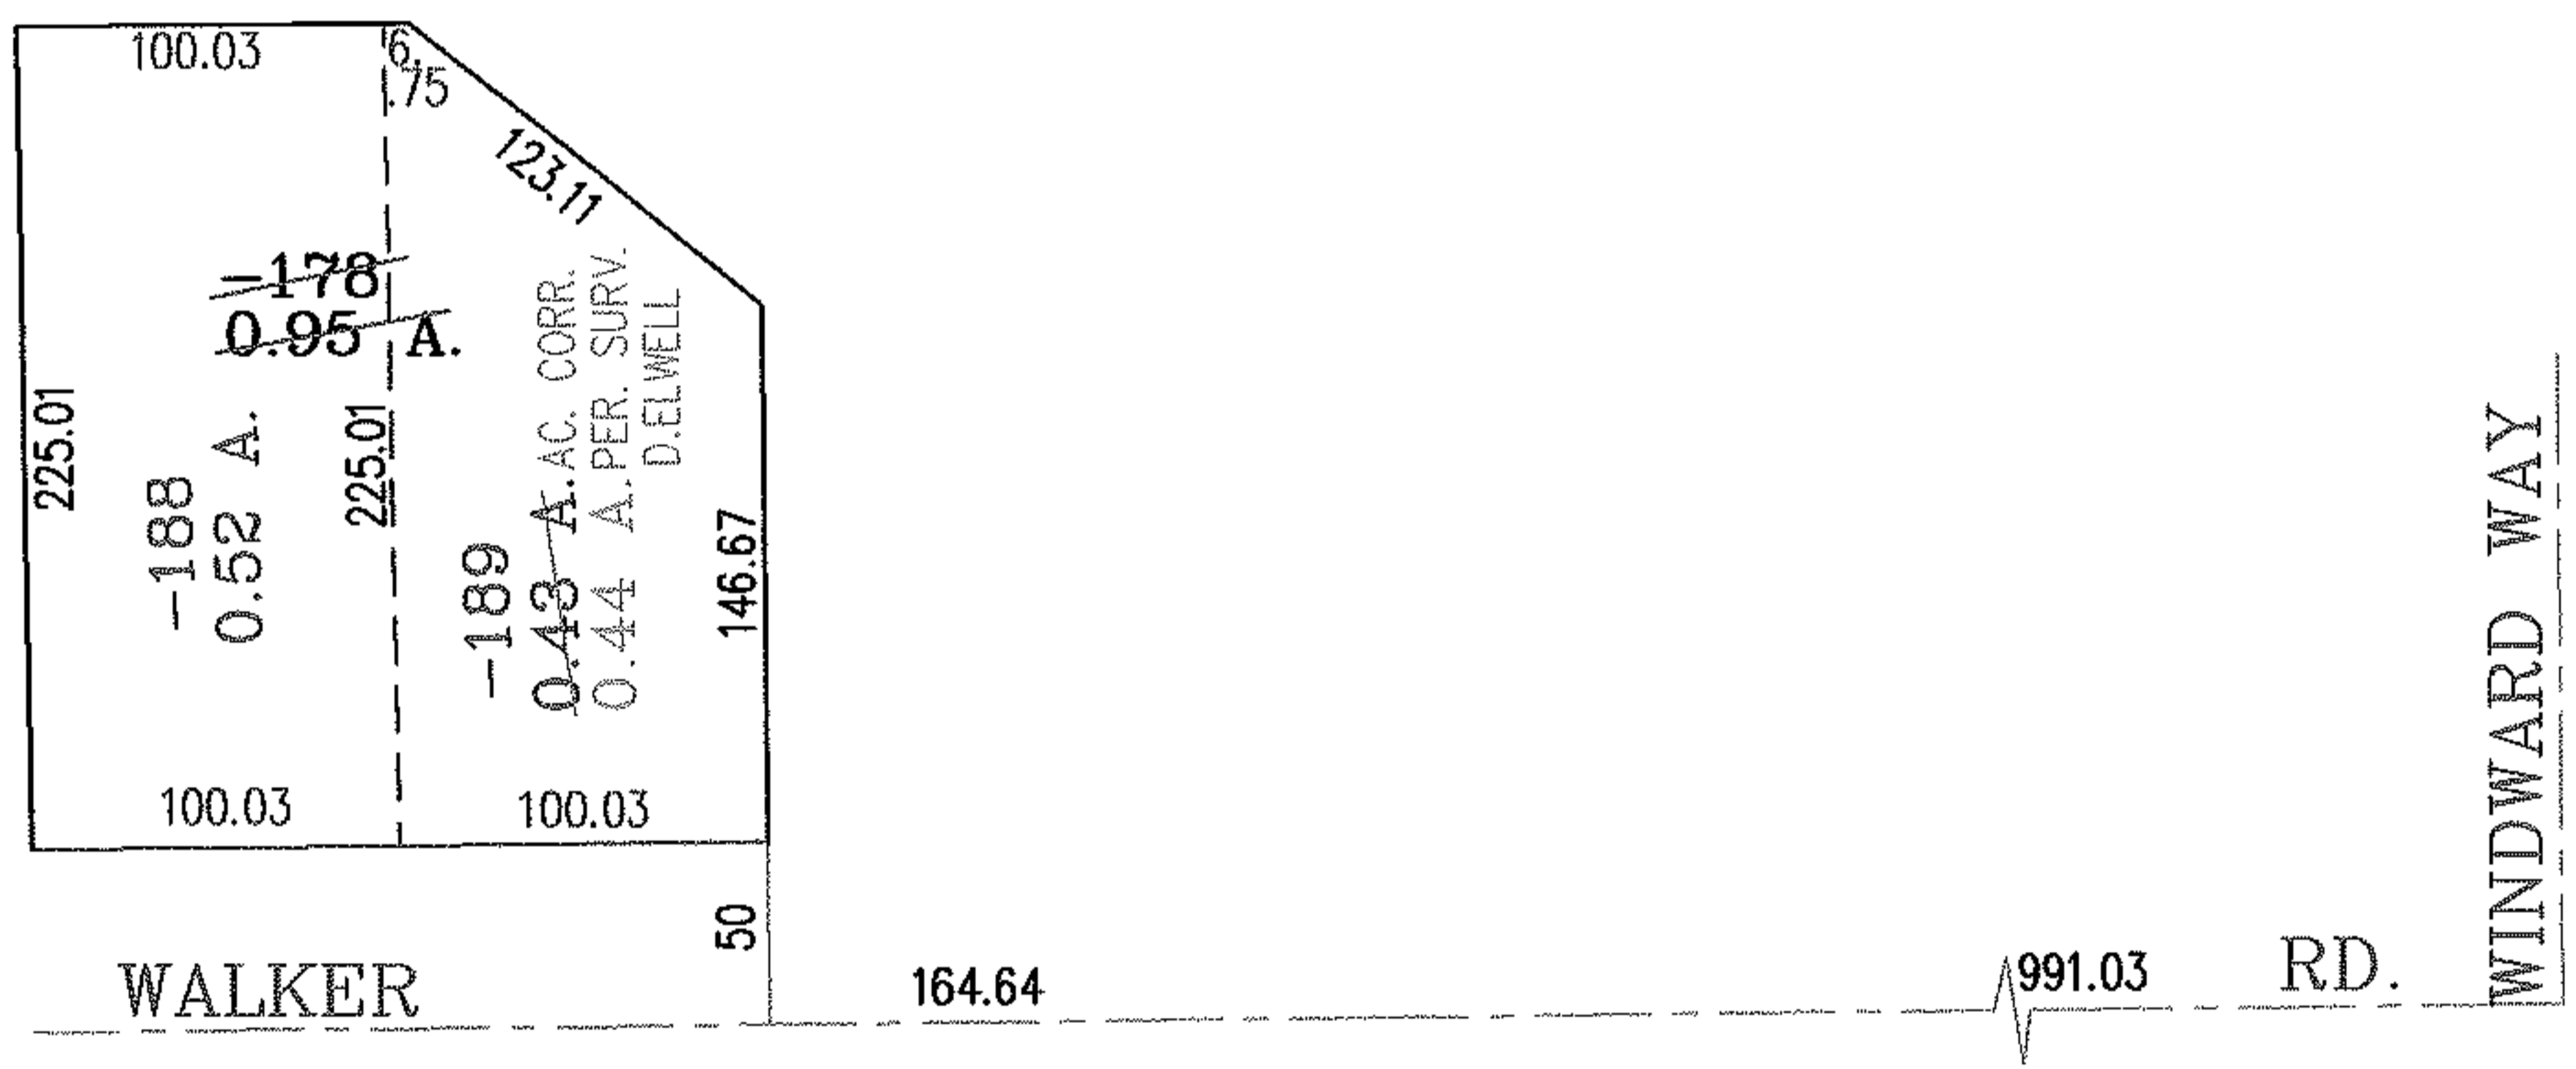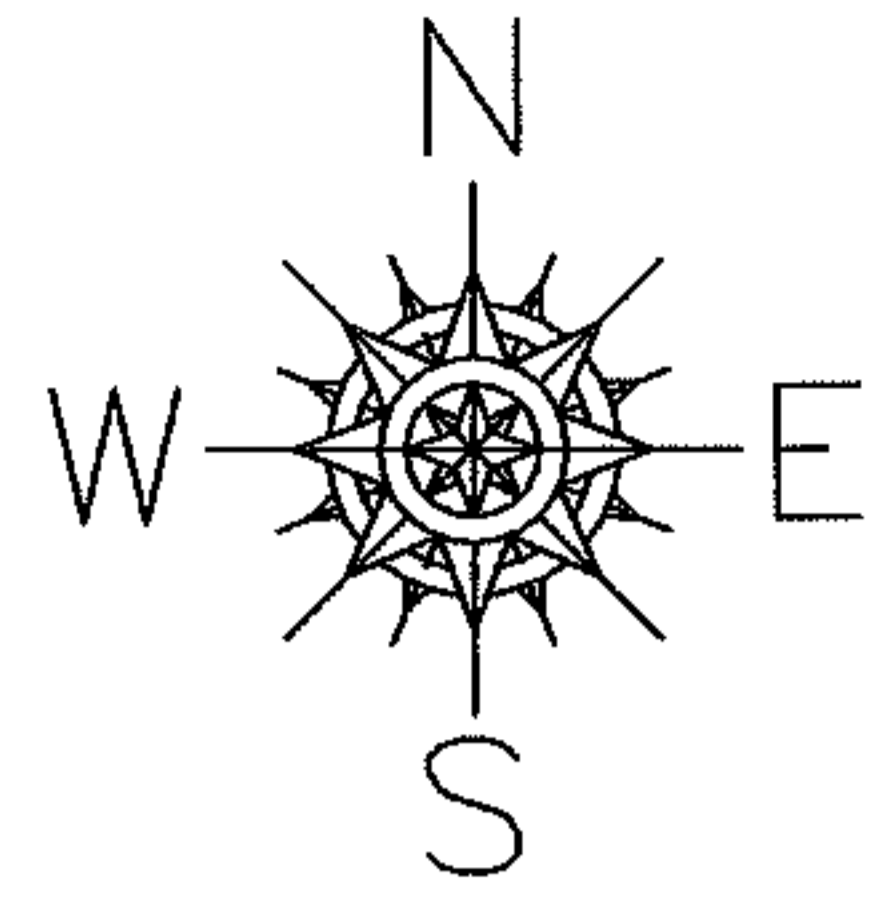

2 OF 4

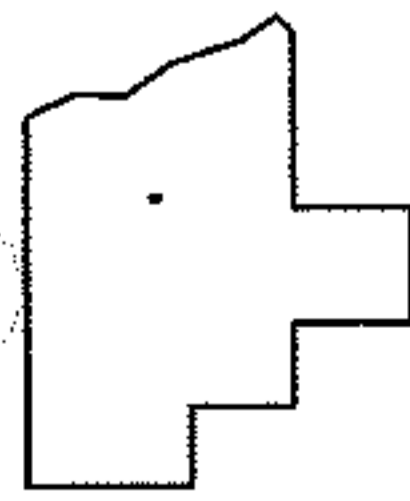

**SPLITS/DEEDS PROCESSED**  
 LORAIN COUNTY TAX MAP DEPARTMENT  
 226 MIDDLE AVE. ELYRIA, OHIO

SURVEYED BY: DAVID L. ELWELL  
 CLOSURE: 01:10,000  
 MAP PAGE(S): 04-00-030-F  
 APPROVED BY: RRM DATE: 11-20-03  
 SCALE: 1" = 100' PRIOR INSTRUMENT: 20000669010