
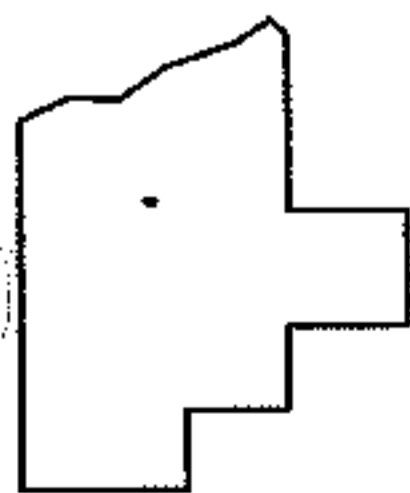
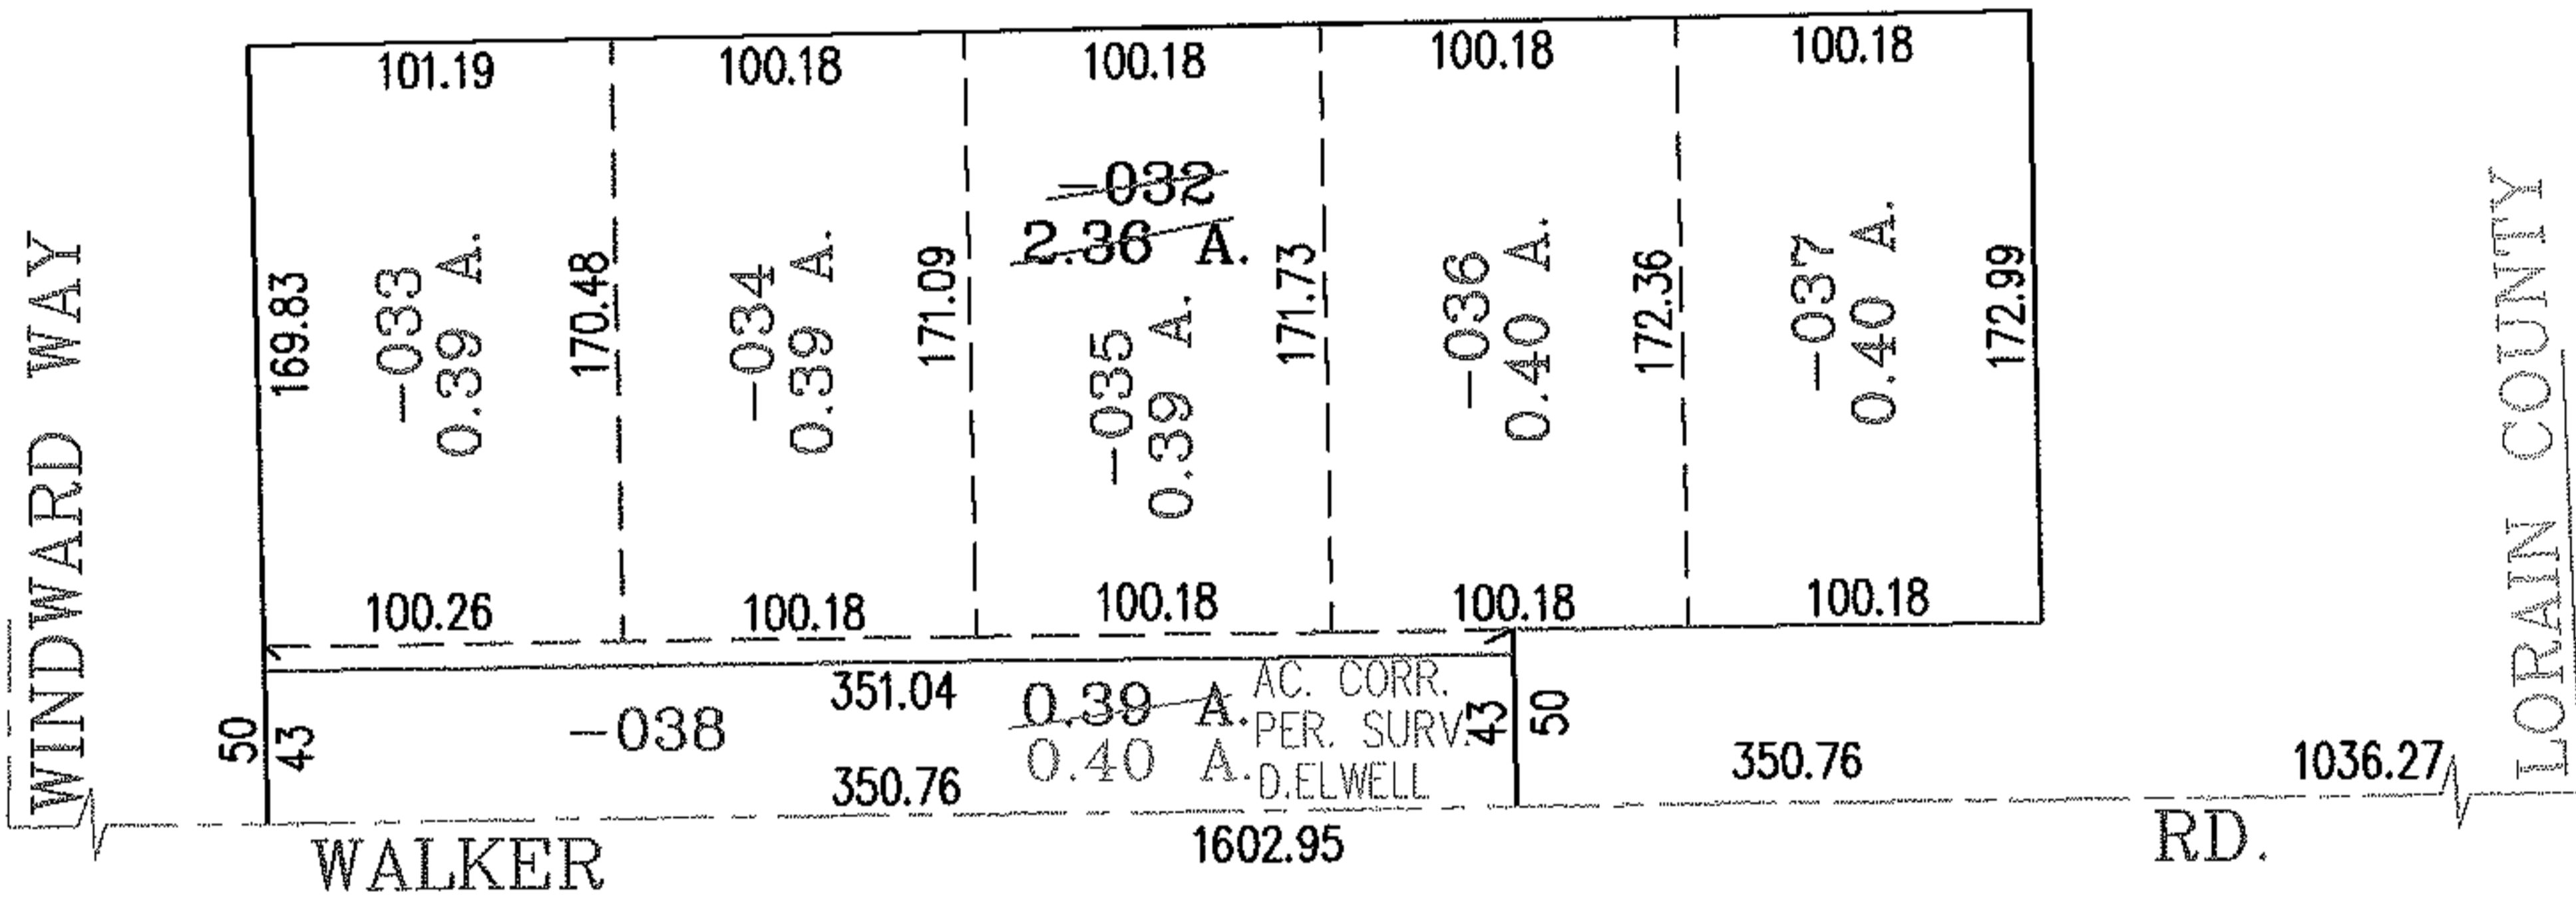


PARENT PARCEL: 04-00-030-153-032

CHILD PARCEL: 04-00-030-153-033 THRU -038

STARTING POINT: INTERSECTION OF C/L OF WINDWARD WAY AND C/L OF WALKER RD.

NO. 01520

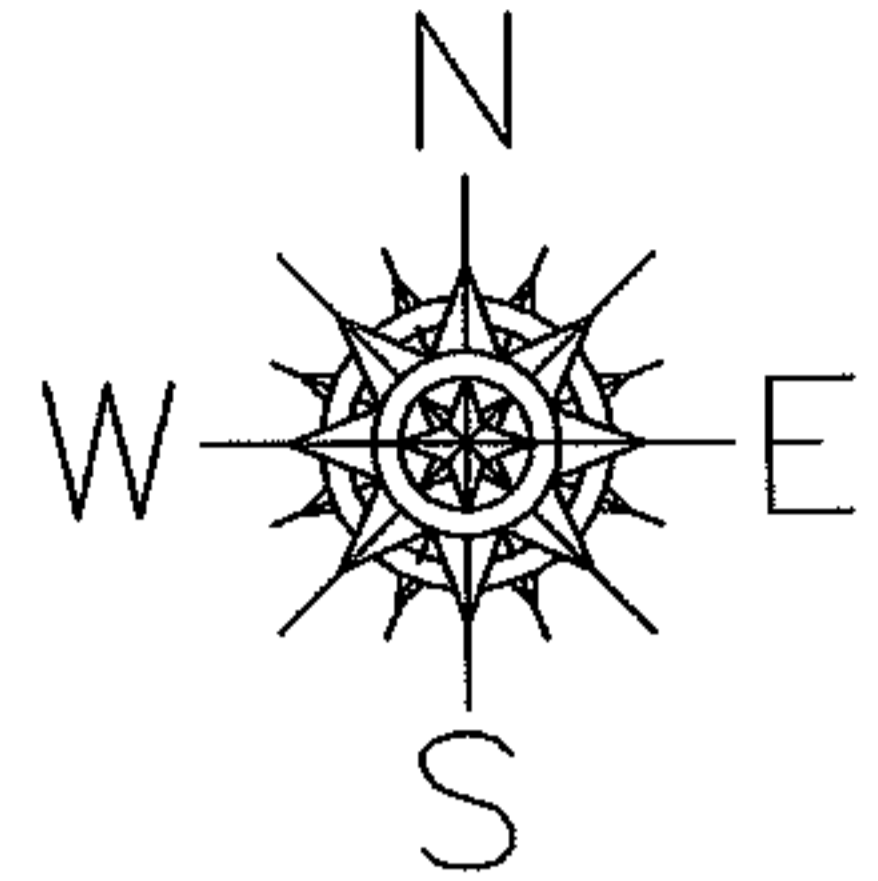

SPLITS/DEEDS PROCESSED
 LORAIN COUNTY TAX MAP DEPARTMENT
 226 MIDDLE AVE. ELYRIA, OHIO

SURVEYED BY: DAVID L. ELWELL
 CLOSURE: .01:10.000
 MAP PAGE(S): 04-00-030-H
 APPROVED BY: RRM DATE: 11-20-03
 SCALE: 1" = 100' PRIOR INSTRUMENT: OR.82/466 OR.94/561