




RASTER

PARENT PARCEL: 04-00-010-114-027

CHILD PARCEL: 04-00-010-114-043 THRU -045

STARTING POINT: INTERSECTION OF C/L OF FRENCH CREEK DR. AND C/L OF DETROIT RD.

NO. 01530

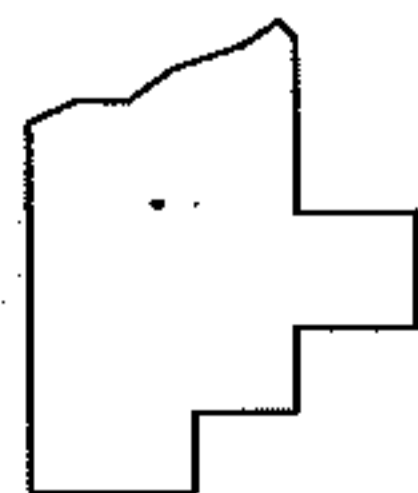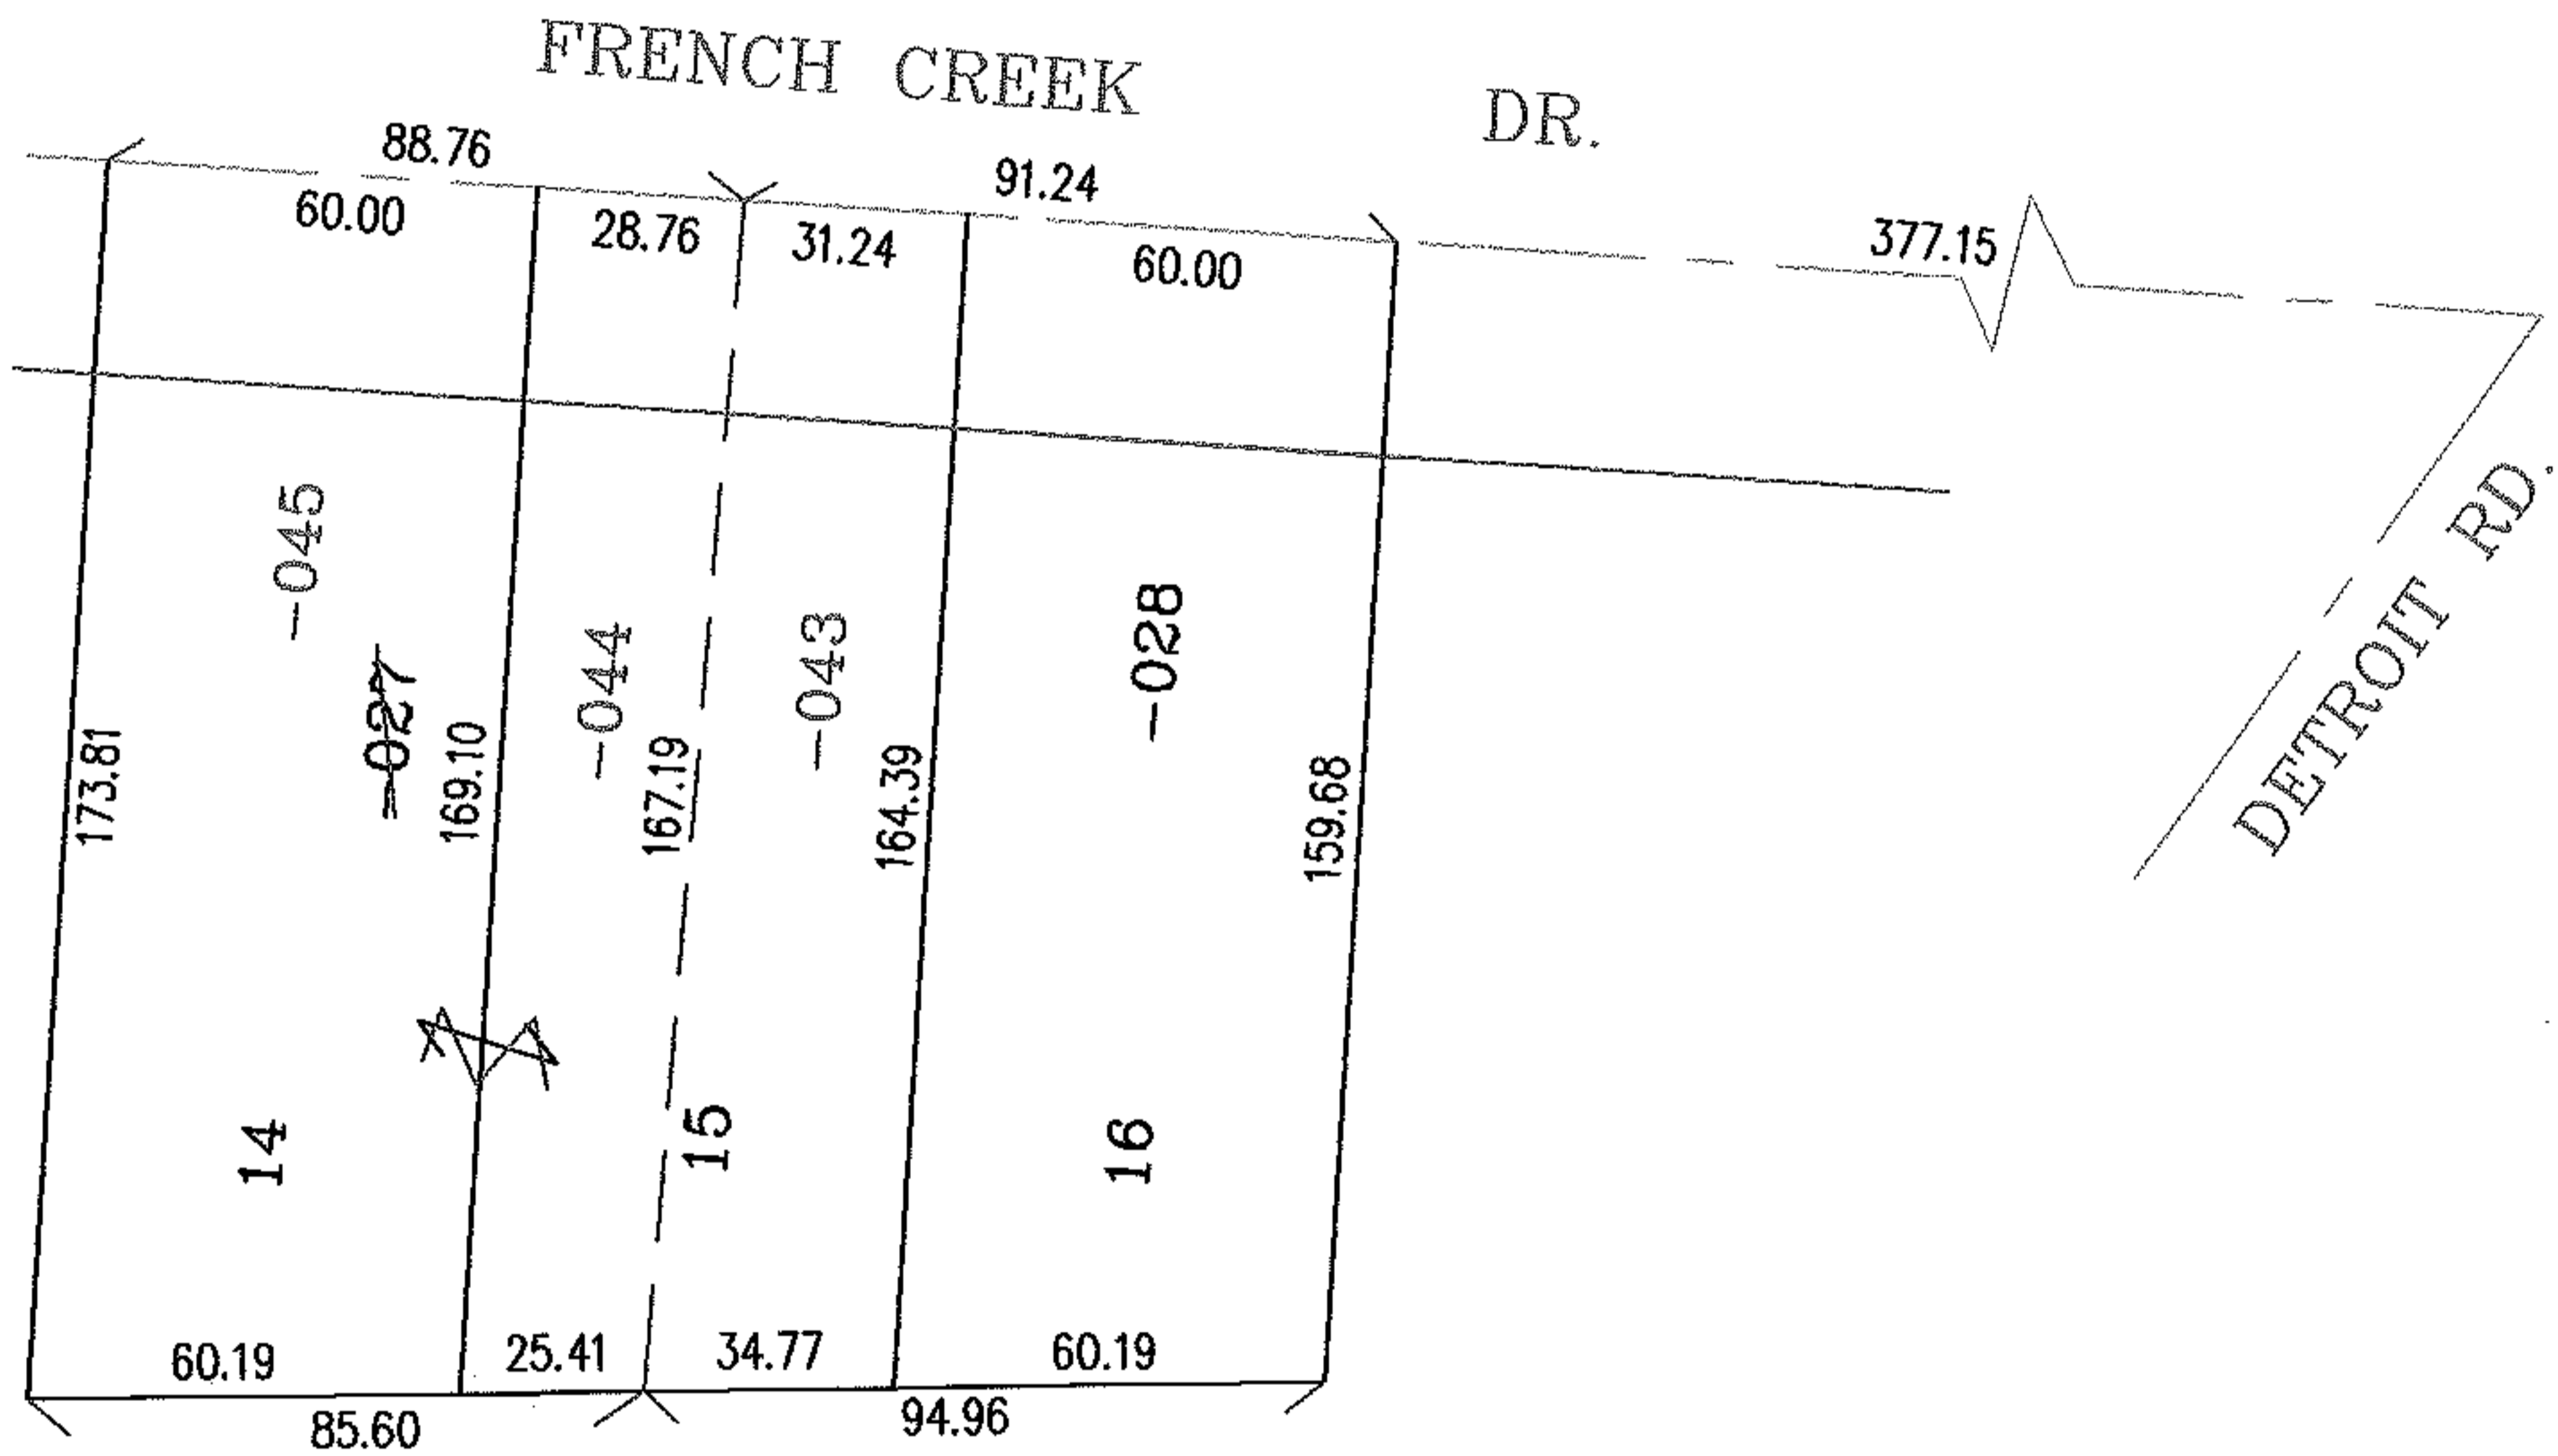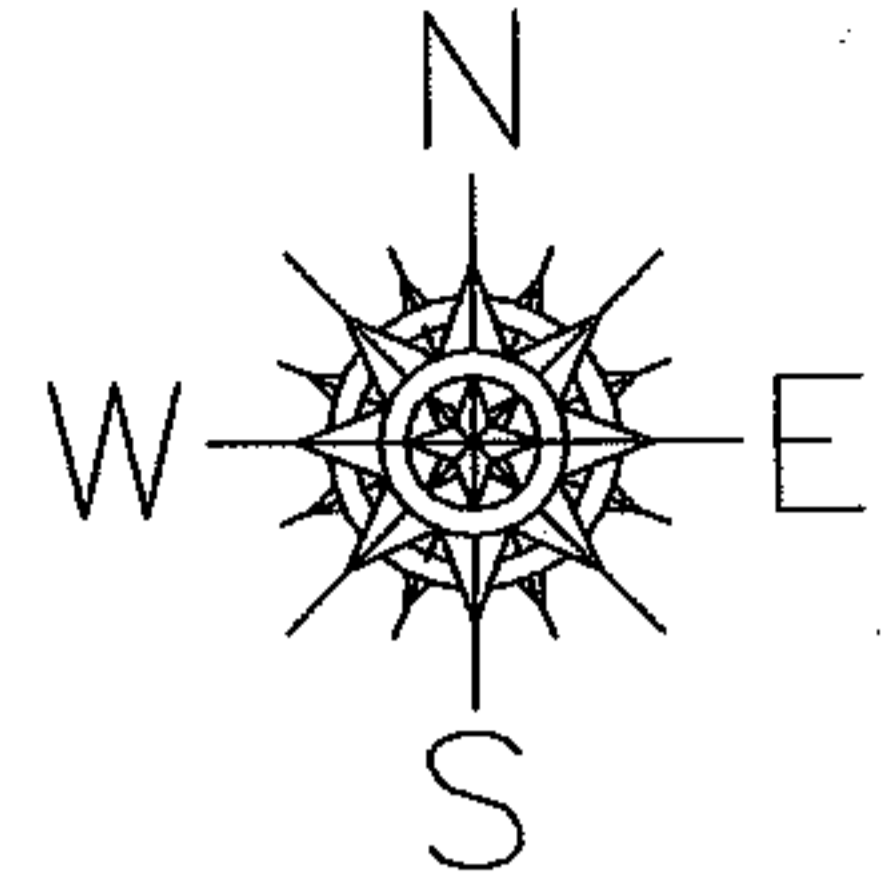

SPLITS/DEEDS PROCESSED

LORAIN COUNTY TAX MAP DEPARTMENT
226 MIDDLE AVE. ELYRIA, OHIO

SURVEYED BY: JAMES A. RESAR
 CLOSURE: .01:10,000
 MAP PAGE(S): 4-00-010-F
 APPROVED BY: RRM DATE: 12-30-03
 SCALE: 1" = 100' PRIOR INSTRUMENT: DV 1091/714