
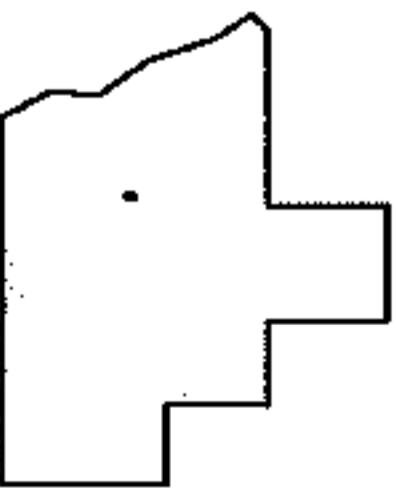
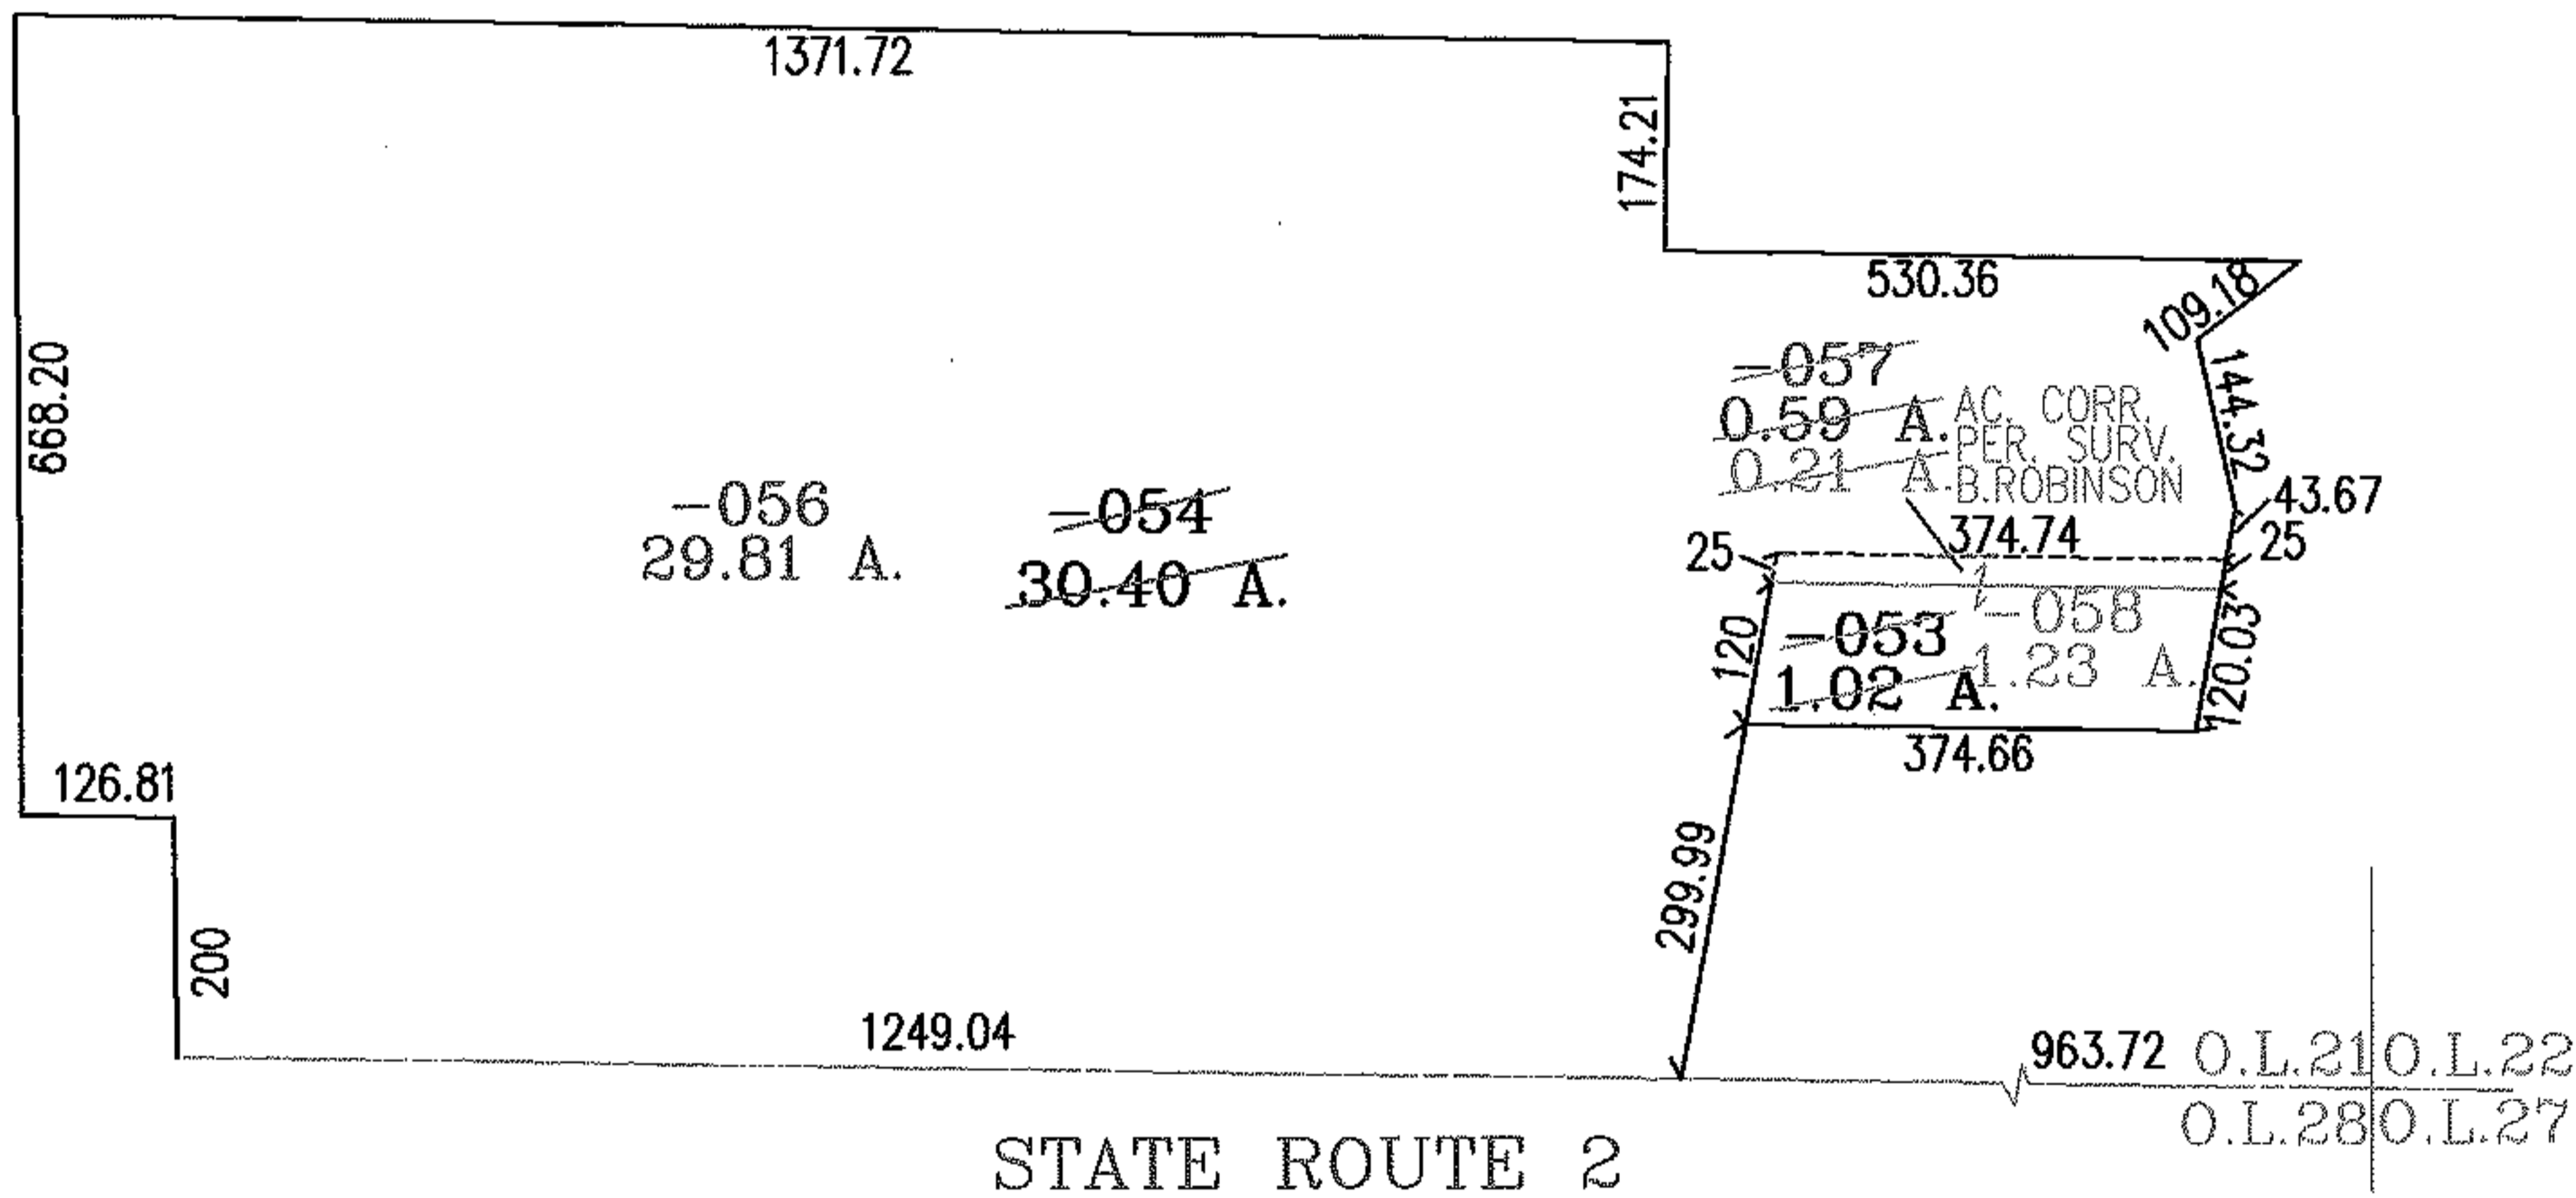


PARENT PARCEL: 01-00-021-000-053,-054

CHILD PARCEL: 01-00-021-000-056 thru -058

STARTING POINT: SOUTHEAST CORNER OF O.L.21

NO. 01545

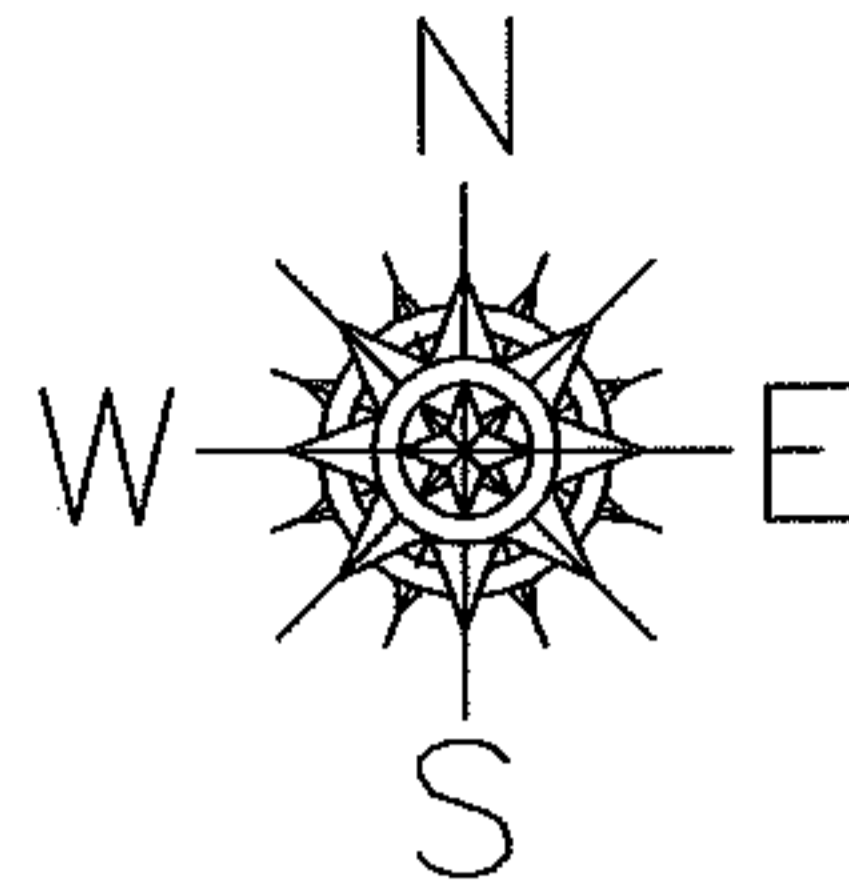

**SPLITS/DEEDS PROCESSED**  
 LORAIN COUNTY TAX MAP DEPARTMENT  
 226 MIDDLE AVE. ELYRIA, OHIO

SURVEYED BY: BRUCE L. ROBINSON  
 CLOSURE: .02:10,000  
 MAP PAGE(S): 01-00-021-A&B  
 APPROVED BY: RRM DATE: 12-19-03  
 SCALE: 1" = 300 PRIOR INSTRUMENT: 970509814