
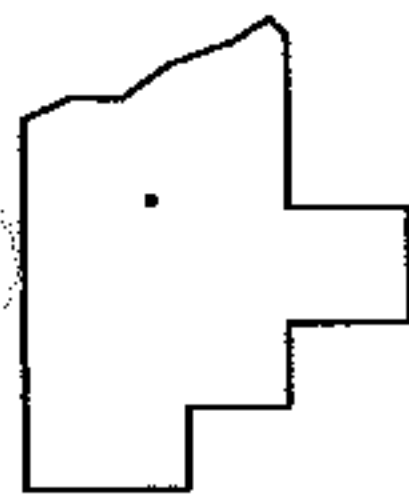
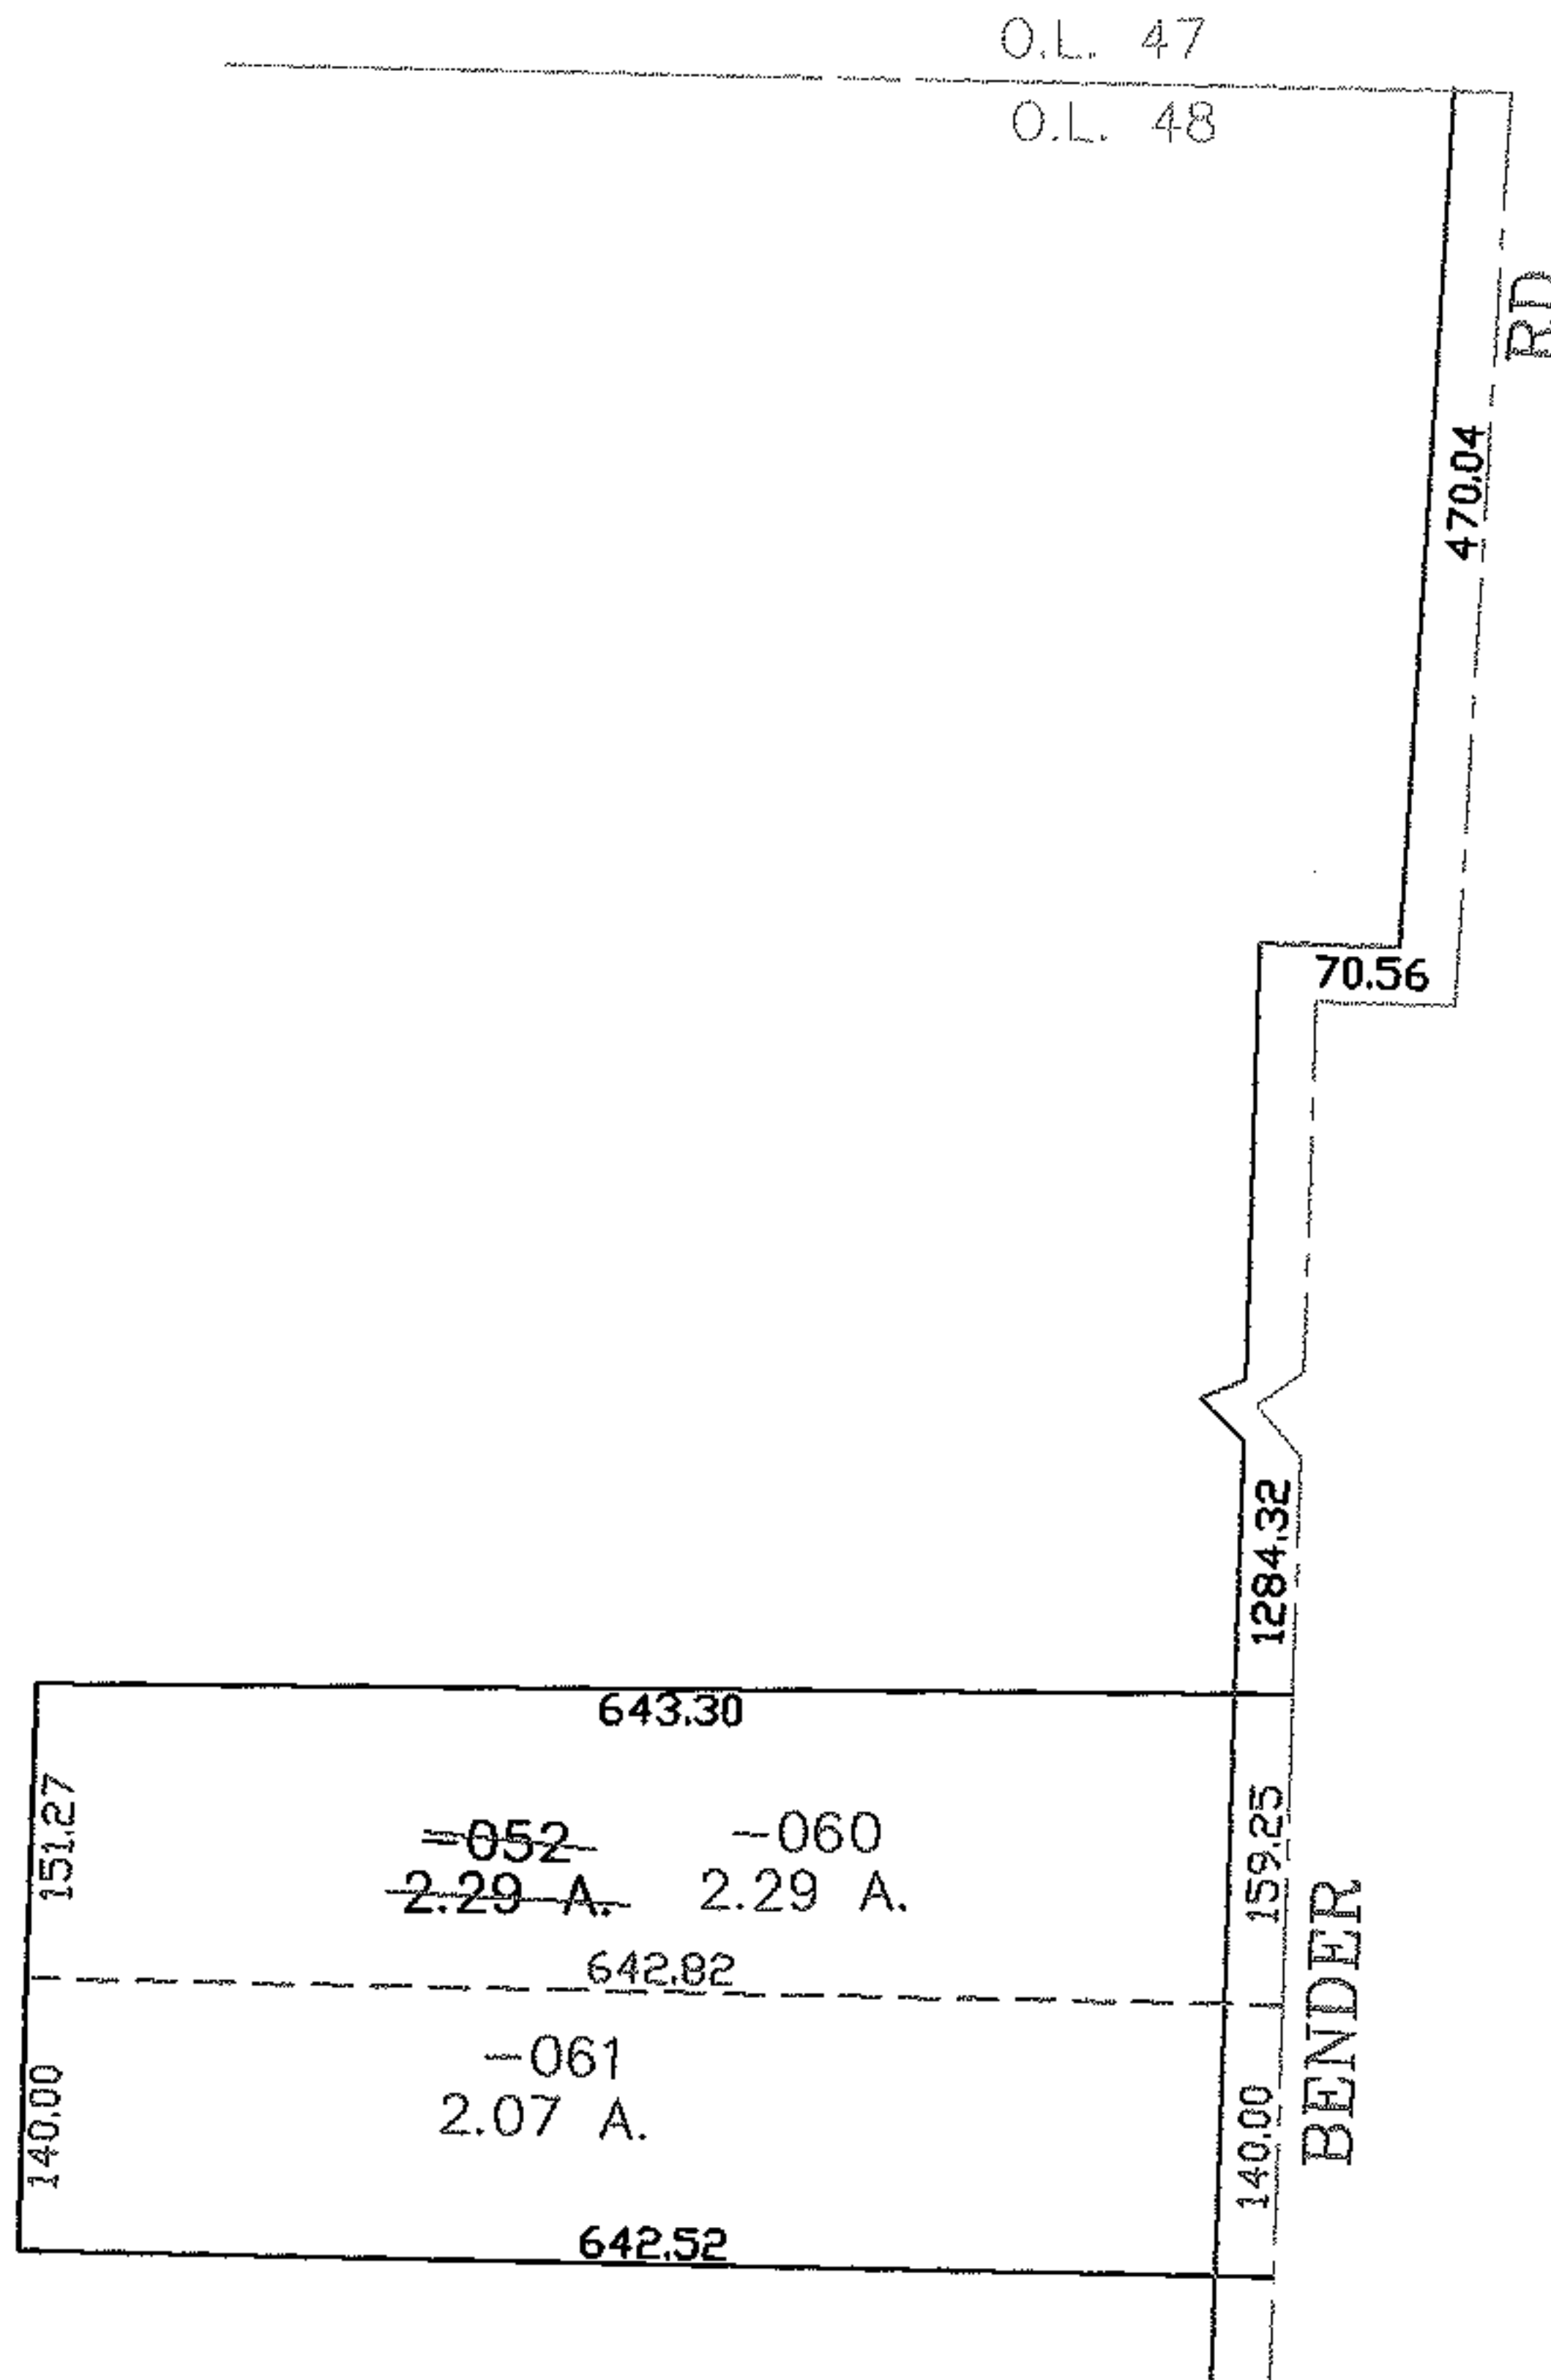


PARENT PARCEL: 07-00-048-000-052

CHILD PARCEL: 07-00-048-000-060, -061

STARTING POINT: CENTERLINE OF BENDER RD. & O.L. 48

NO. 01548

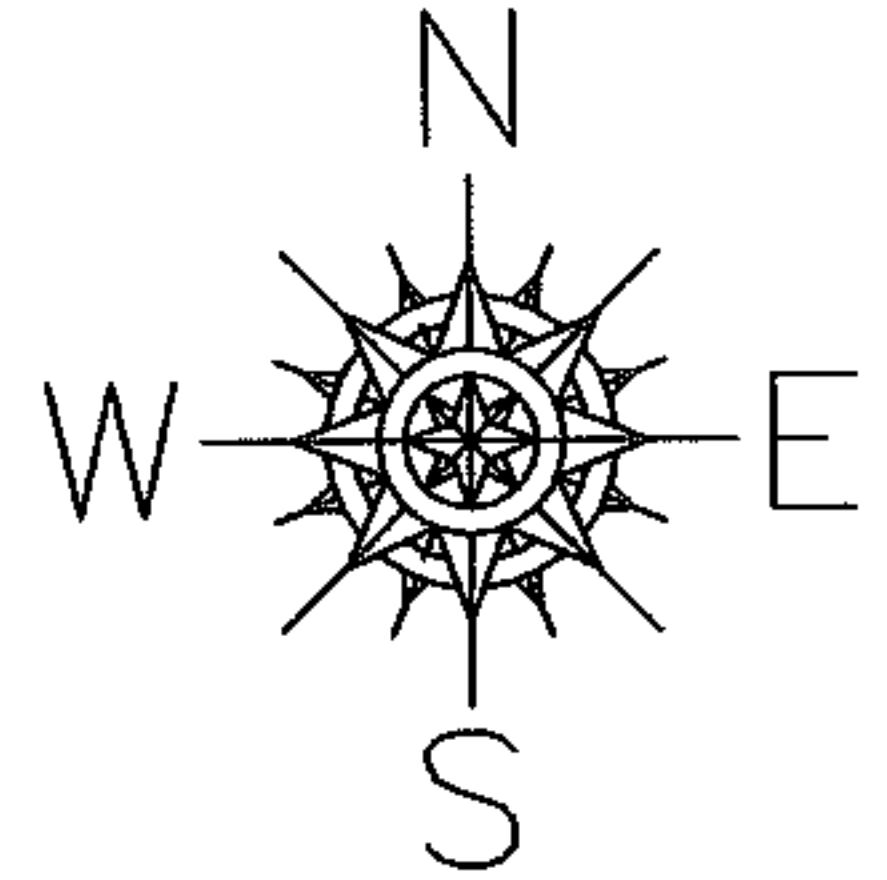

**SPLITS/DEEDS PROCESSED**  
 LORAIN COUNTY TAX MAP DEPARTMENT  
 226 MIDDLE AVE. ELYRIA, OHIO

SURVEYED BY: THOMAS A. SIMON  
 CLOSURE: 0.00 : 10,000  
 MAP PAGE(S): 7-E  
 APPROVED BY: JAH DATE: 12-16-03  
 SCALE: 1" = 200 PRIOR INSTRUMENT: 20030881030