
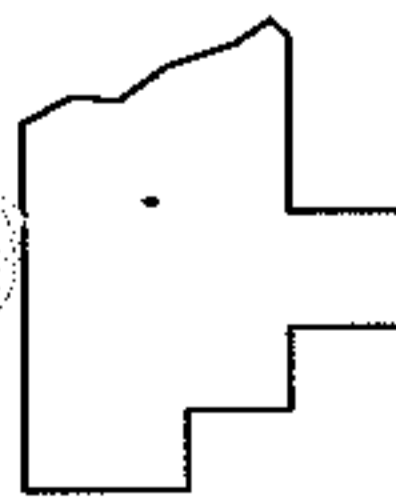
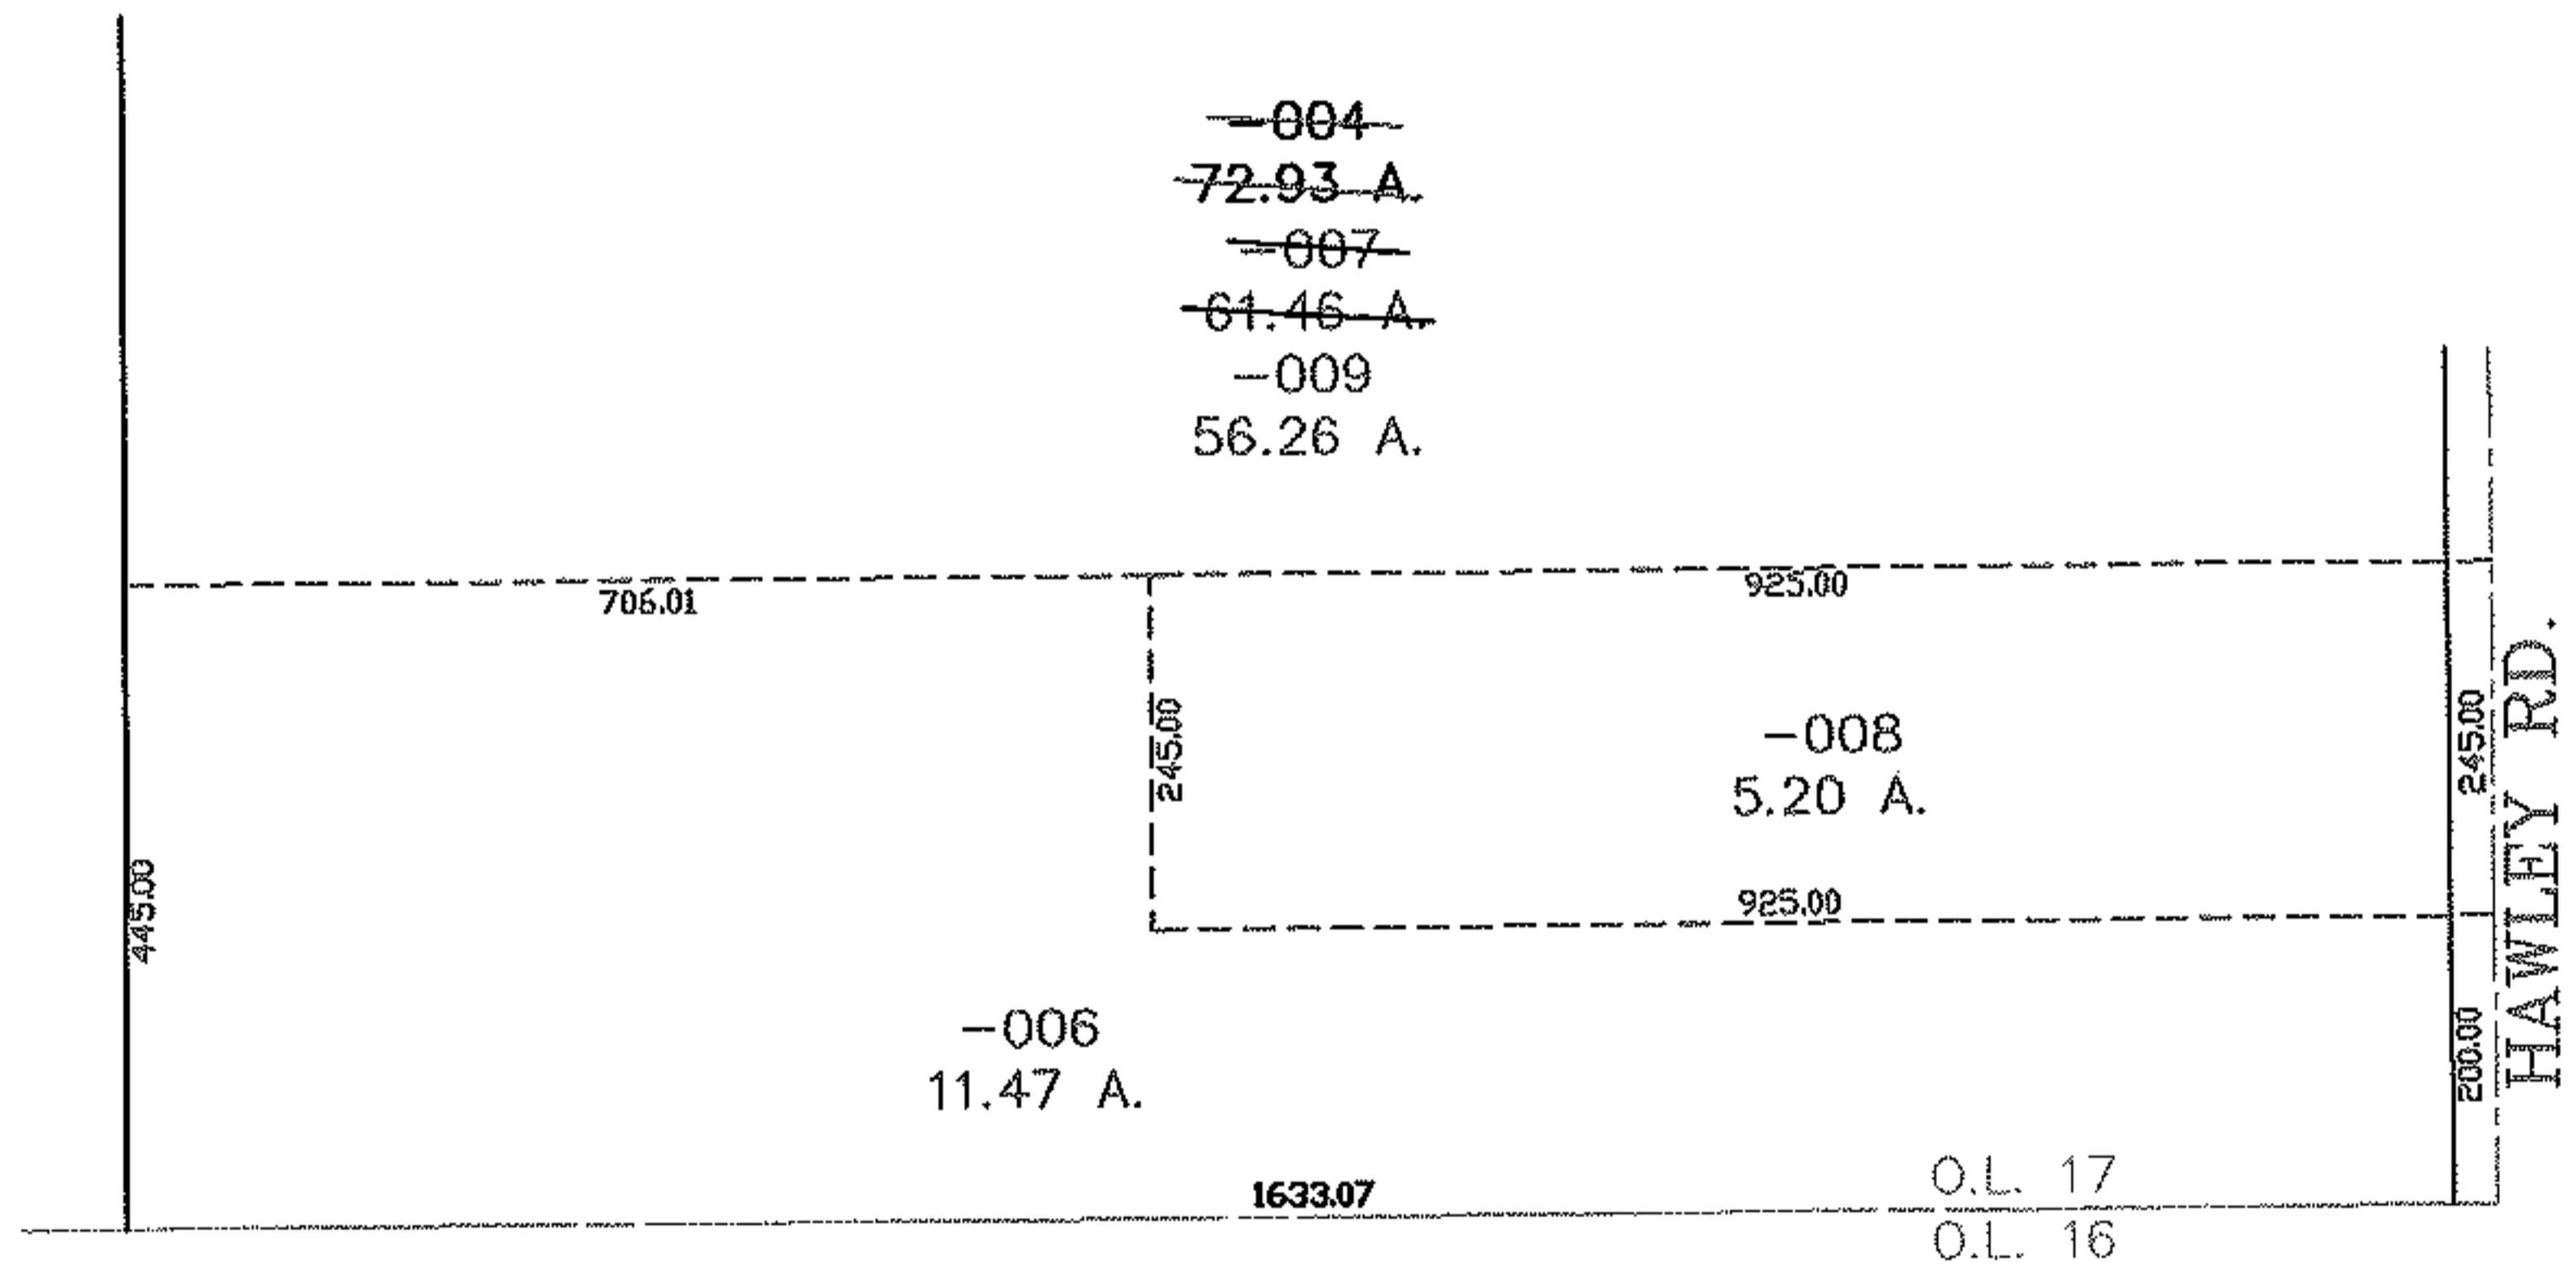


PARENT PARCEL: 18-00-017-000-004  
CHILD PARCEL: 18-00-017-000-006 THRU -009  
STARTING POINT: CENTERLINE OF HAWLEY RD. & O.L. 17

NO. 01549

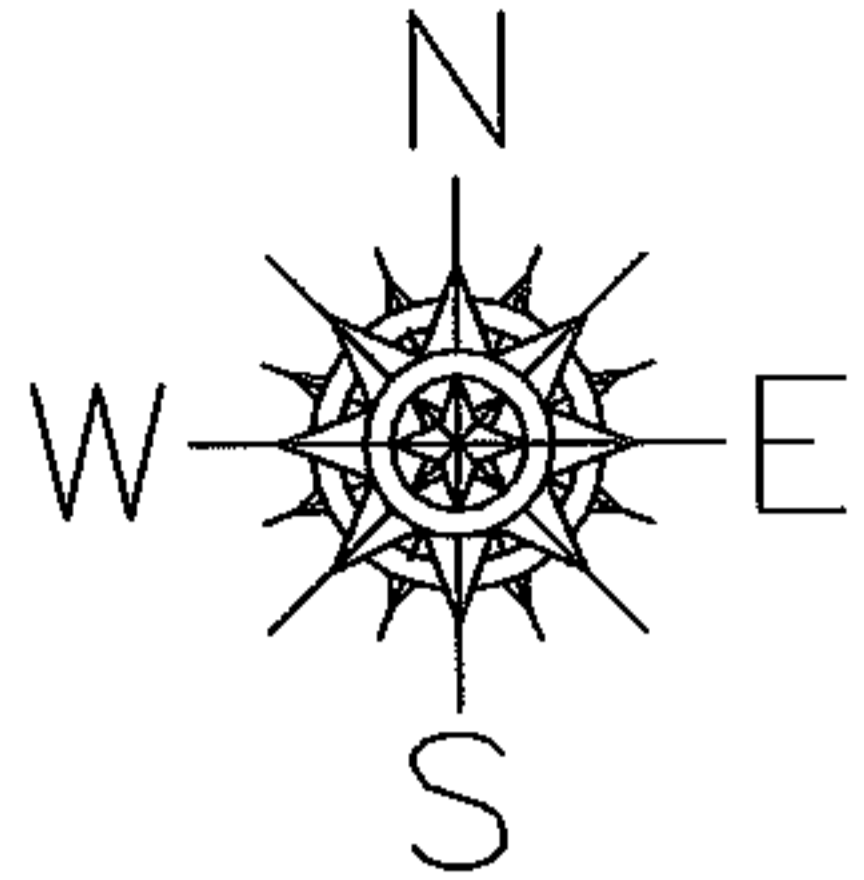

**SPLITS/DEEDS PROCESSED**  
LORAIN COUNTY TAX MAP DEPARTMENT  
226 MIDDLE AVE. ELYRIA, OHIO

SURVEYED BY: RICHARD D. CARLSON  
CLOSURE: 0.00 : 10.000  
MAP PAGE(S): 18-C  
APPROVED BY: JAH DATE: 12-16-03  
SCALE: 1" = 300 PRIOR INSTRUMENT: DV 1276/617