




RASTER

PARENT PARCEL: 11-00-083-000-012, 11-00-084-000-074

CHILD PARCEL: 11-00-084-000-075 THRU -077 11-00-083-000-026, -027

STARTING POINT: CENTERLINE OF CAPEL RD. & DURKEE RD.

NO. 01550

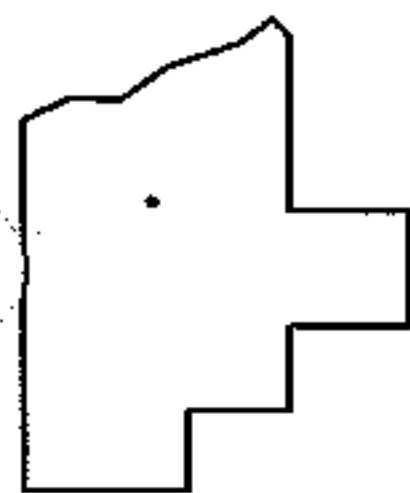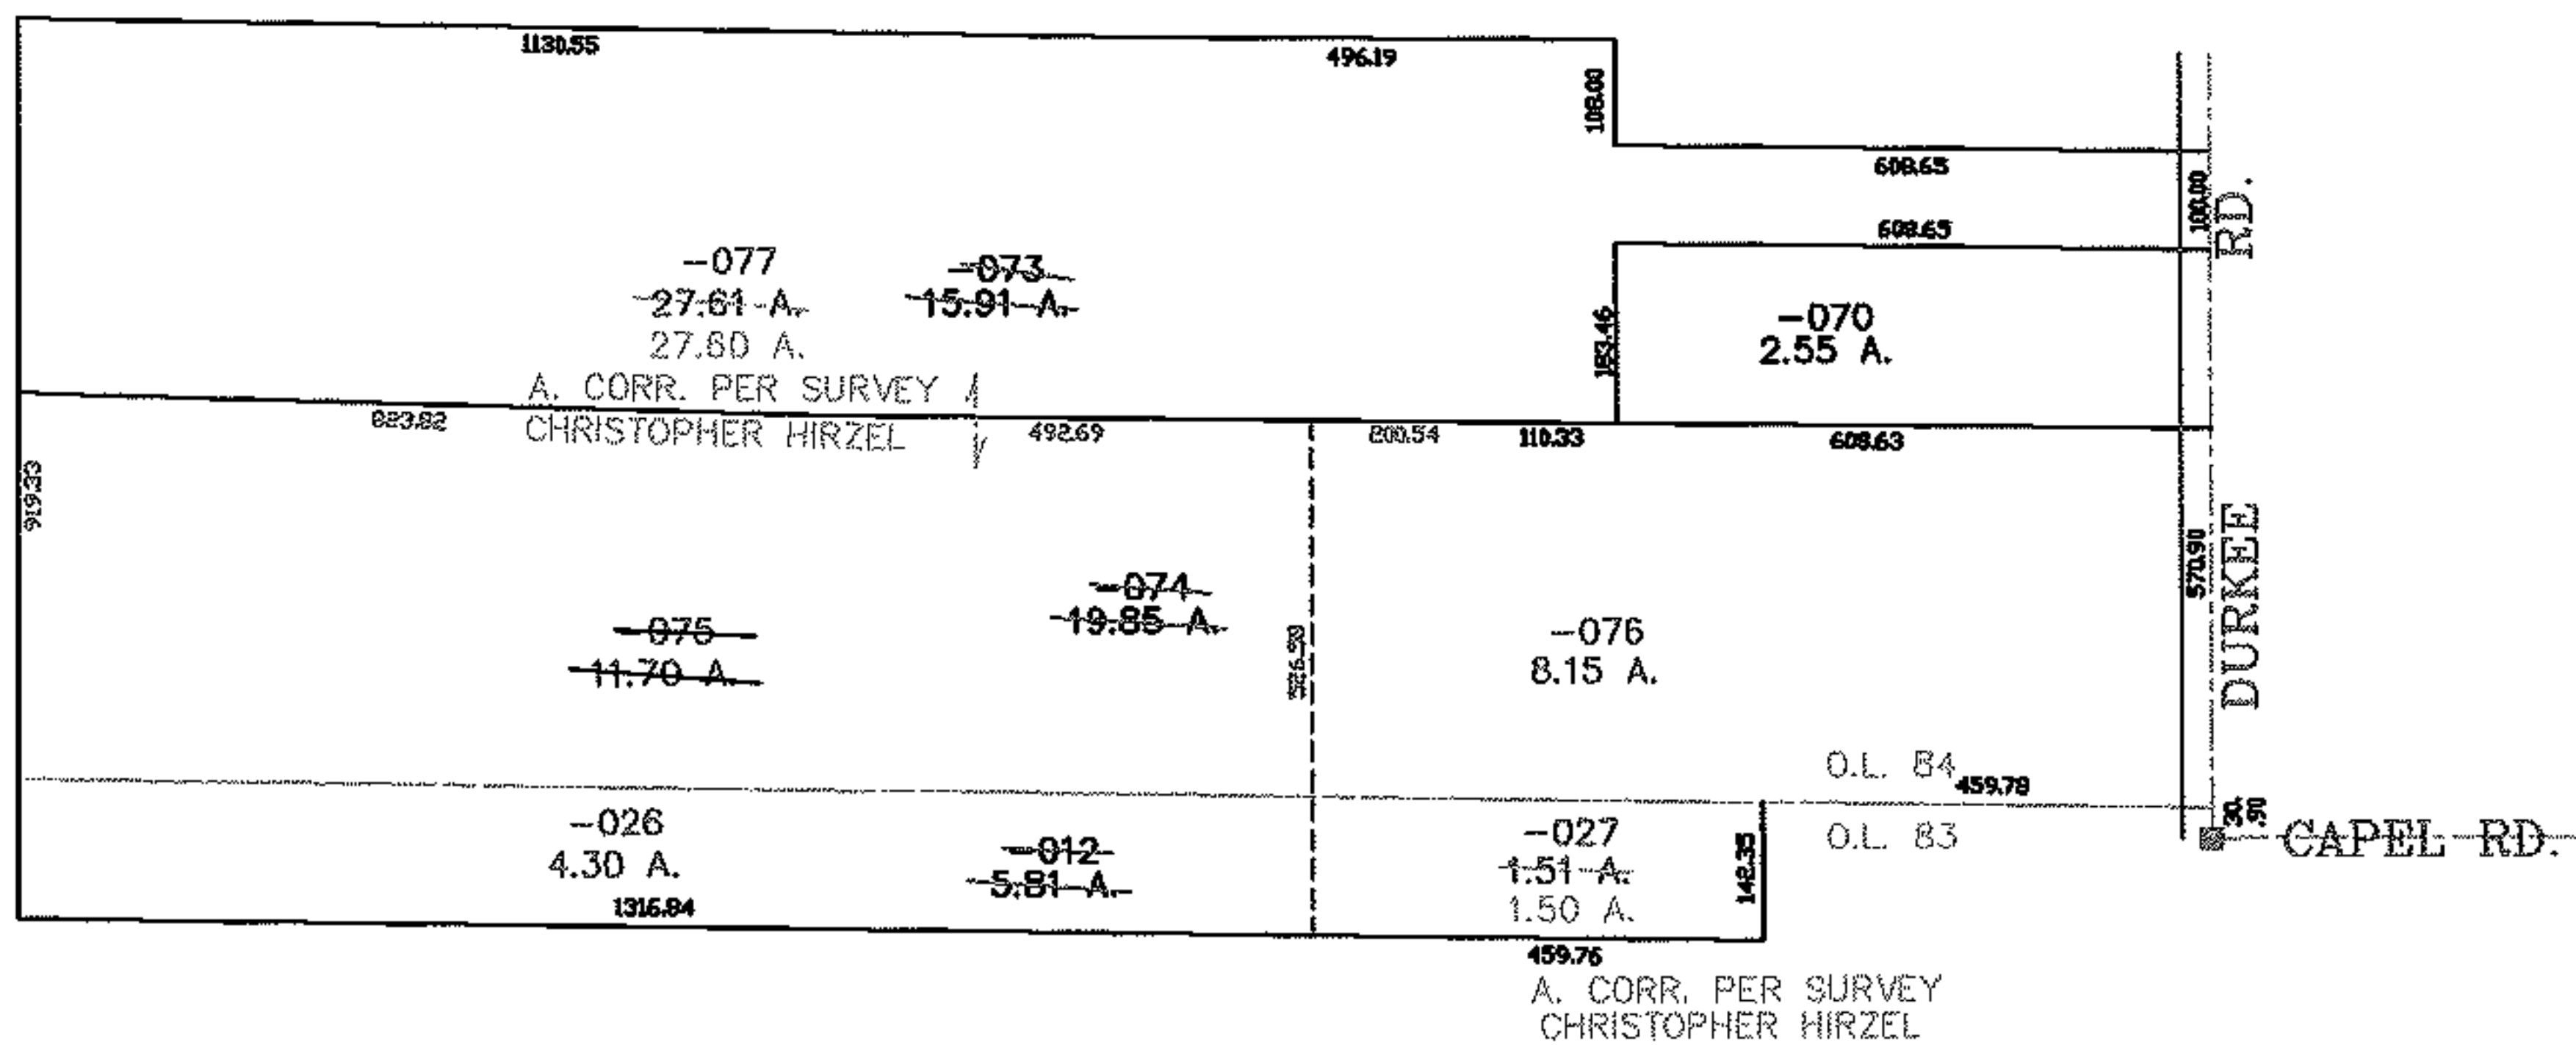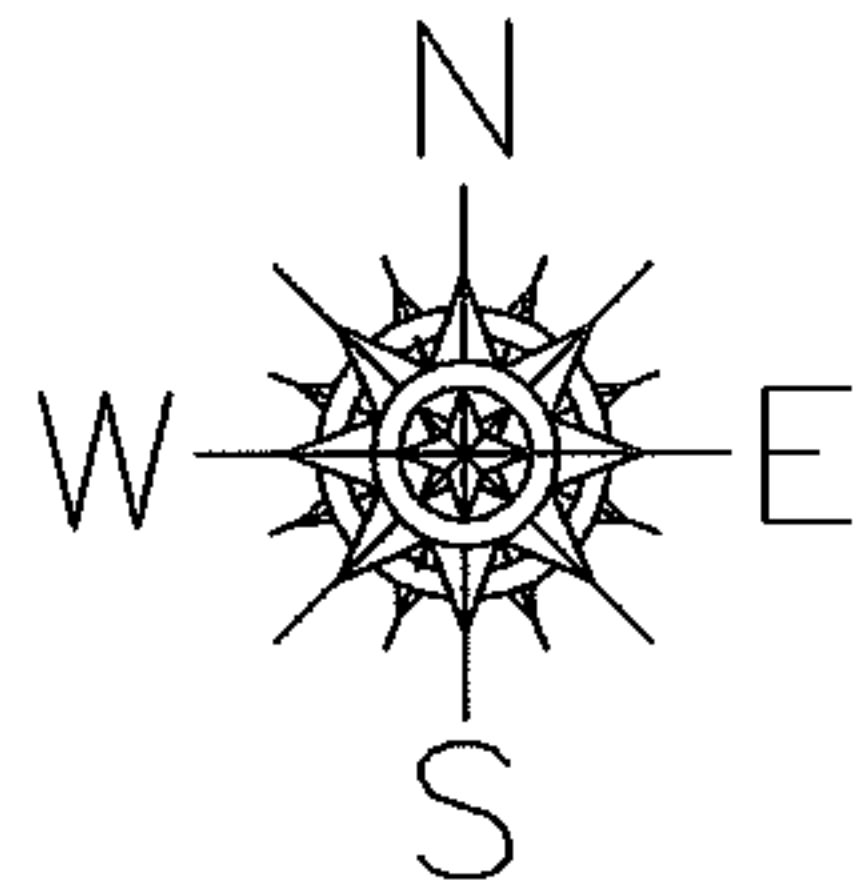

**SPLITS/DEEDS PROCESSED**  
 LORAIN COUNTY TAX MAP DEPARTMENT  
 226 MIDDLE AVE. ELYRIA, OHIO

SURVEYED BY: CHRISTOPHER HIRZEL  
 CLOSURE: 0.00 : 10.000  
 MAP PAGE(S): 11-E  
 APPROVED BY: JAH DATE: 12-17-03  
 SCALE: 1" = 400 PRIOR INSTRUMENT: 20020848165