


Raster

PARENT PARCEL: 07-00-016-104-033

CHILD PARCEL: 07-00-016-104-177, -178

STARTING POINT: CENTERLINE OF JAYCOX RD. & CENTER RIDGE RD.



NO. 01557

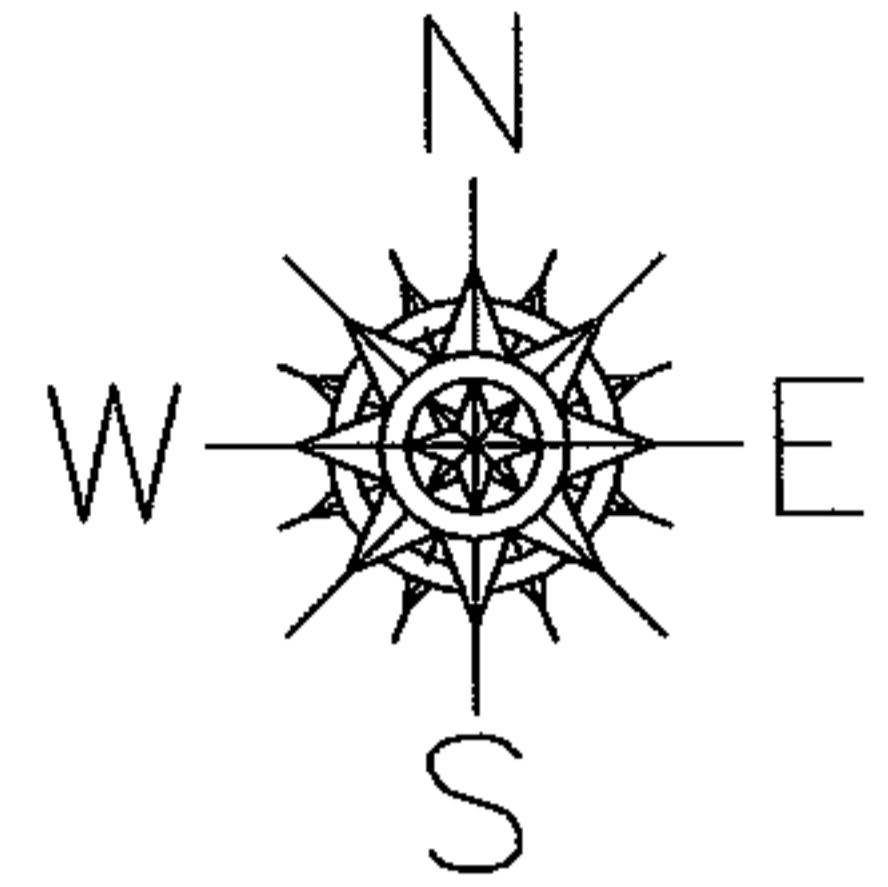

JAYCOX RD.

CENTER RIDGE RD.

RD.

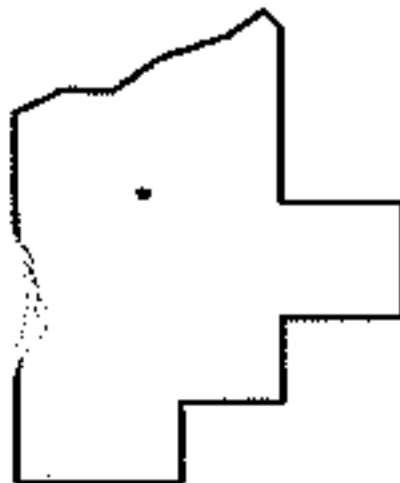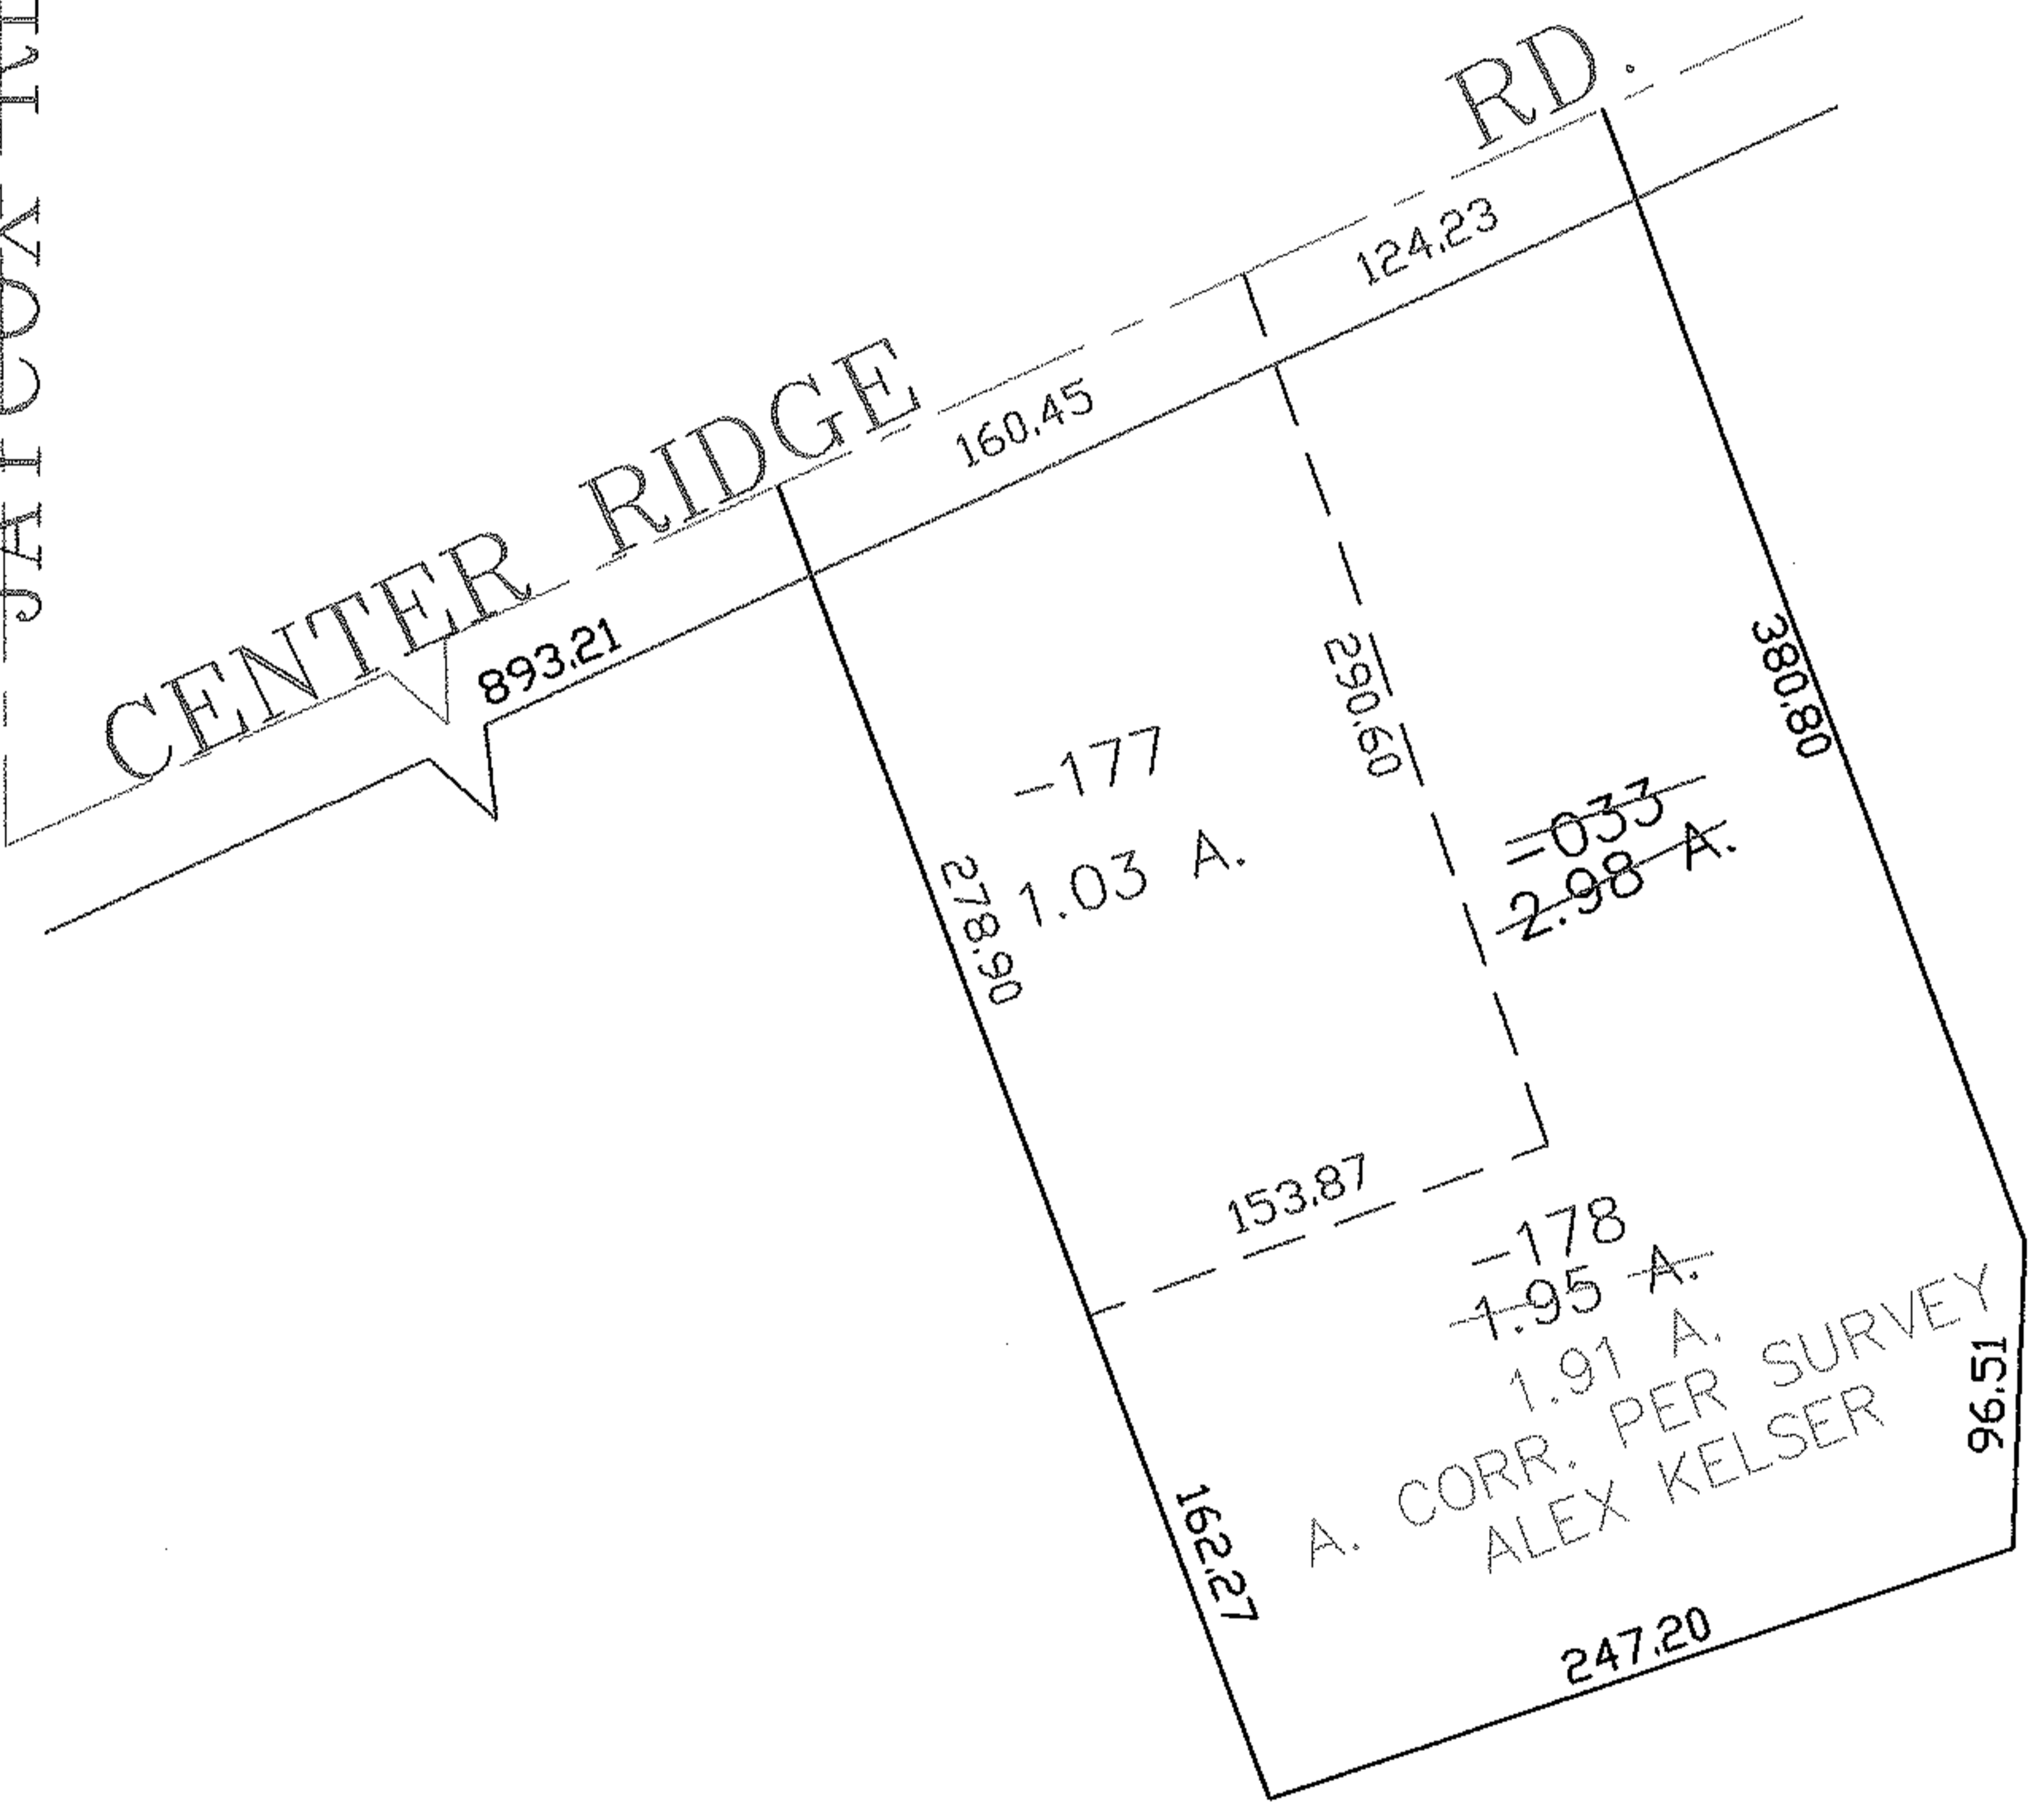

**SPLITS/DEEDS PROCESSED**

LORAIN COUNTY TAX MAP DEPARTMENT  
226 MIDDLE AVE. ELYRIA, OHIO

SURVEYED BY: ALEX KELSER

CLOSURE: 0.00 : 10.000

MAP PAGE(S): 07-00-016-A

APPROVED BY: JAH DATE: 12-29-03

SCALE: 1" = 100 PRIOR INSTRUMENT: DV 602/462