




RASTER

PARENT PARCEL: 15-00-030-000-011, -018

CHILD PARCEL: 15-00-030-000-039

12-03000

STARTING POINT: AT A MON BOX AT THE INTERSECTION OF C/L OF INDIAN HOLLOW RD. AND C/L OF BIGGS RD.

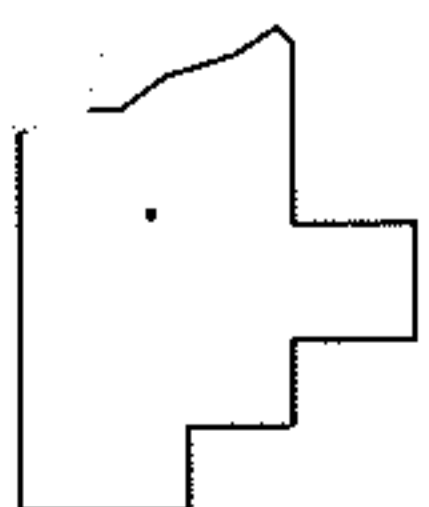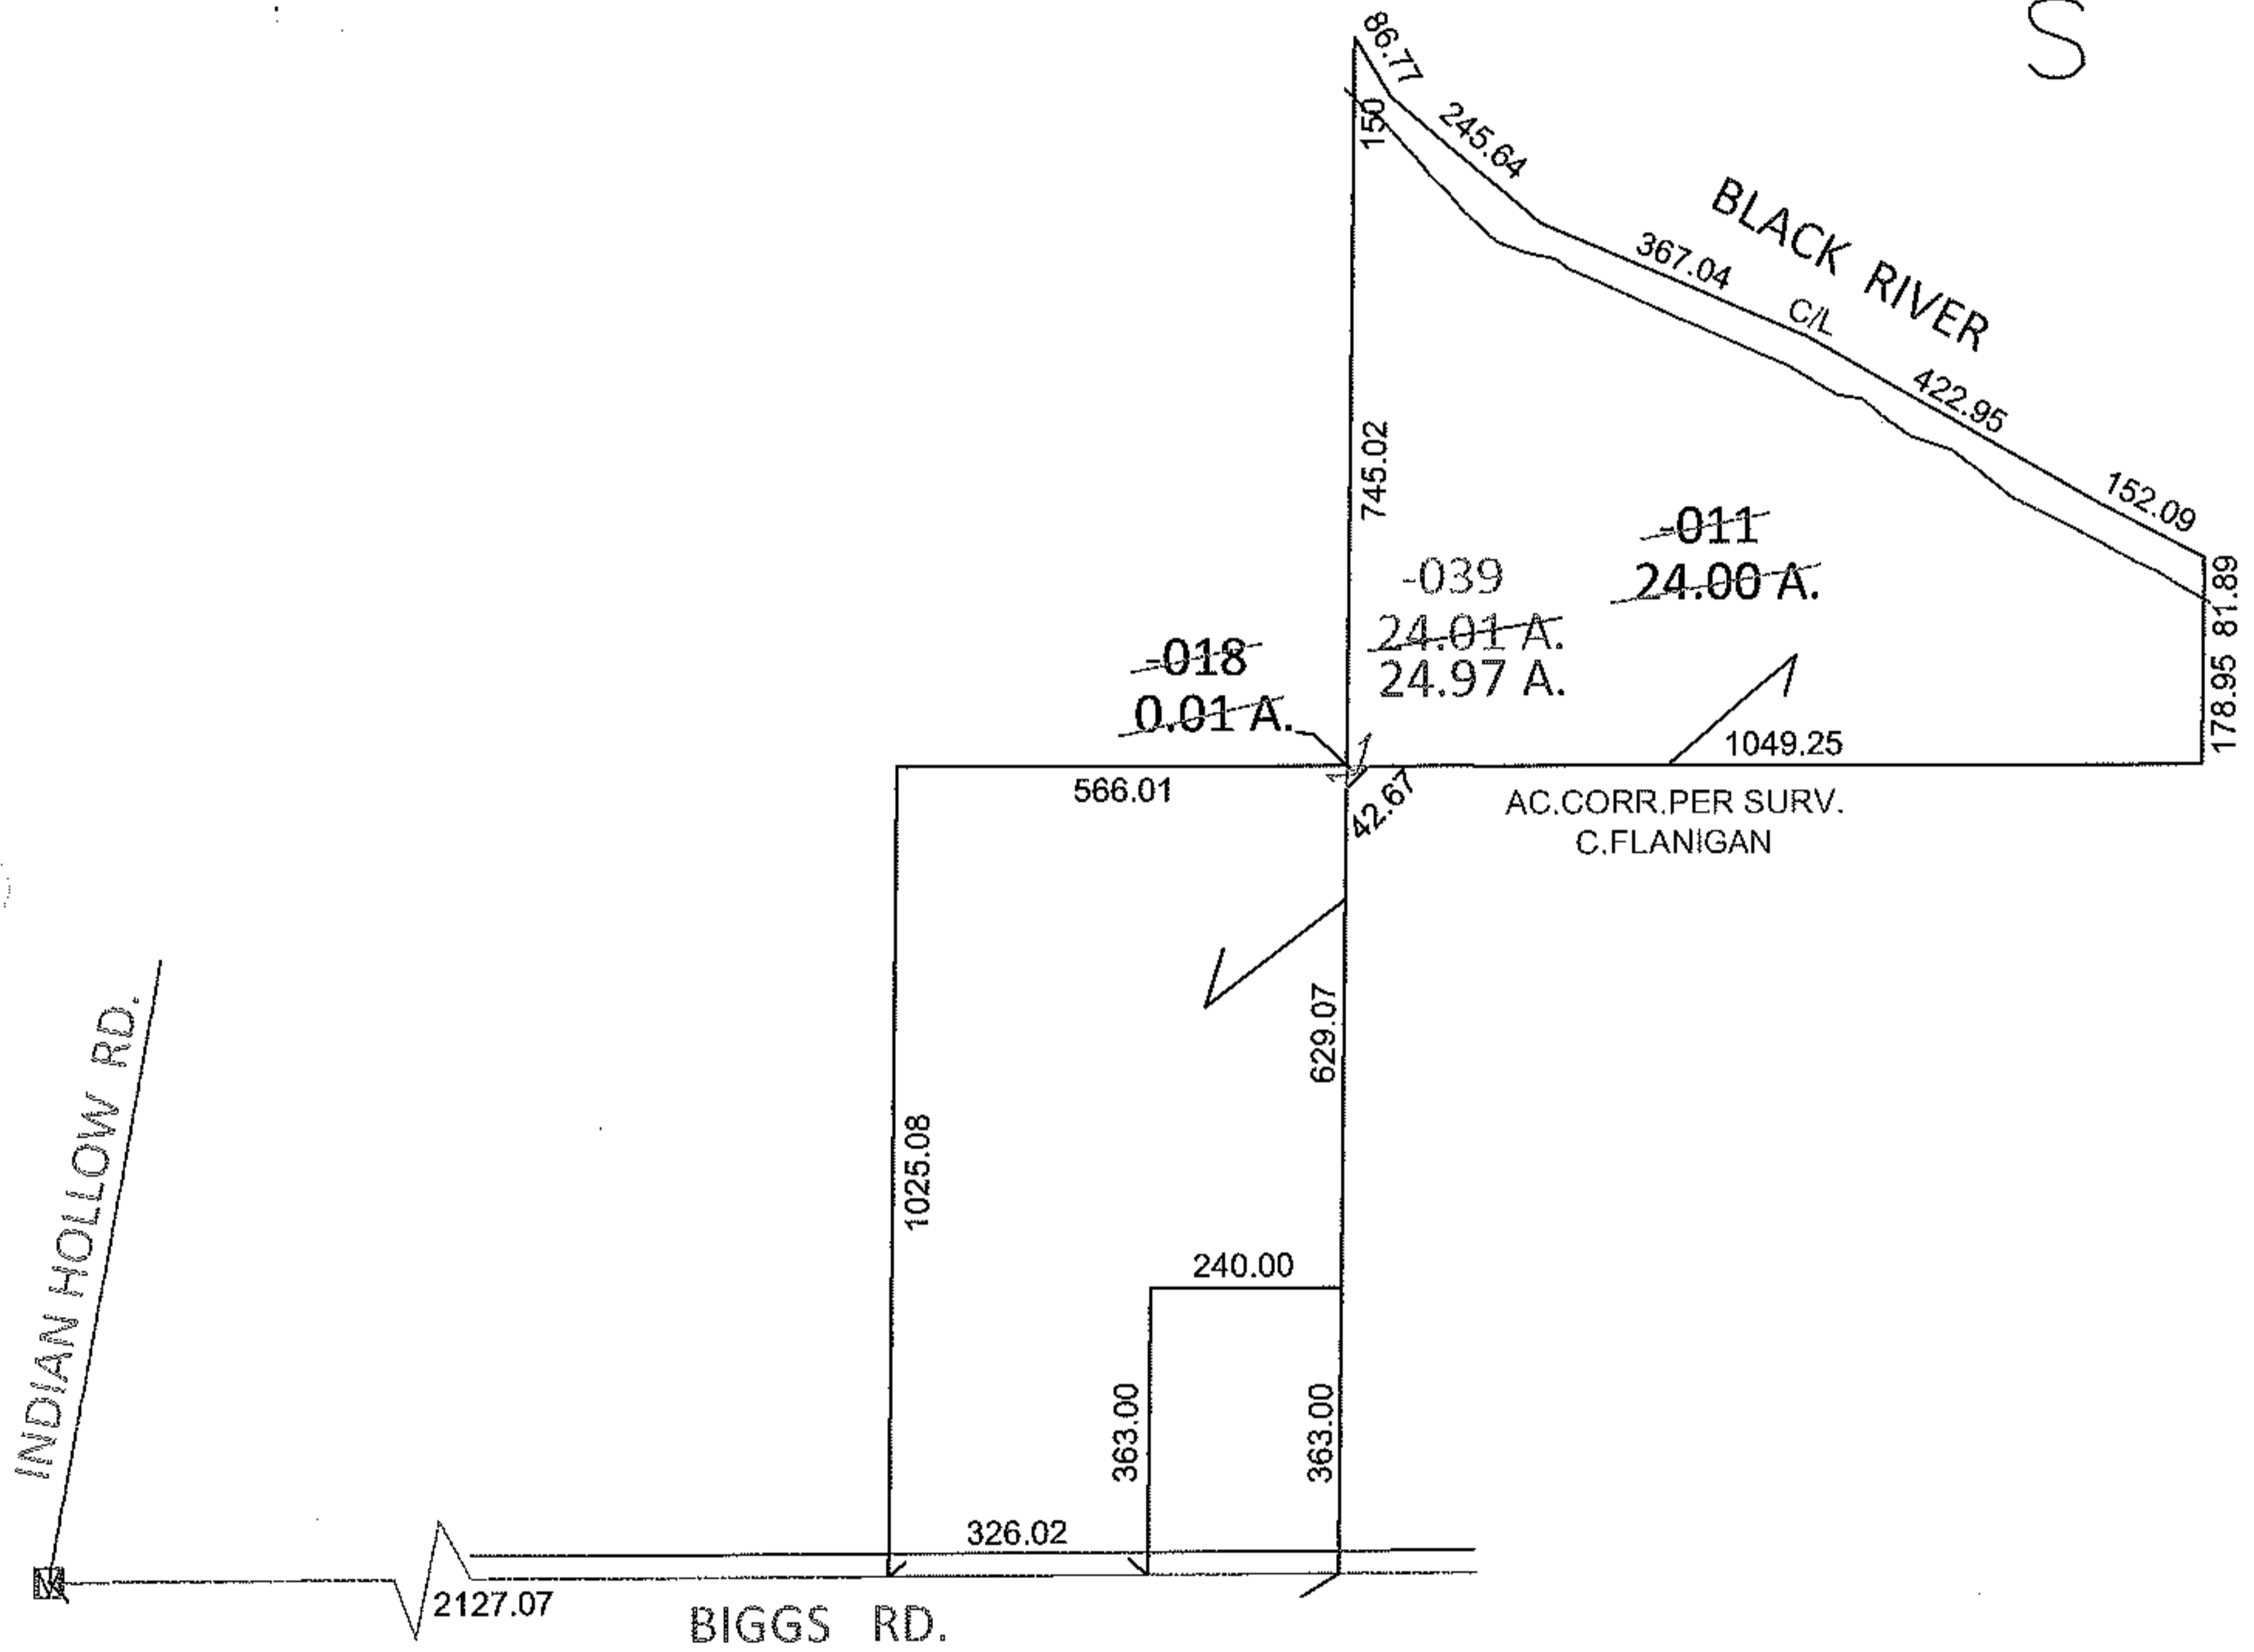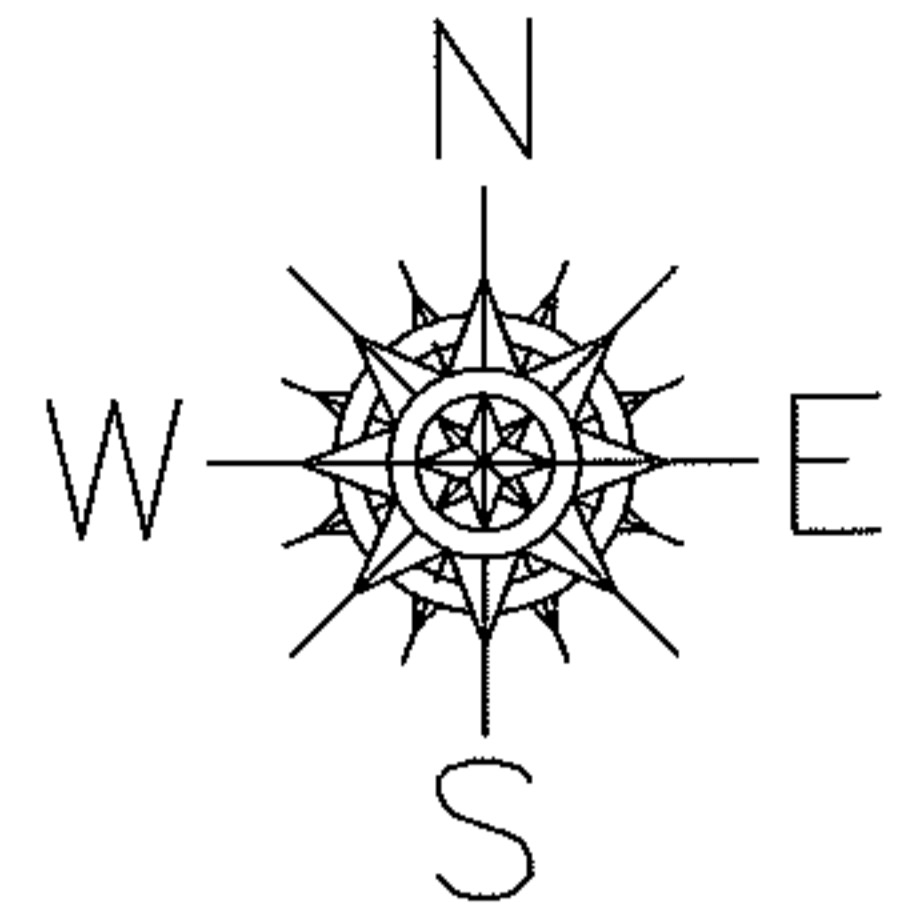

SPLITS/DEEDS PROCESSED

LORAIN COUNTY TAX MAP DEPARTMENT
226 MIDDLE AVE. ELYRIA, OHIO

SURVEYED BY: CHARLES W. FLANIGAN

CLOSURE: .01:10,000

MAP PAGE(S): 15-D

APPROVED BY: RRM DATE: 2-21-12

SCALE: 1"= 400 PRIOR INST.: DV XXXX/XXX