




RASTER

PARENT PARCEL: 02-02-008-107-051

CHILD PARCEL: 02-02-008-107-053, -054

STARTING POINT: CENTERLINE OF JAEGER RD & O.L. 8

12-03001

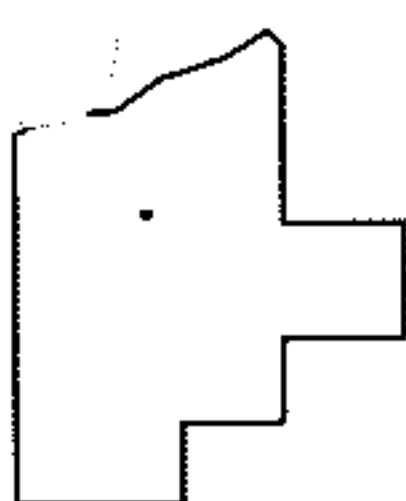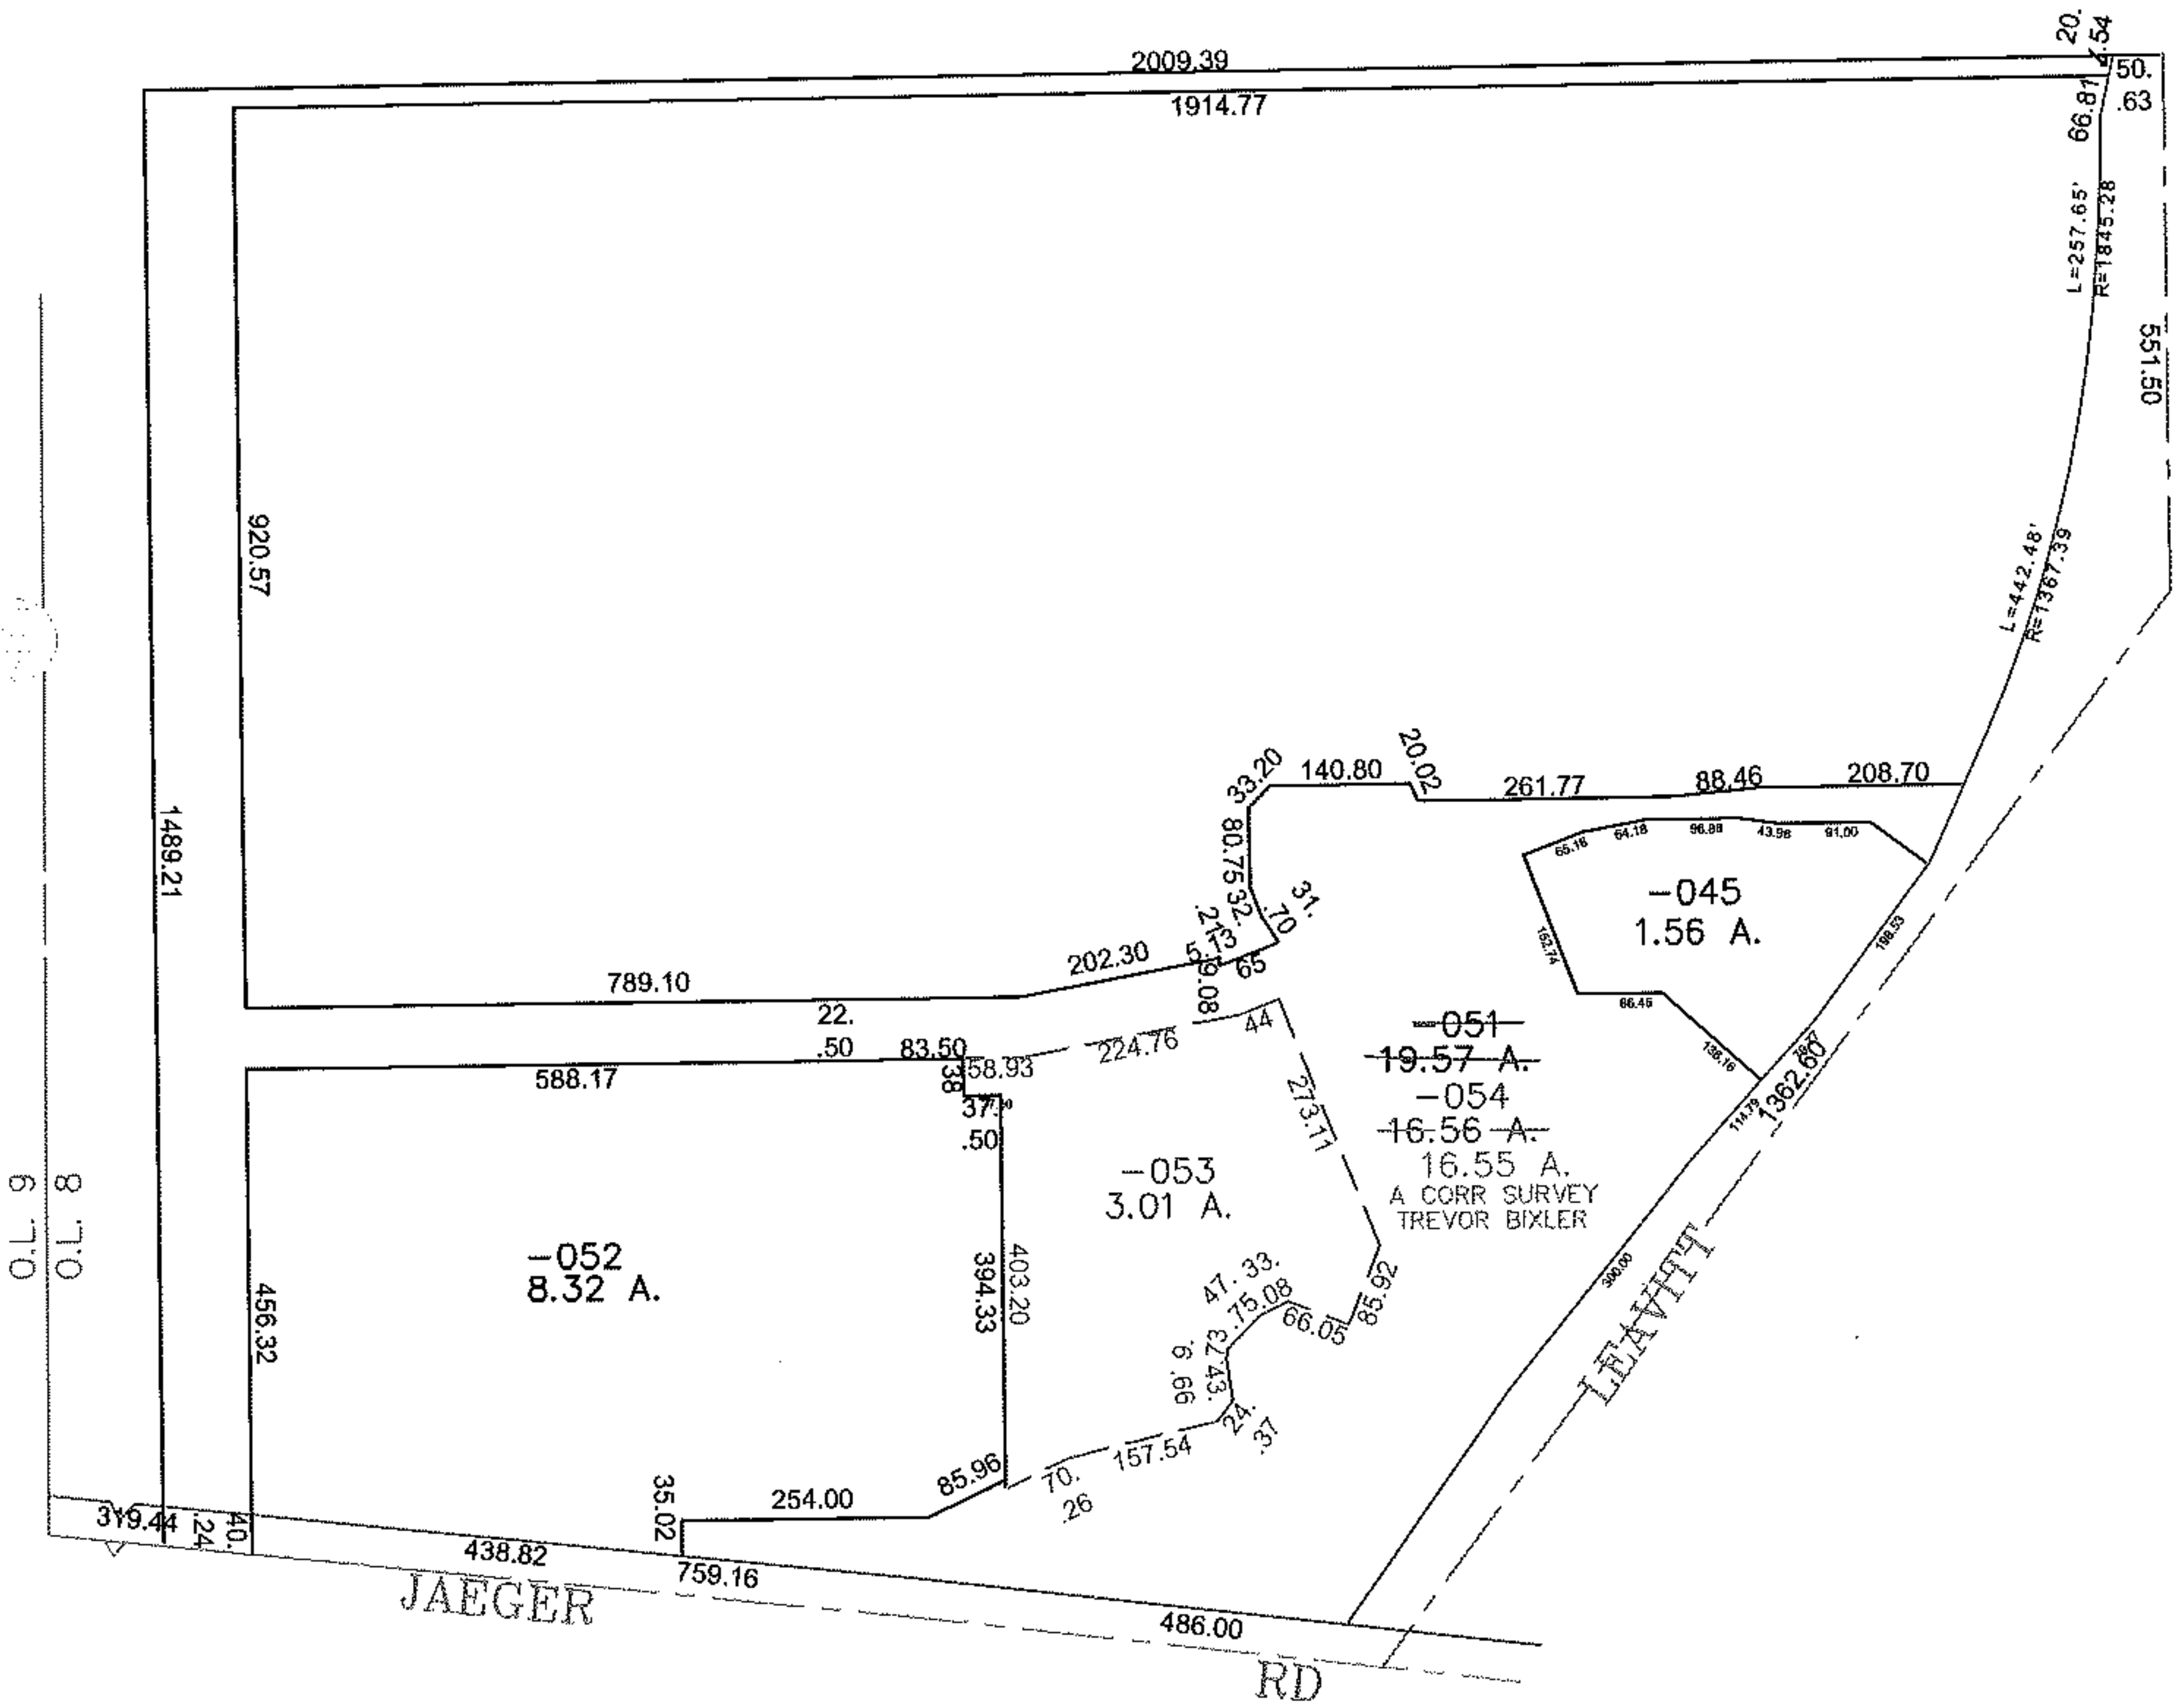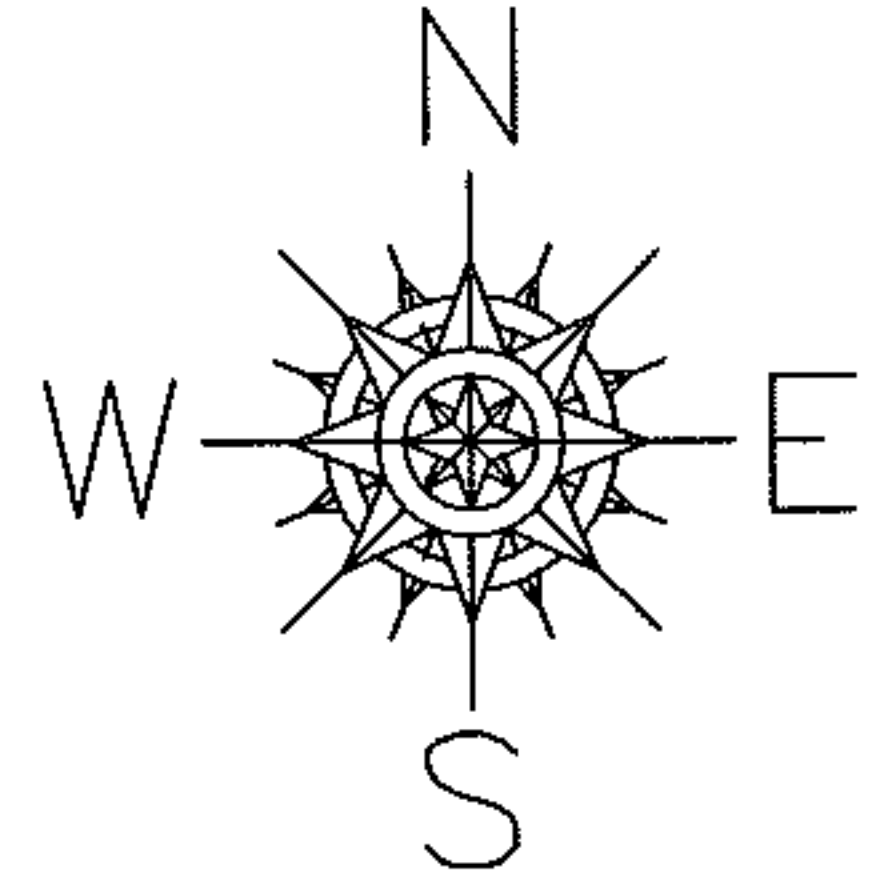

**SPLITS/DEEDS PROCESSED**

LORAIN COUNTY TAX MAP DEPARTMENT  
226 MIDDLE AVE. ELYRIA, OHIO

SURVEYED BY: TREVOR BIXLER  
CLOSURE: 0.00 : 10.000  
MAP PAGE(S): 02-02-008-A, B  
APPROVED BY: JAH DATE: 2/22/2012  
SCALE: 1" = 300 PRIOR INSTRUMENT: 20090290055