
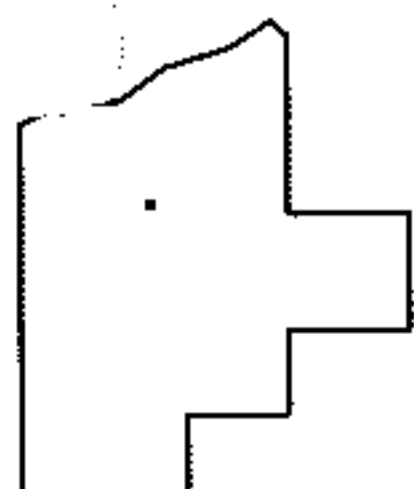
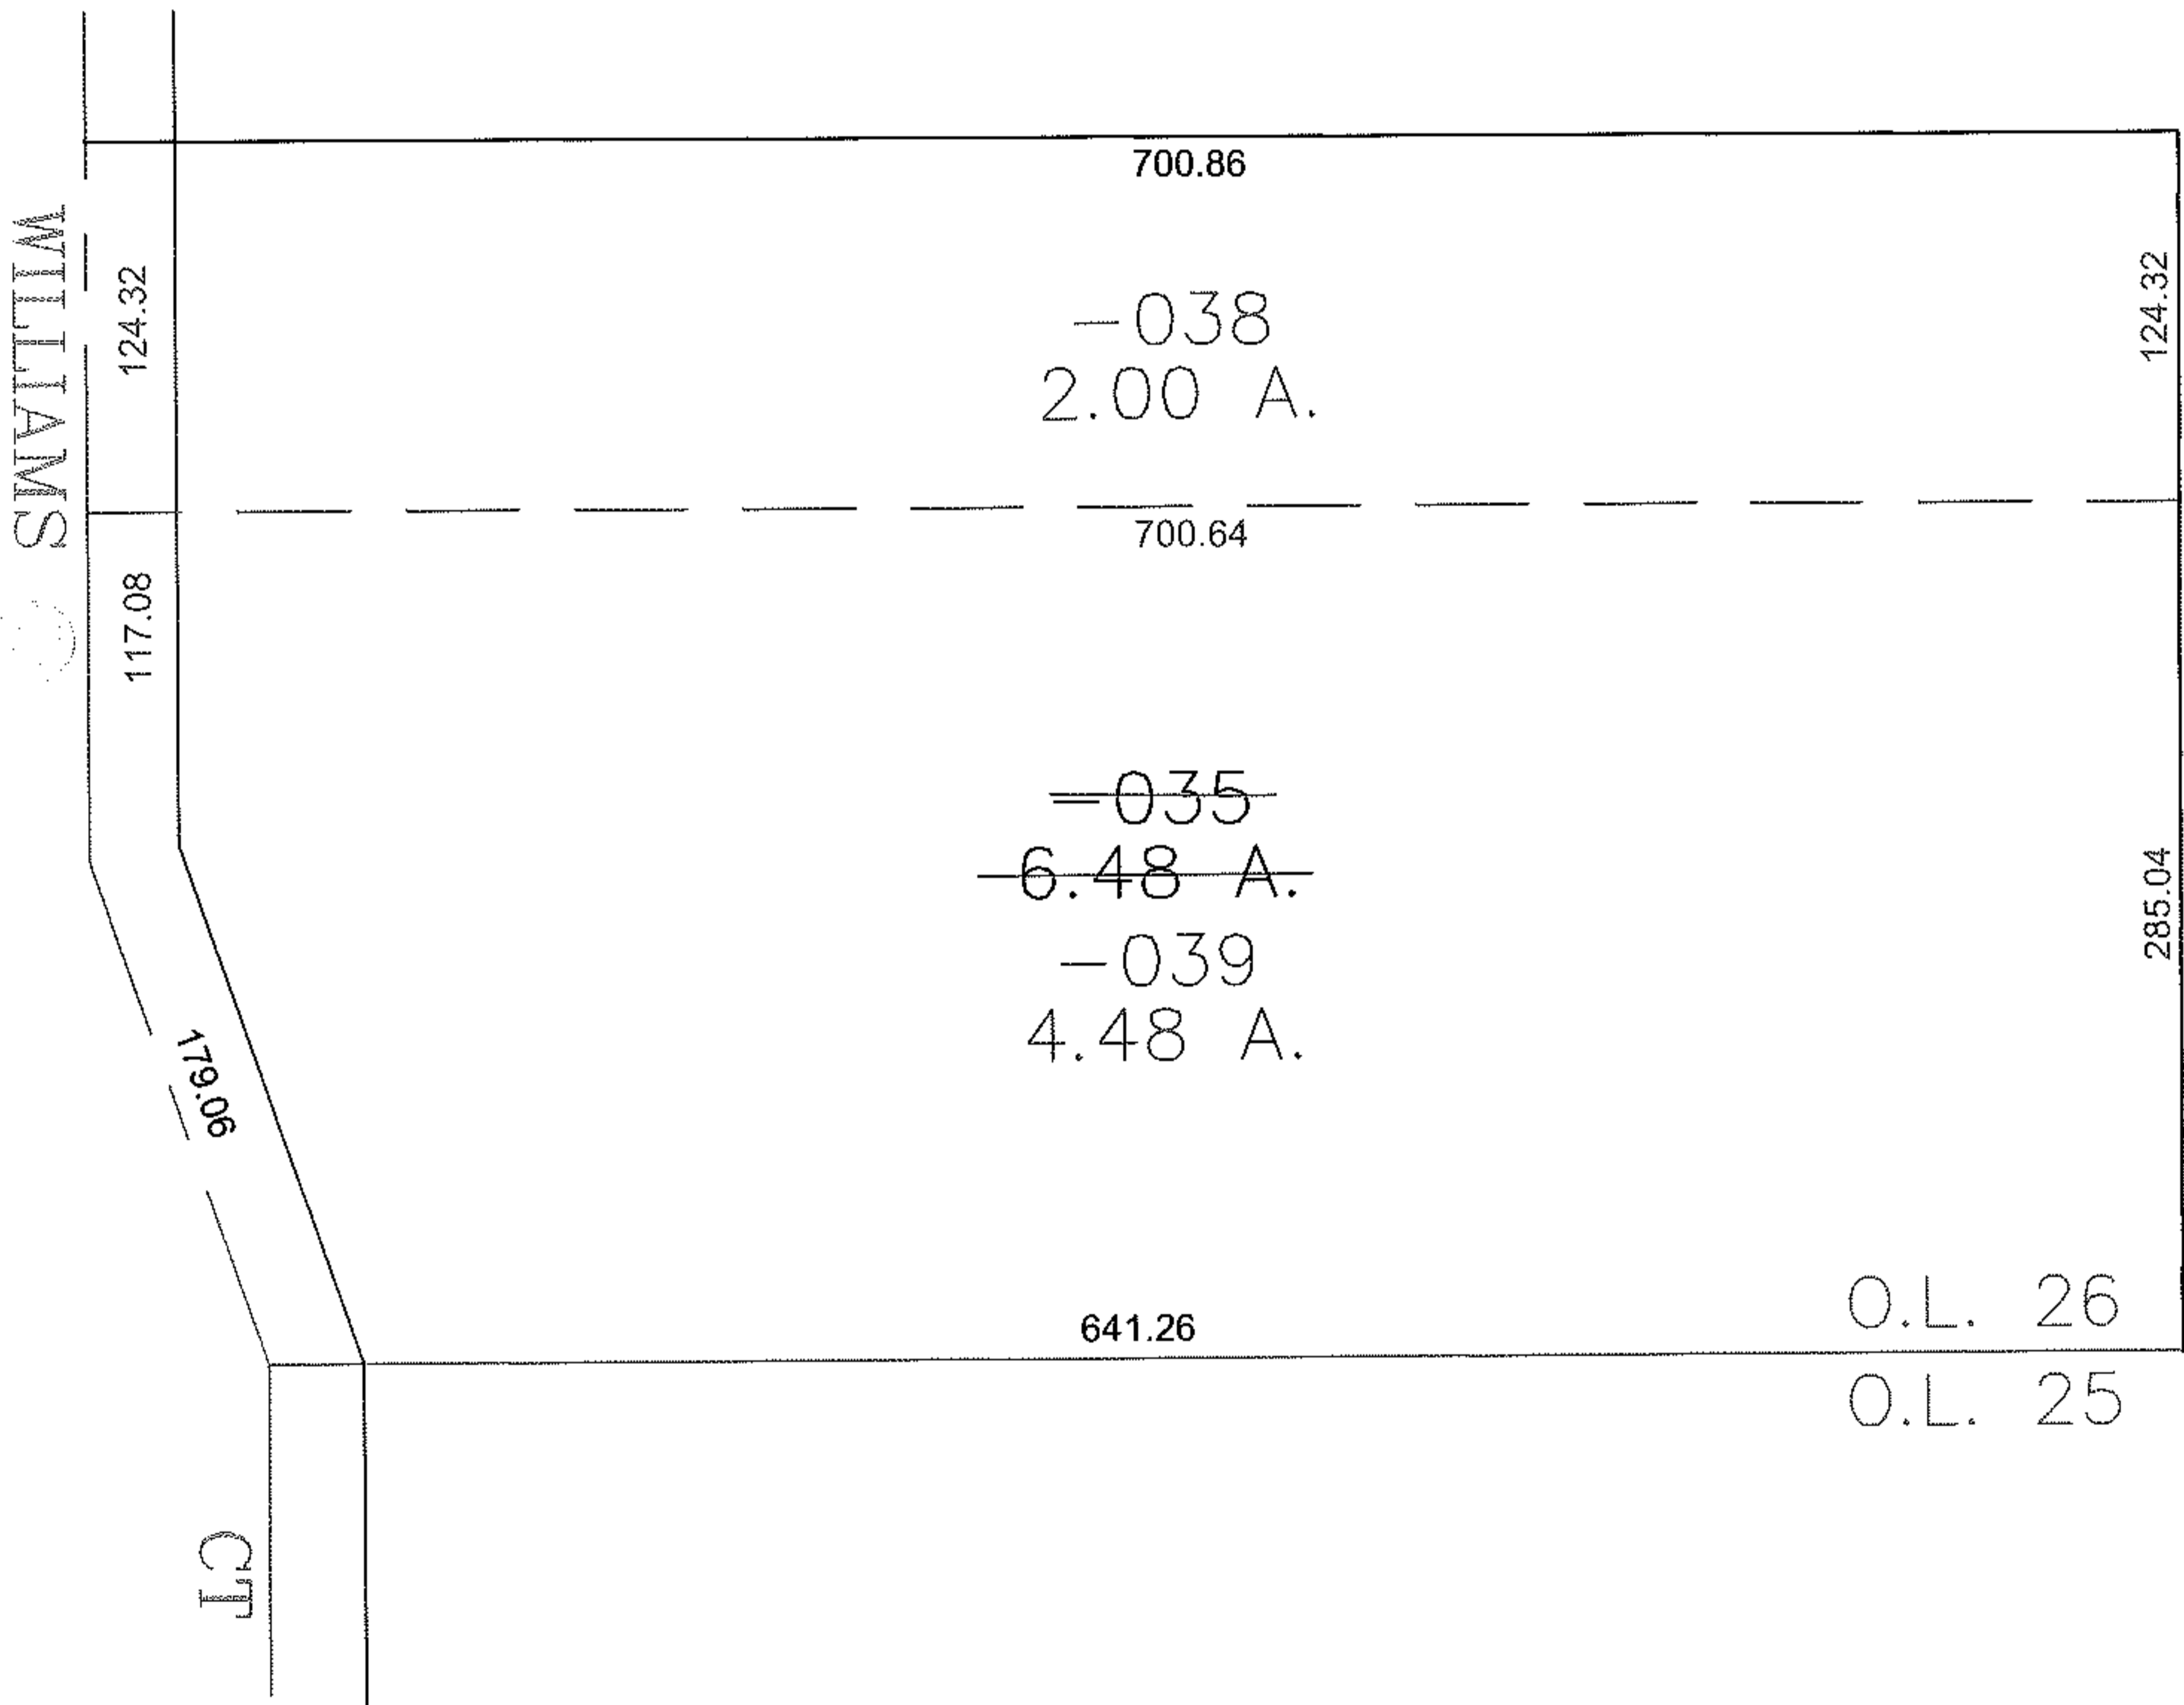


PARENT PARCEL: 04-00-026-110-035

CHILD PARCEL: 04-00-026-110-038, -039

STARTING POINT: CENTERLINE OF WILLIAMS CT & O.L. 26

12-03004

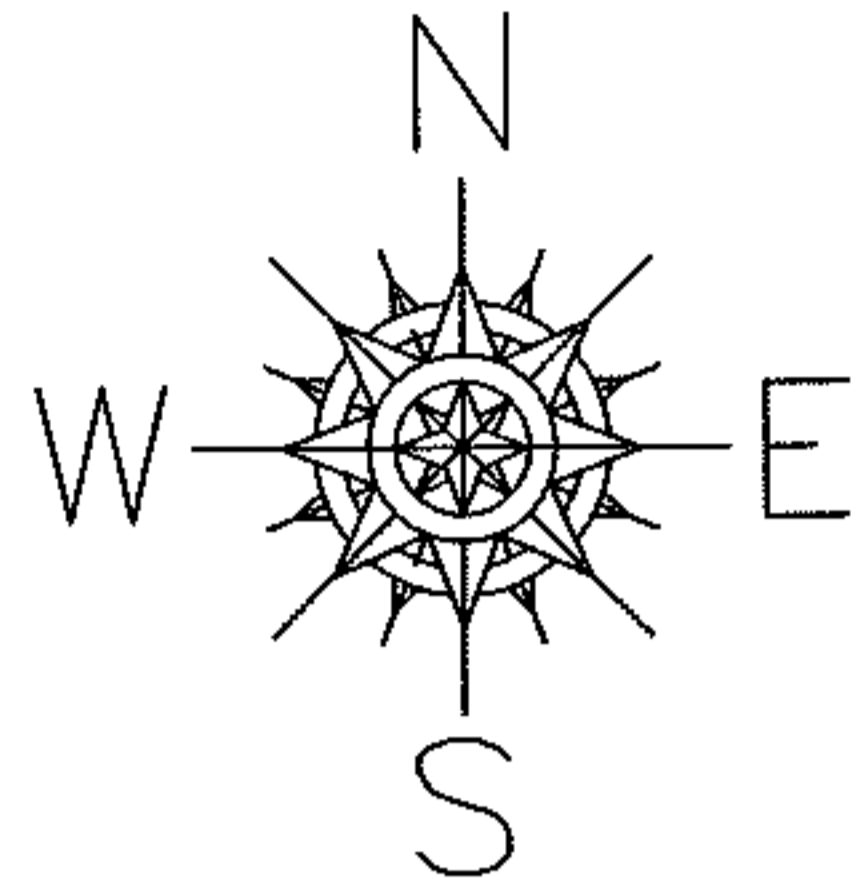

SPLITS/DEEDS PROCESSED

LORAIN COUNTY TAX MAP DEPARTMENT
226 MIDDLE AVE. ELYRIA, OHIO

SURVEYED BY: AMY KELLY

CLOSURE: 0.00 : 10.000

MAP PAGE(S): 04-00-026-G

APPROVED BY: JAH DATE: 3-1-2012

SCALE: 1" = 100 PRIOR INSTRUMENT: 20000701036