

PARENT PARCEL: 03-00-099-113-002  
CHILD PARCEL: 03-00-099-113-004 & 03-00-104-101-051  
STARTING POINT: INTERSECTION, CL OF DENISON AVE. & SOUTH LINE OF OAKWOOD ACRES SUB. NO. 6

14-03005-A

### ACREAGE CORRECTION




03-00-099-113-002  
~~9.60 A.~~  
9.99 A.

### UNCOMBINATION

~~03-00-099-113-002~~  
~~9.99 A.~~

03-00-099-113-004  
5.45 A.

03-00-104-101-051  
4.54 A.

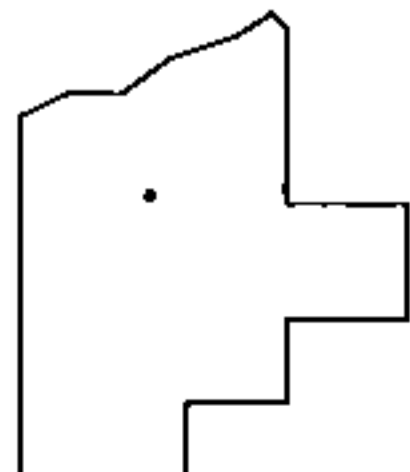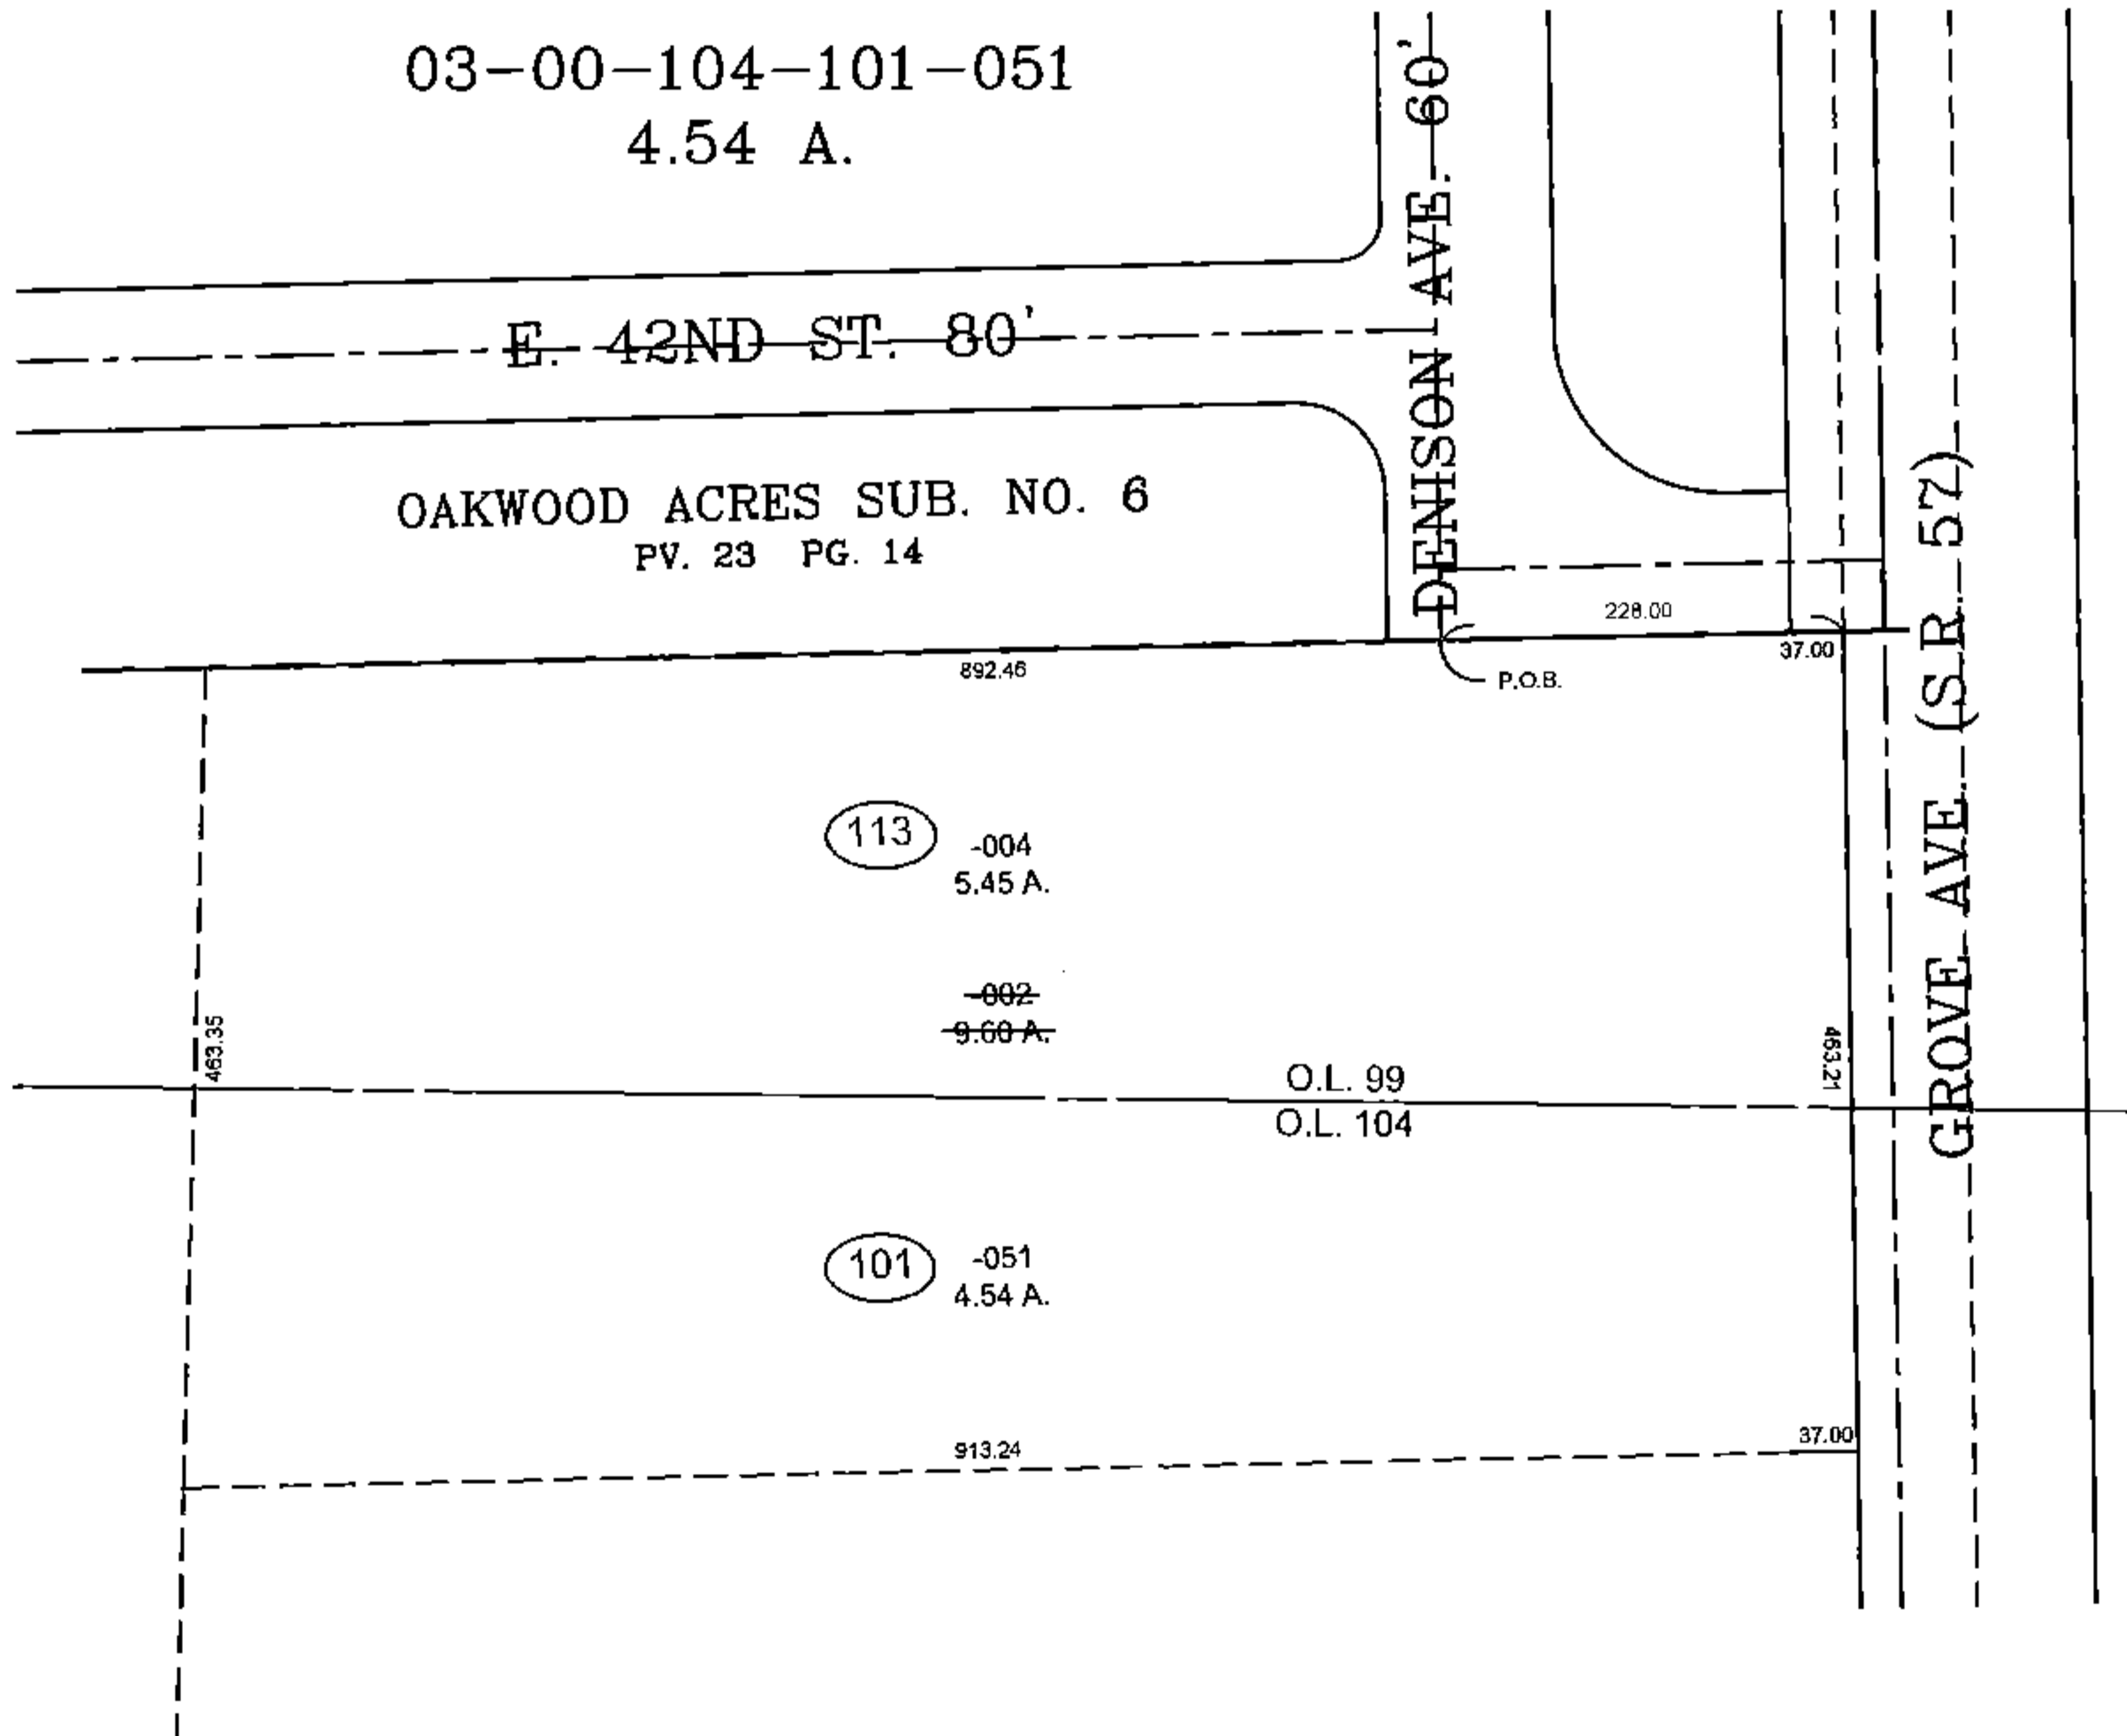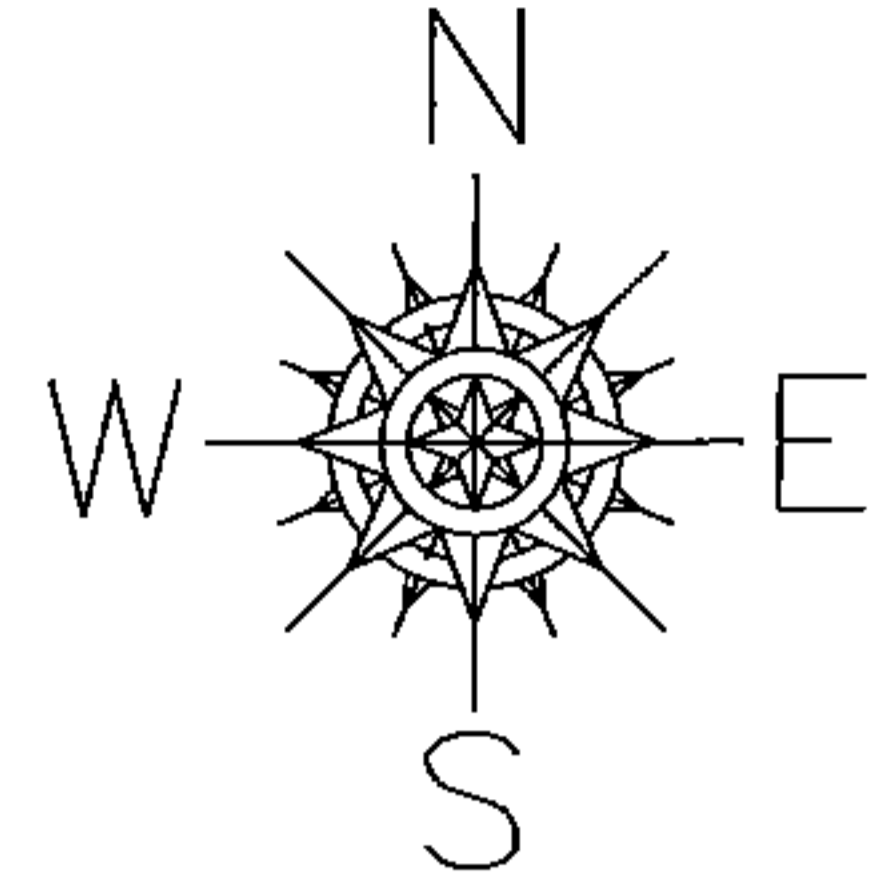

**SPLITS/DEEDS PROCESSED**  
LORAIN COUNTY TAX MAP DEPARTMENT  
226 MIDDLE AVE. ELYRIA, OHIO

SURVEYED BY: GERALD L. YETZER  
CLOSURE: 0.01 : 10,000  
MAP PAGE(S): 3-00-099 & -104  
APPROVED BY: TJS DATE: 9/11/14  
SCALE: 1" = 200' PRIOR INSTRUMENT: OR 46/757