
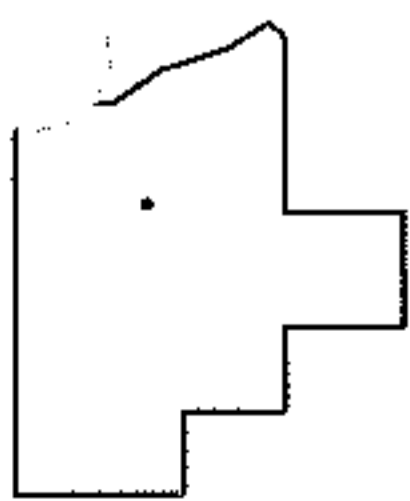
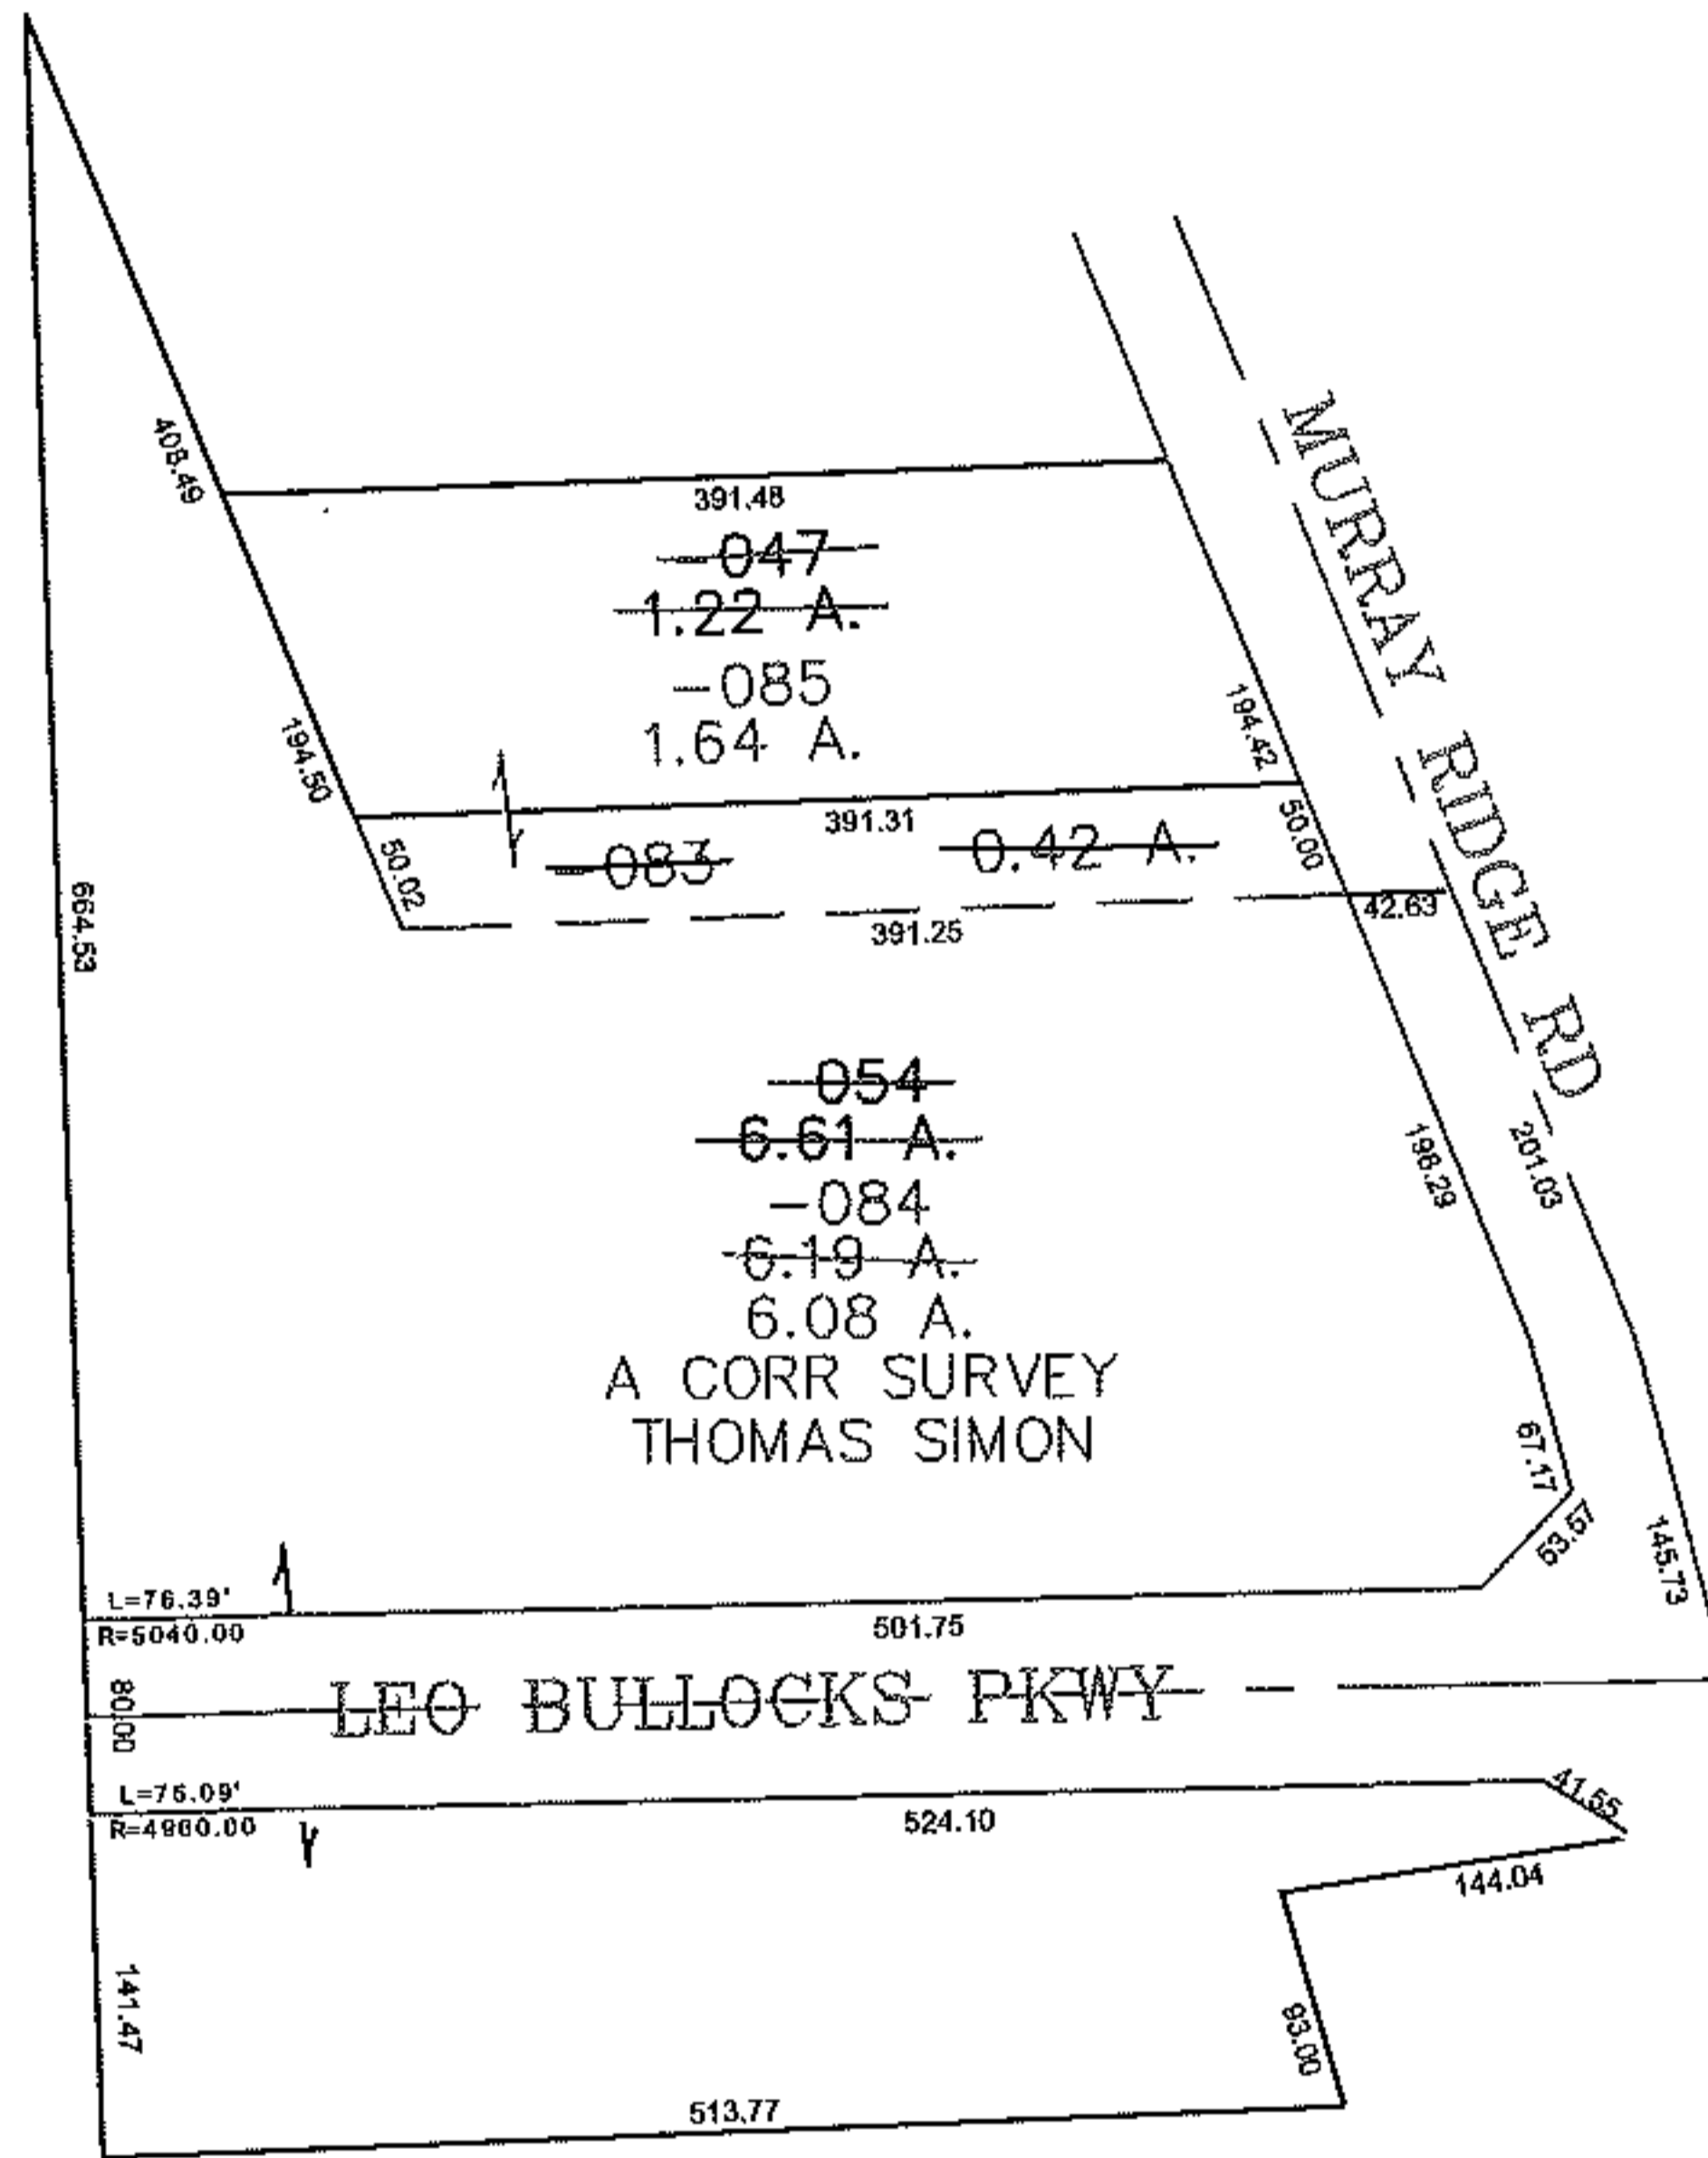


PARENT PARCEL: 06-24-014-000-054, -047

CHILD PARCEL: 06-24-014-000-083 THRU -085

12-03008

STARTING POINT: INTERSECTION OF LEO BULLOCKS RD & MURRAY RIDGE RD

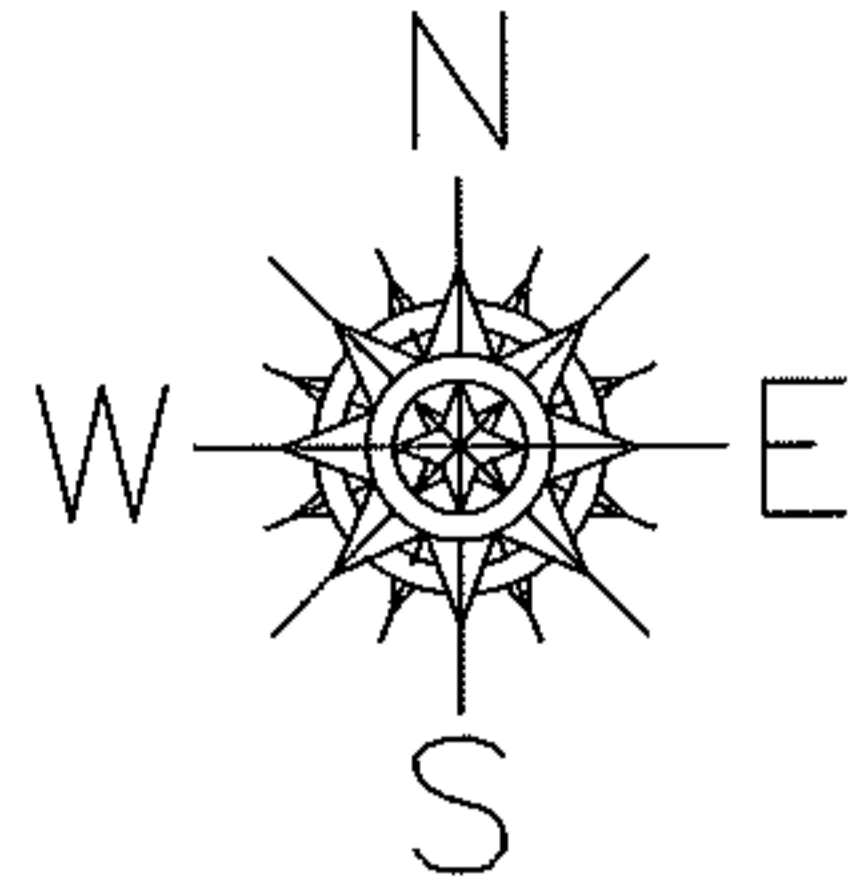

SPLITS/DEEDS PROCESSED
LORAIN COUNTY TAX MAP DEPARTMENT
 226 MIDDLE AVE. ELYRIA, OHIO

SURVEYED BY: THOMAS SIMON
 CLOSURE: 0.00 : 10,000
 MAP PAGE(S): 6-112
 APPROVED BY: JAH DATE: 8-23-2012
 SCALE: 1" = 200 PRIOR INSTRUMENT: 20020880615