


PARENT PARCEL: 05-00-026-101-059 -076

CHILD PARCEL: 05-00-026-101-129

STARTING POINT: CENTERLINE OF WESTCHESTER RD & SLEEPY HOLLOW DR

12-03014

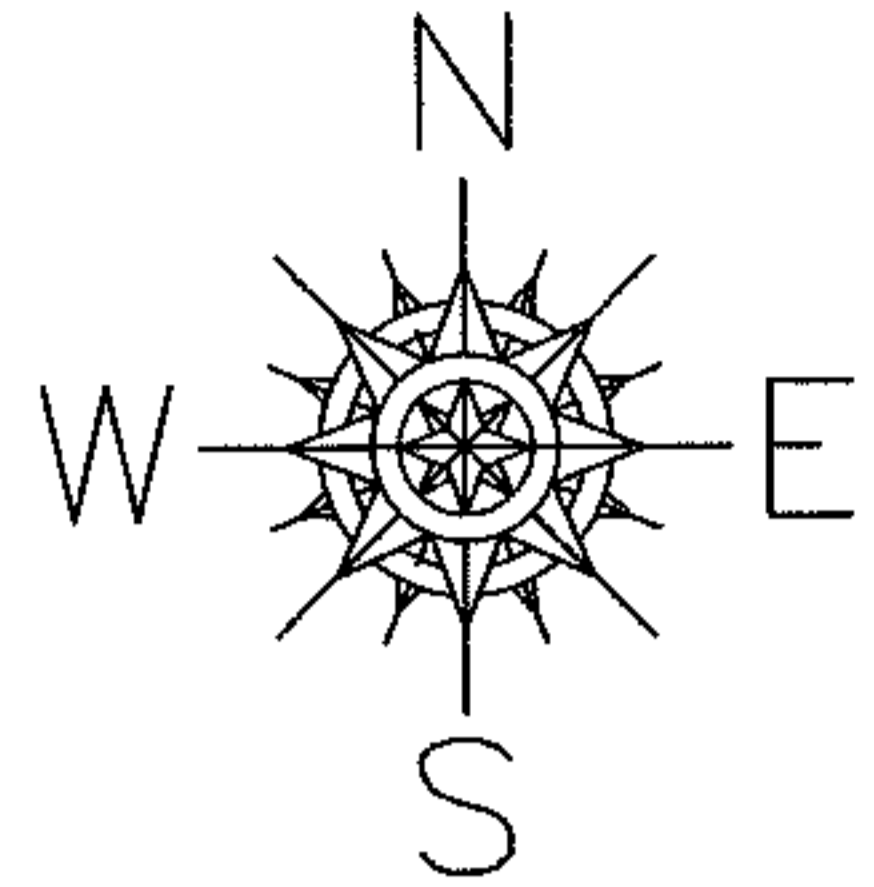

WESTCHESTER DR

SLEEPY HOLLOW DR

147.84

215.45

90.26

~~-059~~  
~~0.45 A.~~  
~~-129~~  
~~0.51 A.~~  
0.52 A.

128.37

30


A CORR SURVEY  
MATTHEW CAMPBELL

153.22

57.12

~~-076~~  
0.06 A.

64.94

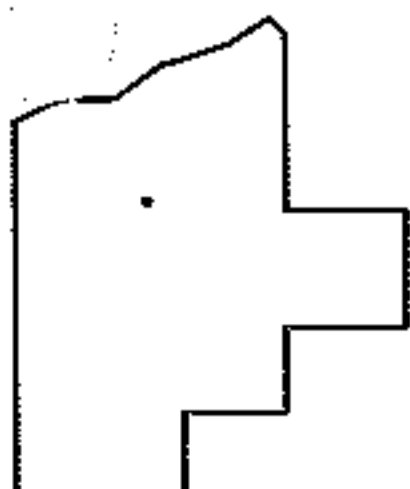

SPLITS/DEEDS PROCESSED

LORAIN COUNTY TAX MAP DEPARTMENT  
226 MIDDLE AVE. ELYRIA, OHIO

SURVEYED BY: MATTHEW CAMPBELL

CLOSURE: 0.00 : 10,000

MAP PAGE(S): 05-00-026-A

APPROVED BY: JAH DATE: 4/20/2012

SCALE: 1" = 50' PRIOR INST.: 20050066121