
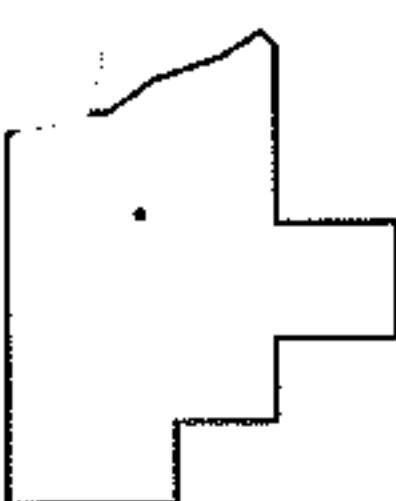
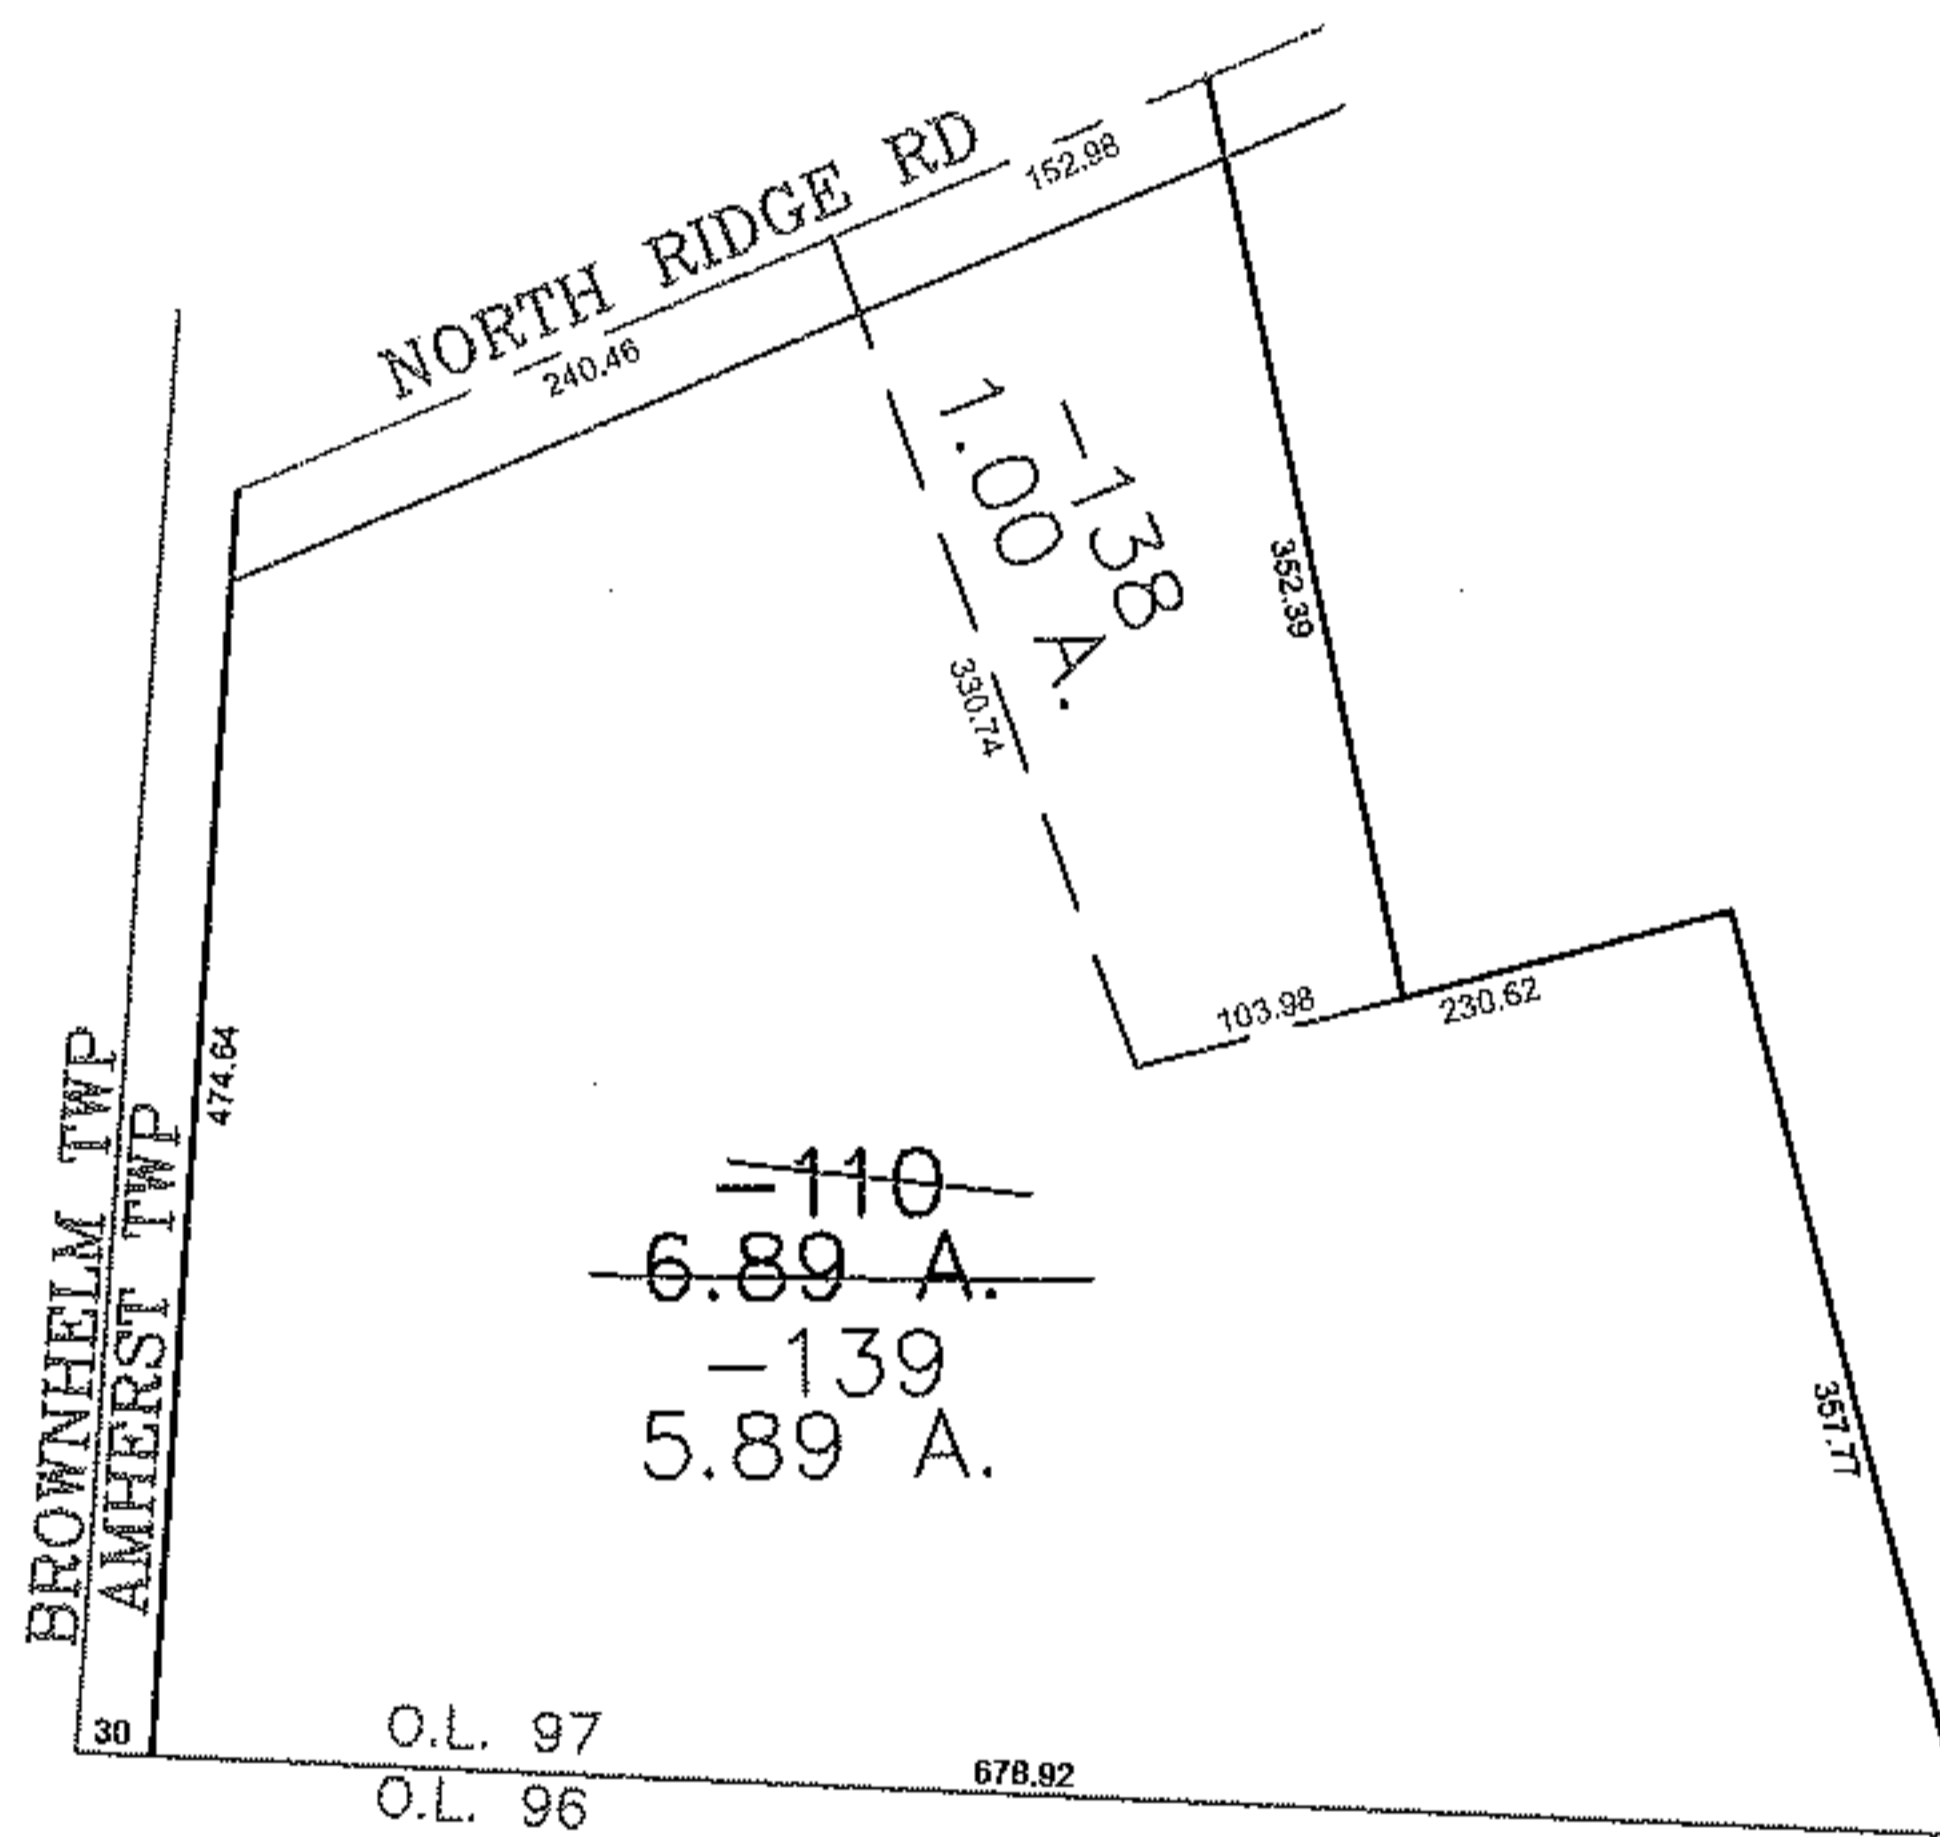


PARENT PARCEL: 05-00-097-103-110

CHILD PARCEL: 05-00-097-103-138, -139

STARTING POINT: SOUTHWEST CORNER OF O.L. 97

12-03015

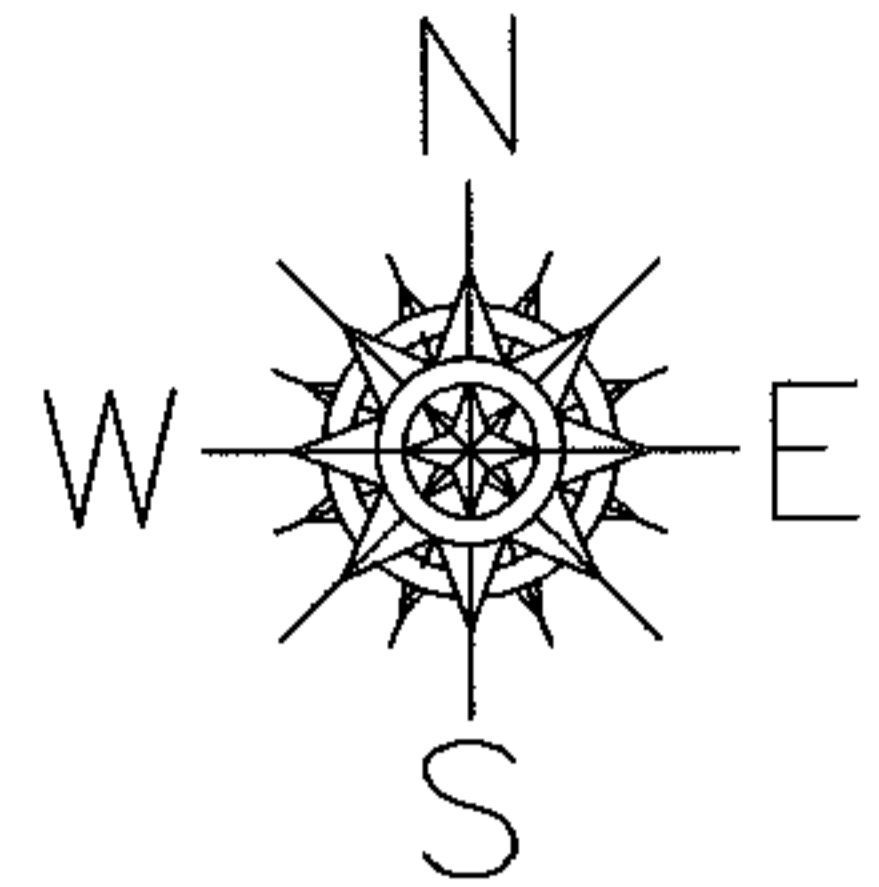

SPLITS/DEEDS PROCESSED
 LORAIN COUNTY TAX MAP DEPARTMENT
 226 MIDDLE AVE. ELYRIA, OHIO

SURVEYED BY: THOMAS SIMON
 CLOSURE: 0.00 : 10.000
 MAP PAGE(S): 05-00-097-A
 APPROVED BY: JAH DATE: 4-18-2012
 SCALE: 1" = 200 PRIOR INSTRUMENT: 20070185106