
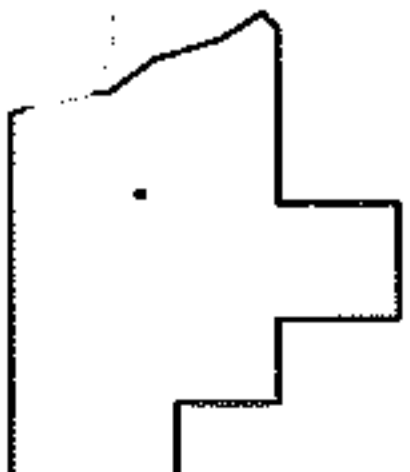
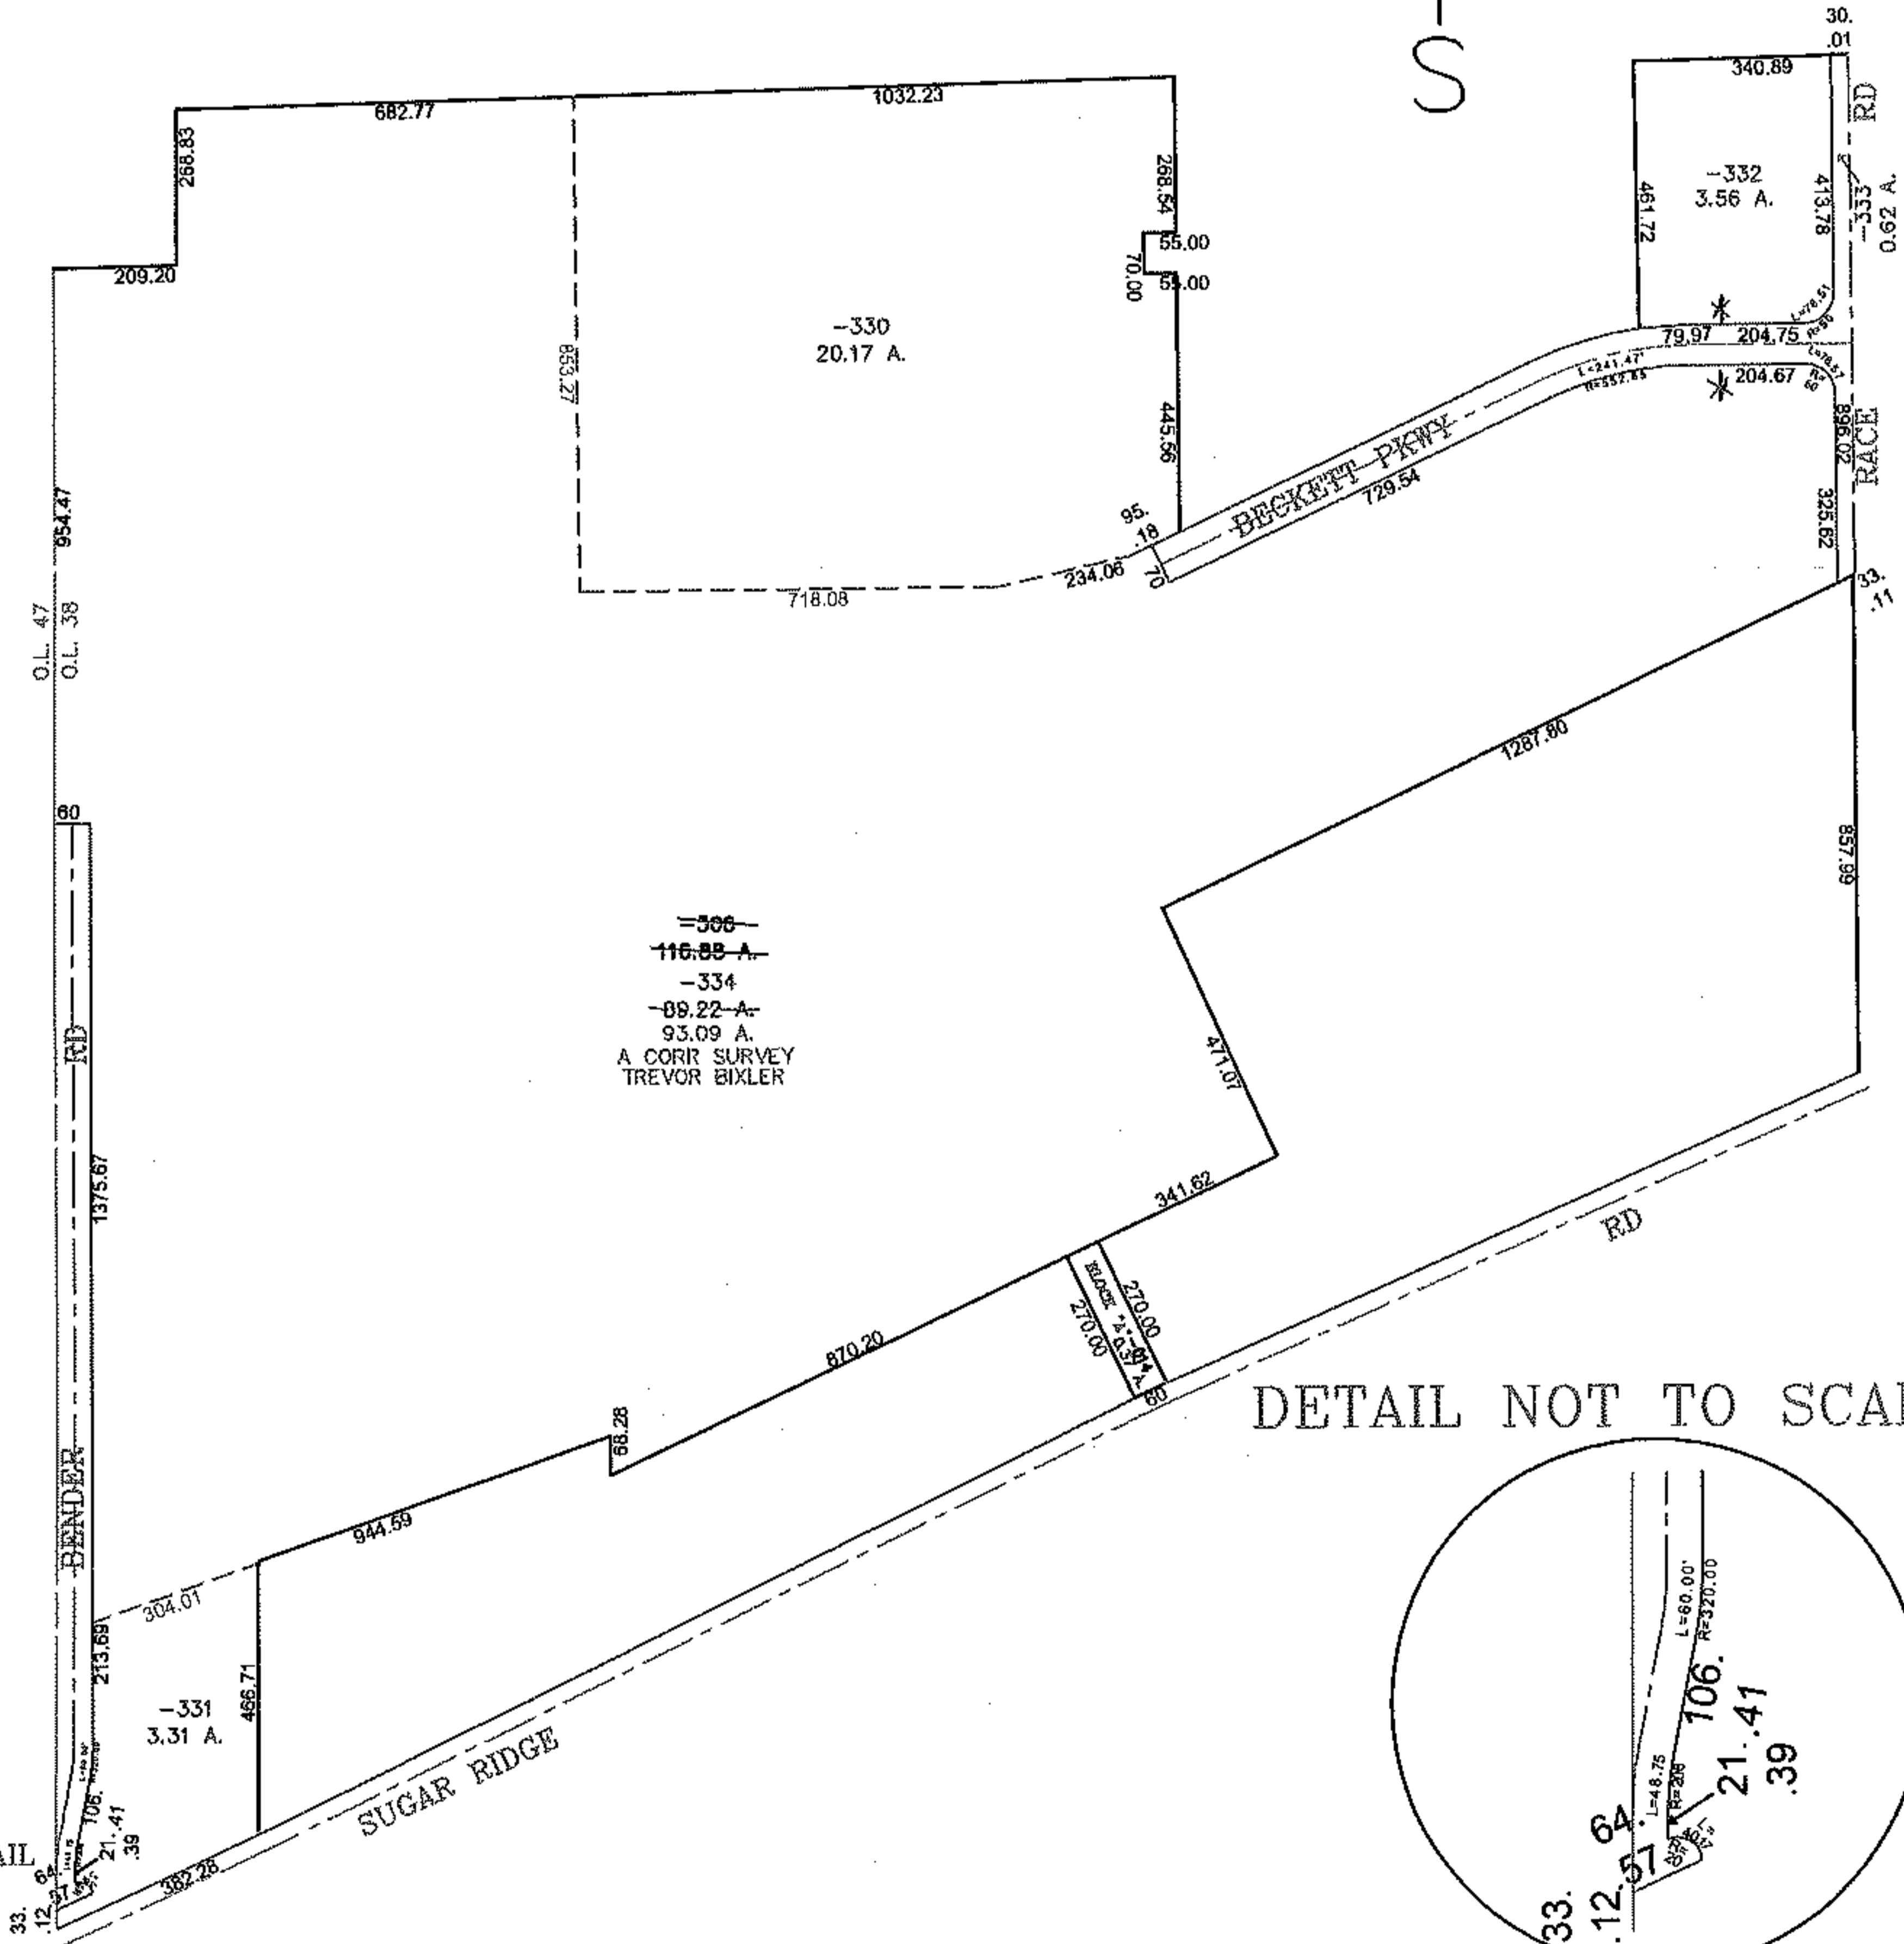


PARENT PARCEL: 07-00-038-000-306, -014

CHILD PARCEL: 07-00-0368-000-330 THRU -334

12-03016

STARTING POINT: CENTERLINE OF SUGAR RIDGE RD & RACE RD

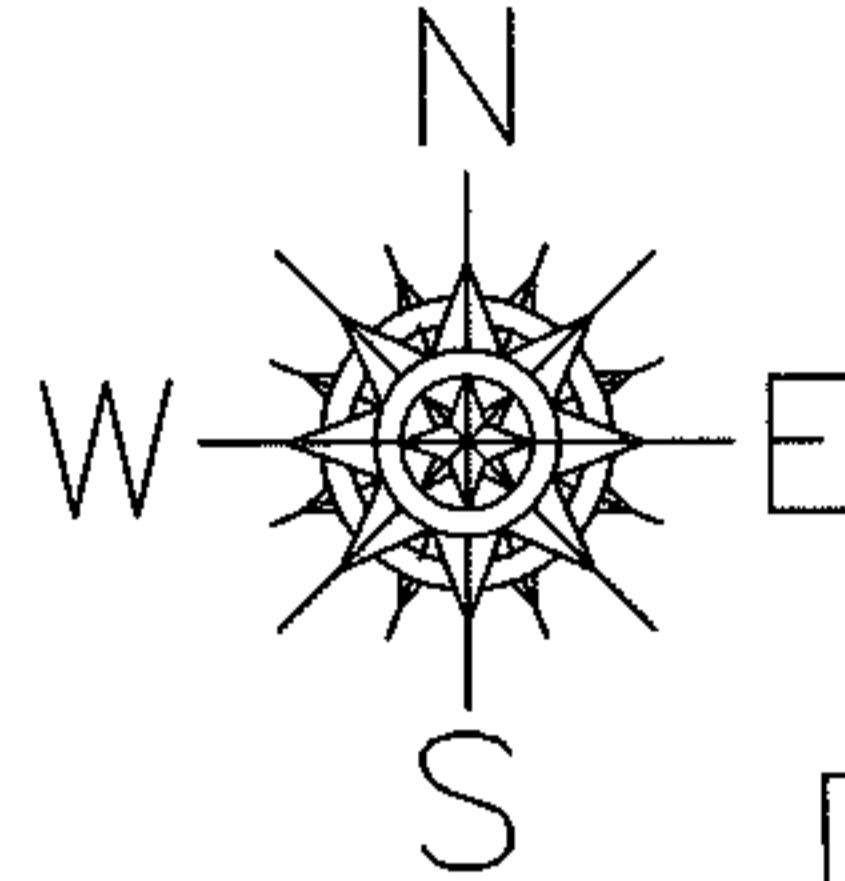

**SPLITS/DEEDS PROCESSED**

LORAIN COUNTY TAX MAP DEPARTMENT  
226 MIDDLE AVE. ELYRIA, OHIO

SURVEYED BY: TREVOR BIXLER  
 CLOSURE: 0.00 : 10.000  
 MAP PAGE(S): 07-00-038-B  
 APPROVED BY: JAH DATE: 4/23/2012  
 SCALE: 1" = 500 PRIOR INSTRUMENT: 19980524293