
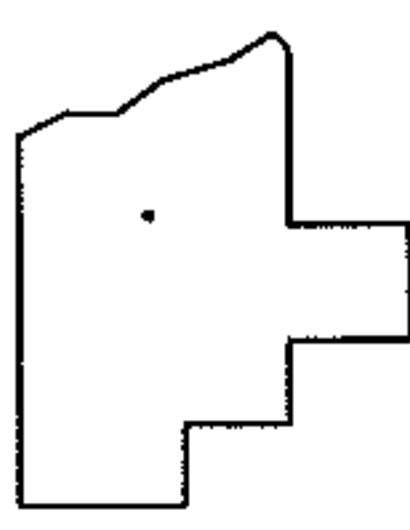
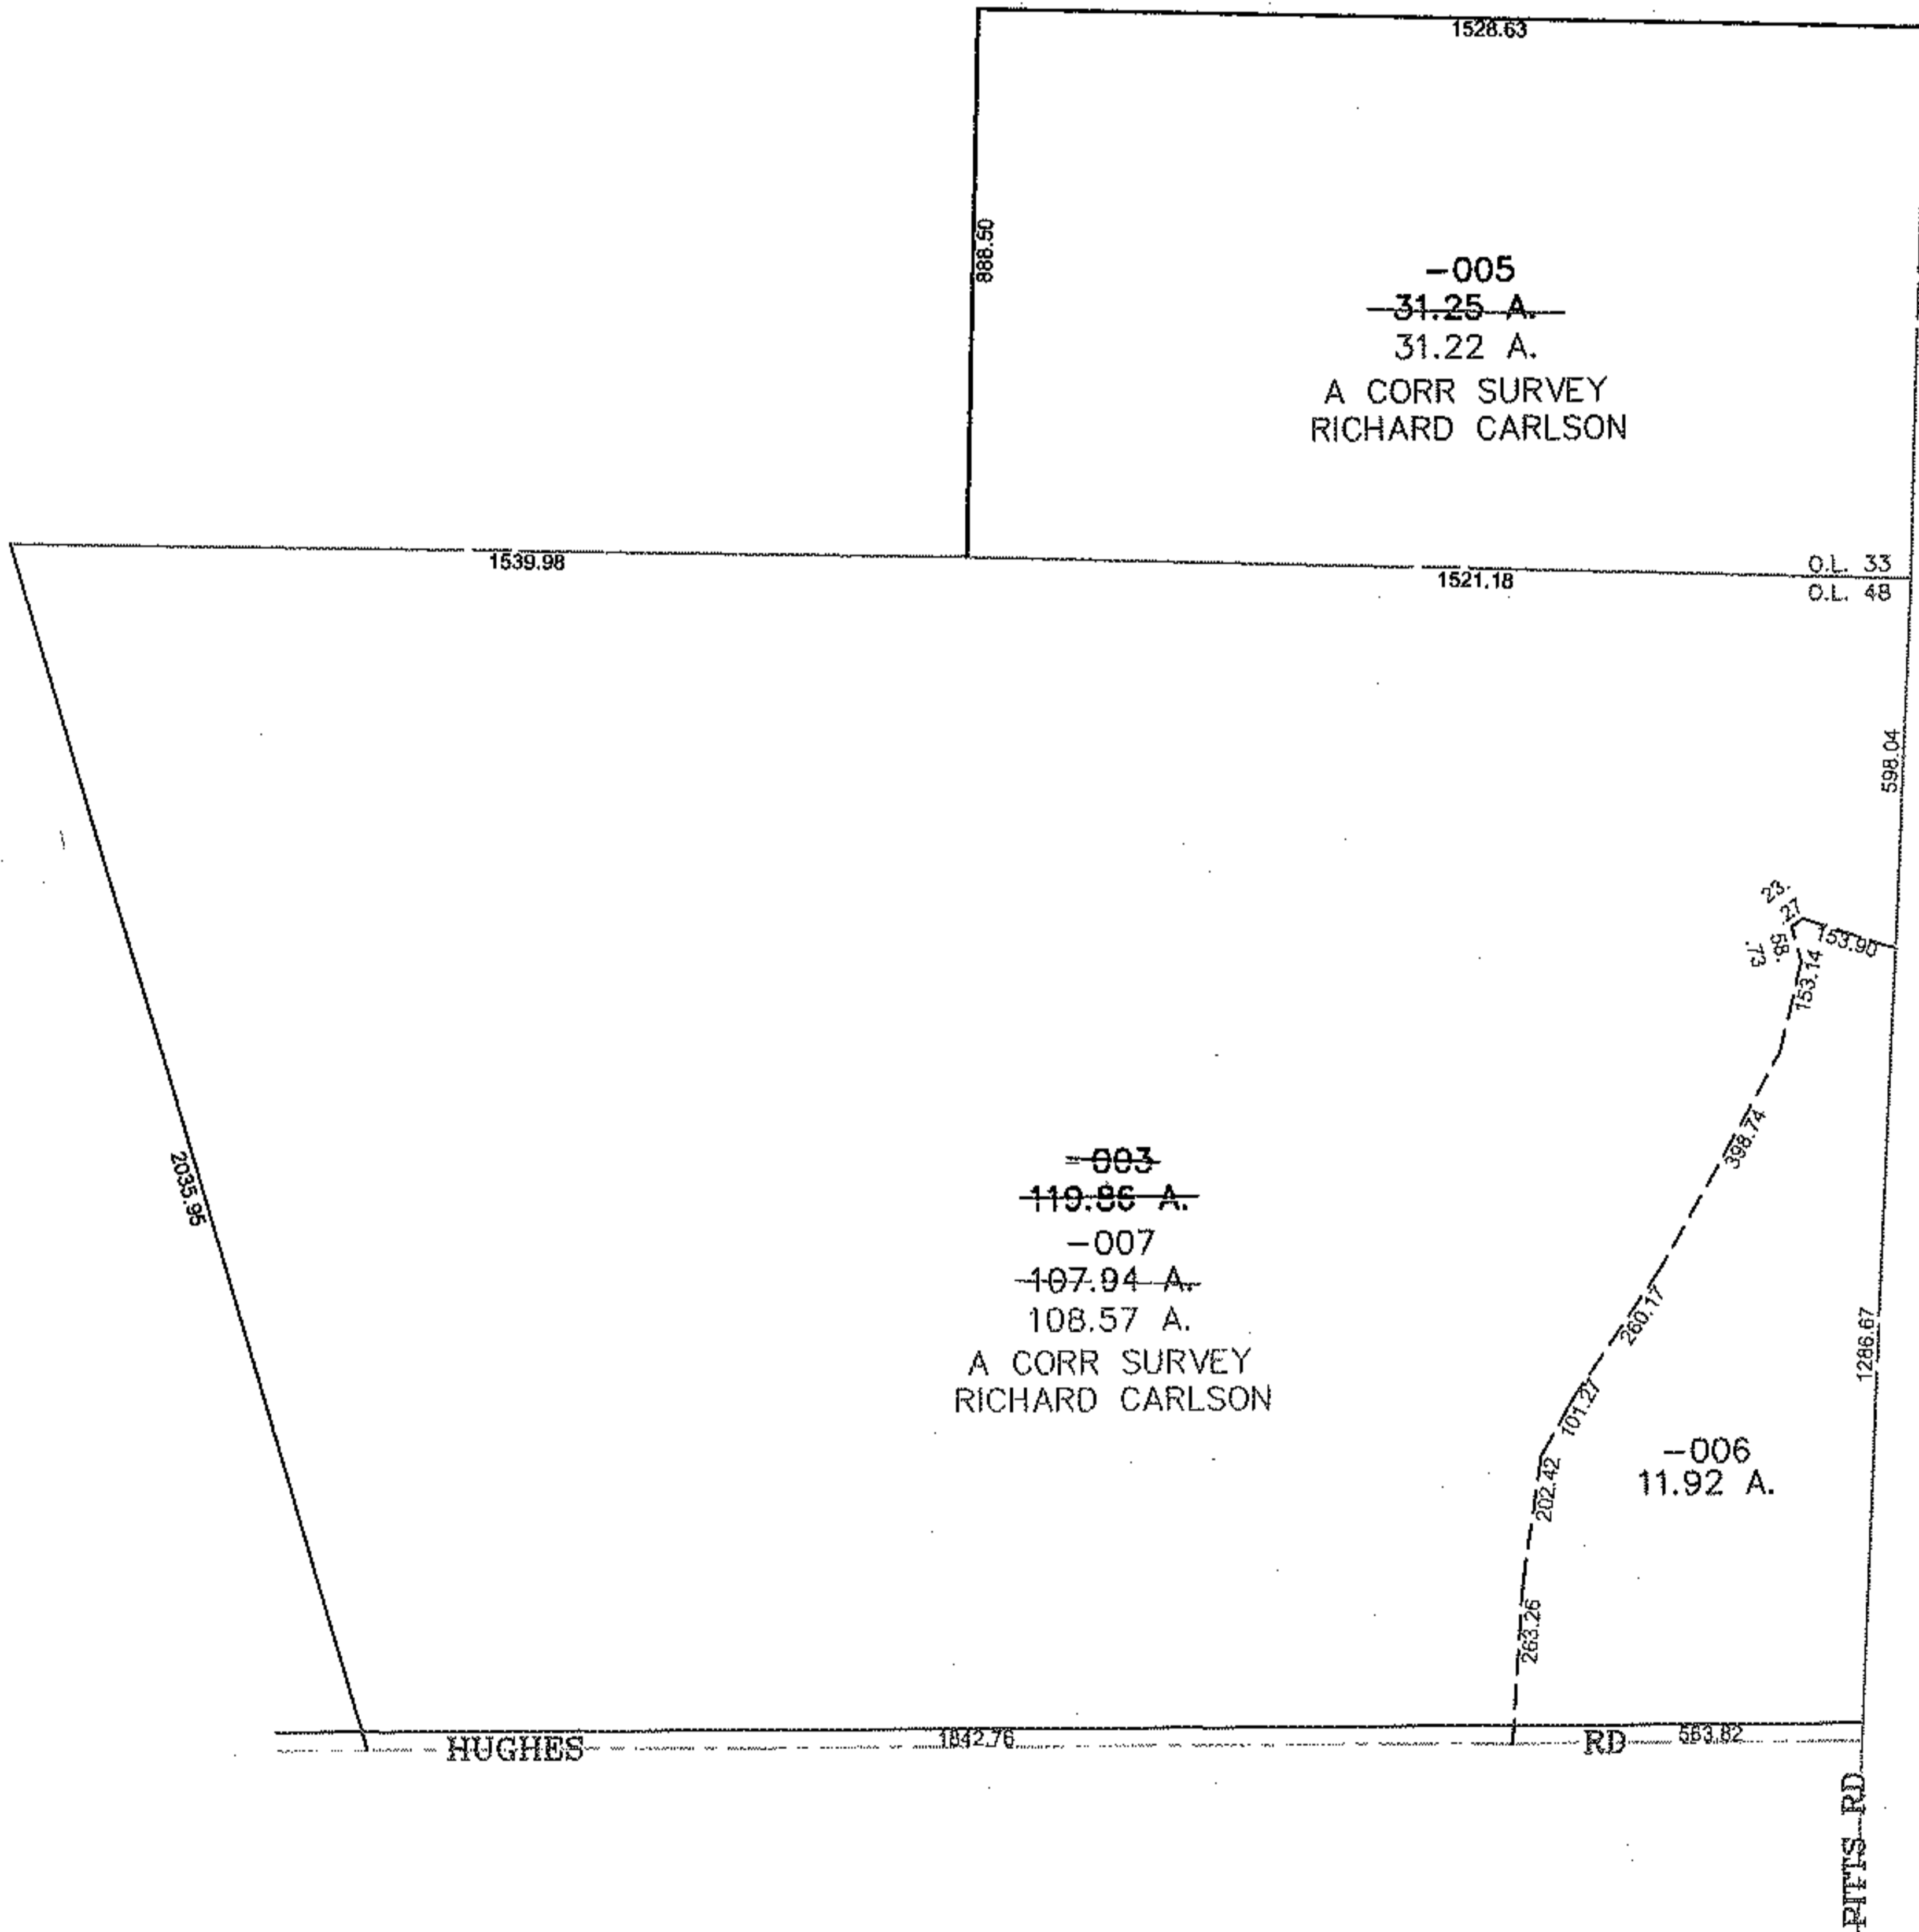


PARENT PARCEL: 14-00-048-000-003, 14-00-033-000-005

CHILD PARCEL: 14-00-048-000-006, -007

STARTING POINT: CENTERLINE OF HUGHES RD & PITTS RD

12-03018

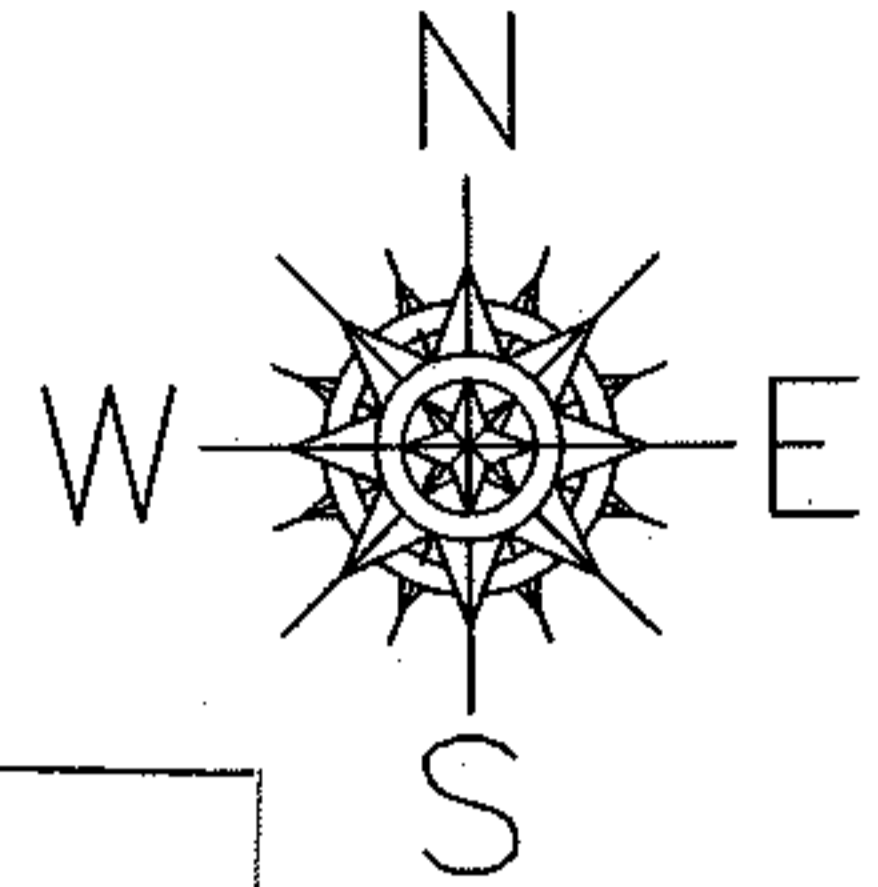

**SPLITS/DEEDS PROCESSED**

LORAIN COUNTY TAX MAP DEPARTMENT  
226 MIDDLE AVE. ELYRIA, OHIO

SURVEYED BY: RICHARD CARLSON

CLOSURE: 0.00 : 10.000

MAP PAGE(S): 14-B

APPROVED BY: JAH DATE: 4/28/2012

SCALE: 1" = 500 PRIOR INSTRUMENT: 19990624753